

THE HERCULES C. & S.M. CO^Y. N.L.


MOUNT READ, TASMANIA

SCALE

Twenty five feet to an inch.

Sheet No 4

CROSS SECTION A.A.

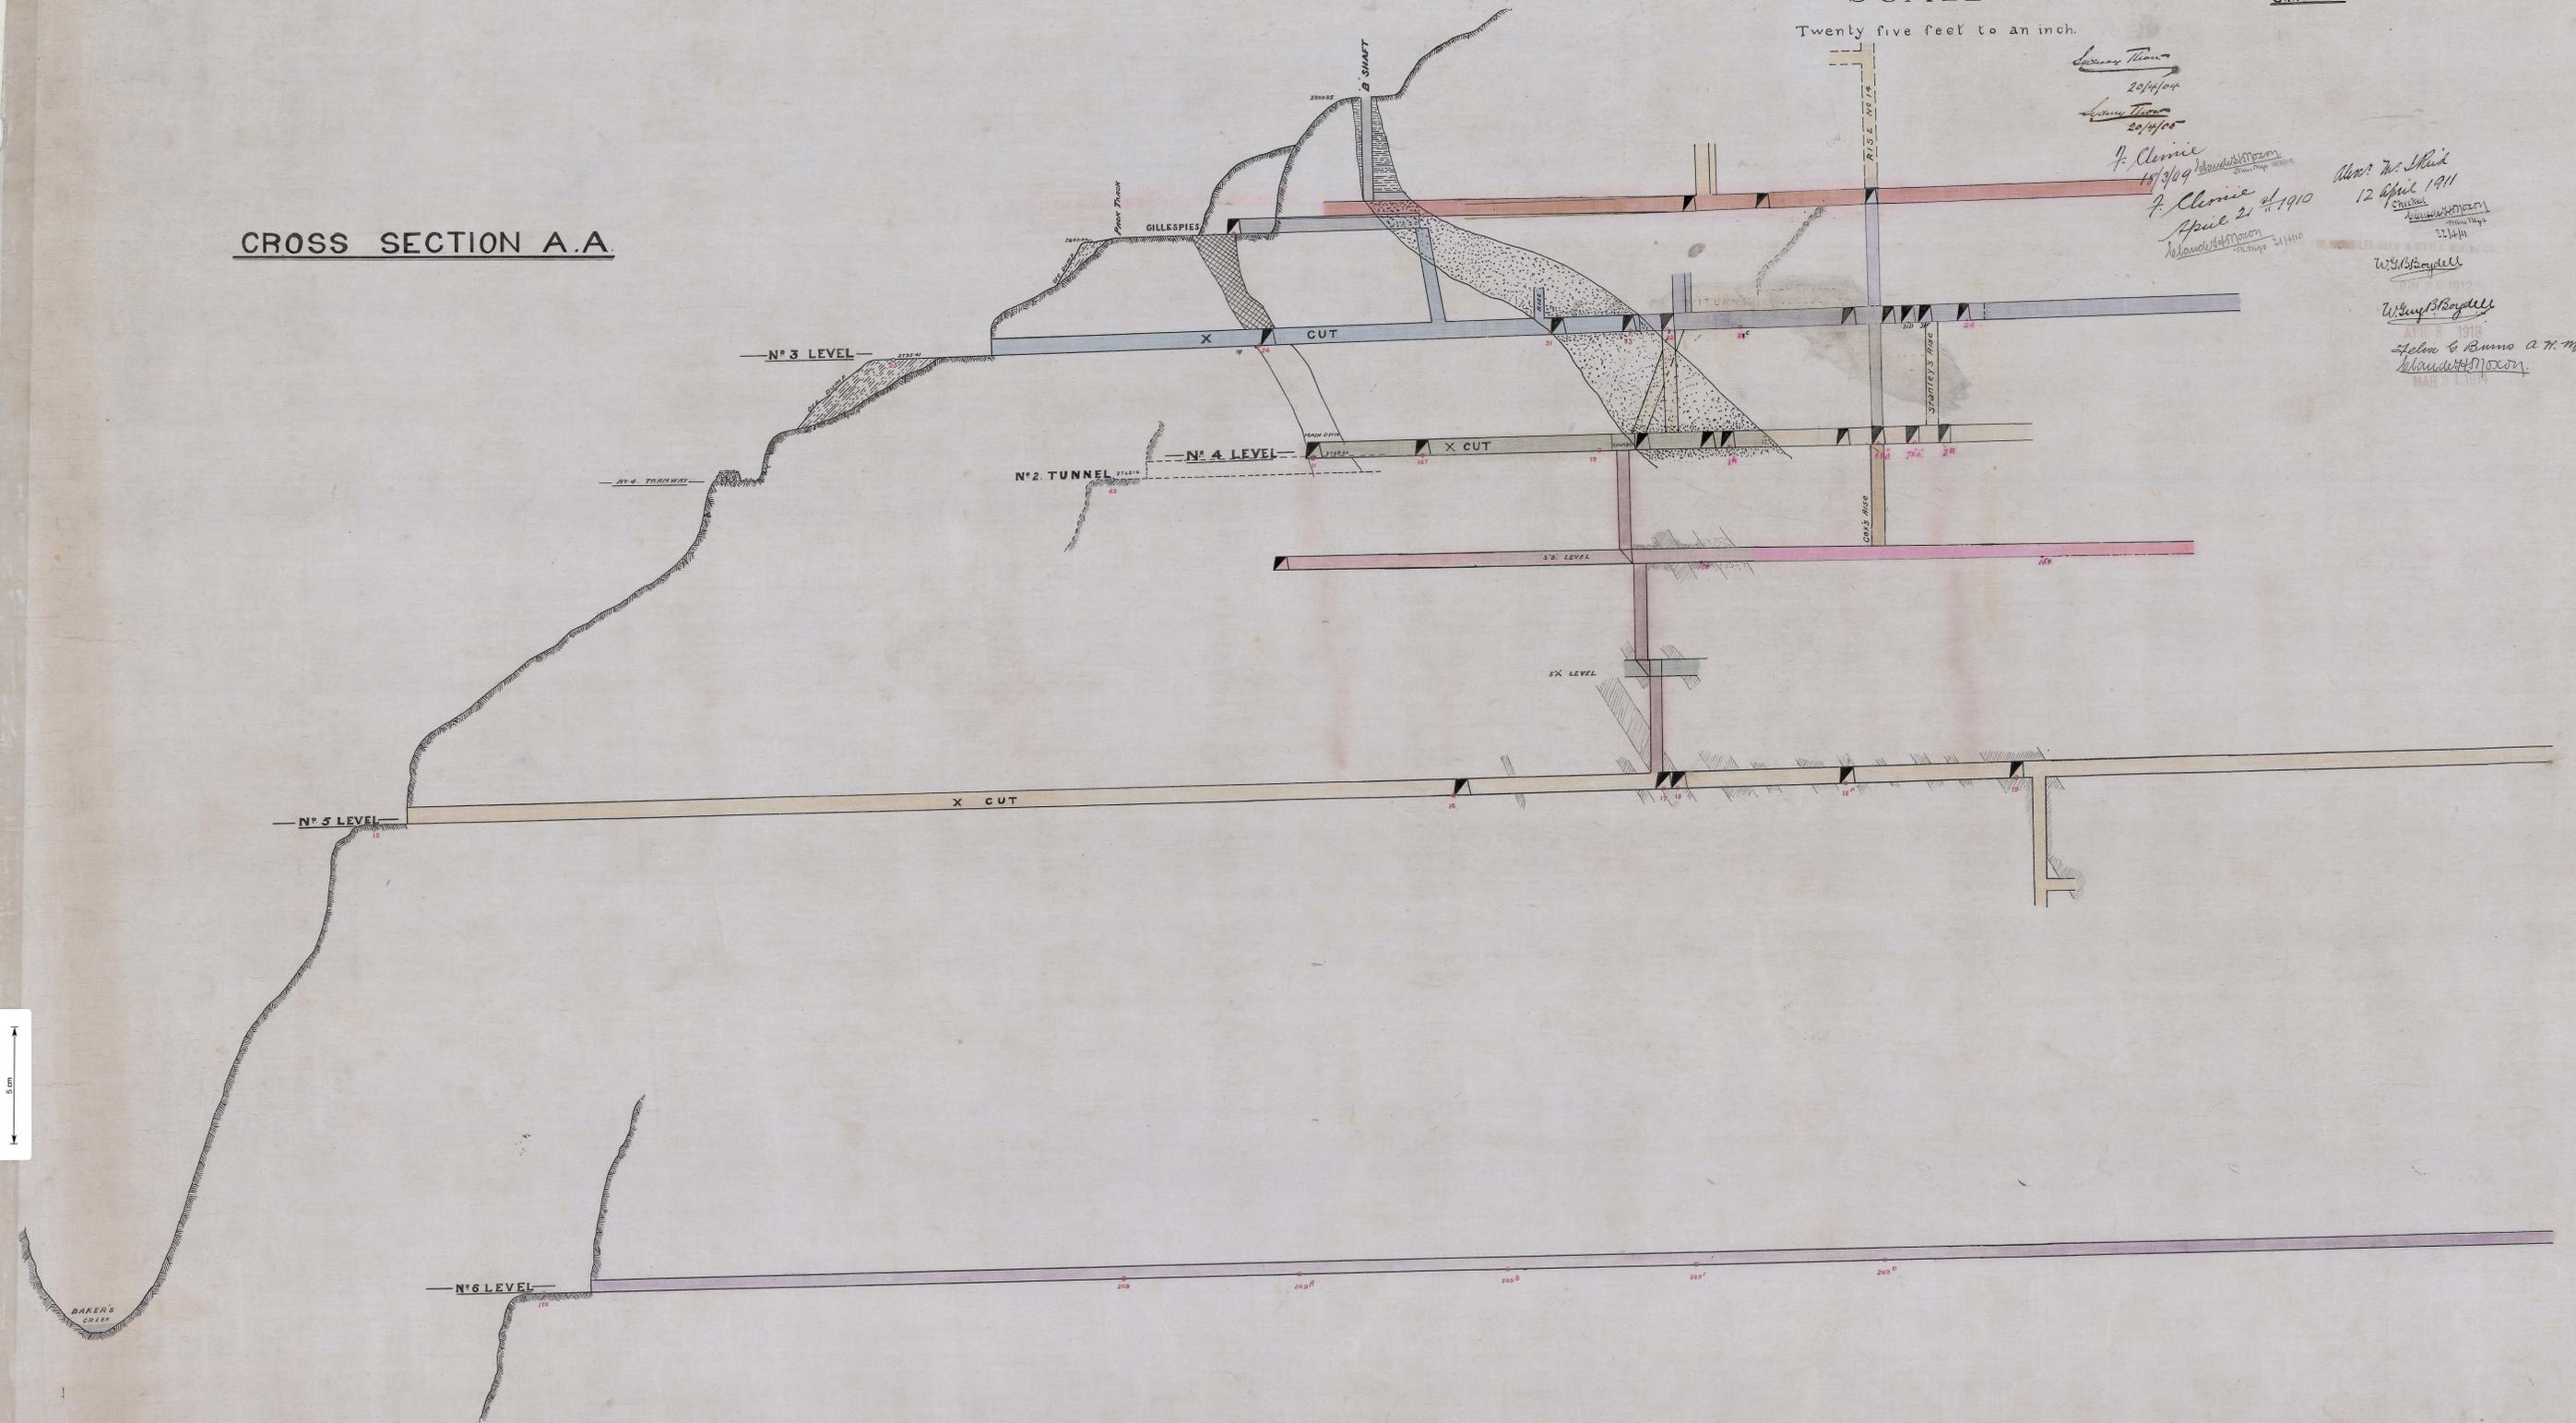

J. Clinie
18/3/09
J. Clinie
21/4/10
W. Bayly
12 April 1911
Helen & Burns
a. n. m. b. m.
MAY 1 1911

50m