HERCULES G&S.M.CO.N.L.

PLAN AND SECTIONS

SHOWING RELATION OF BORE-HOLES

SCALE 1in = 25ft

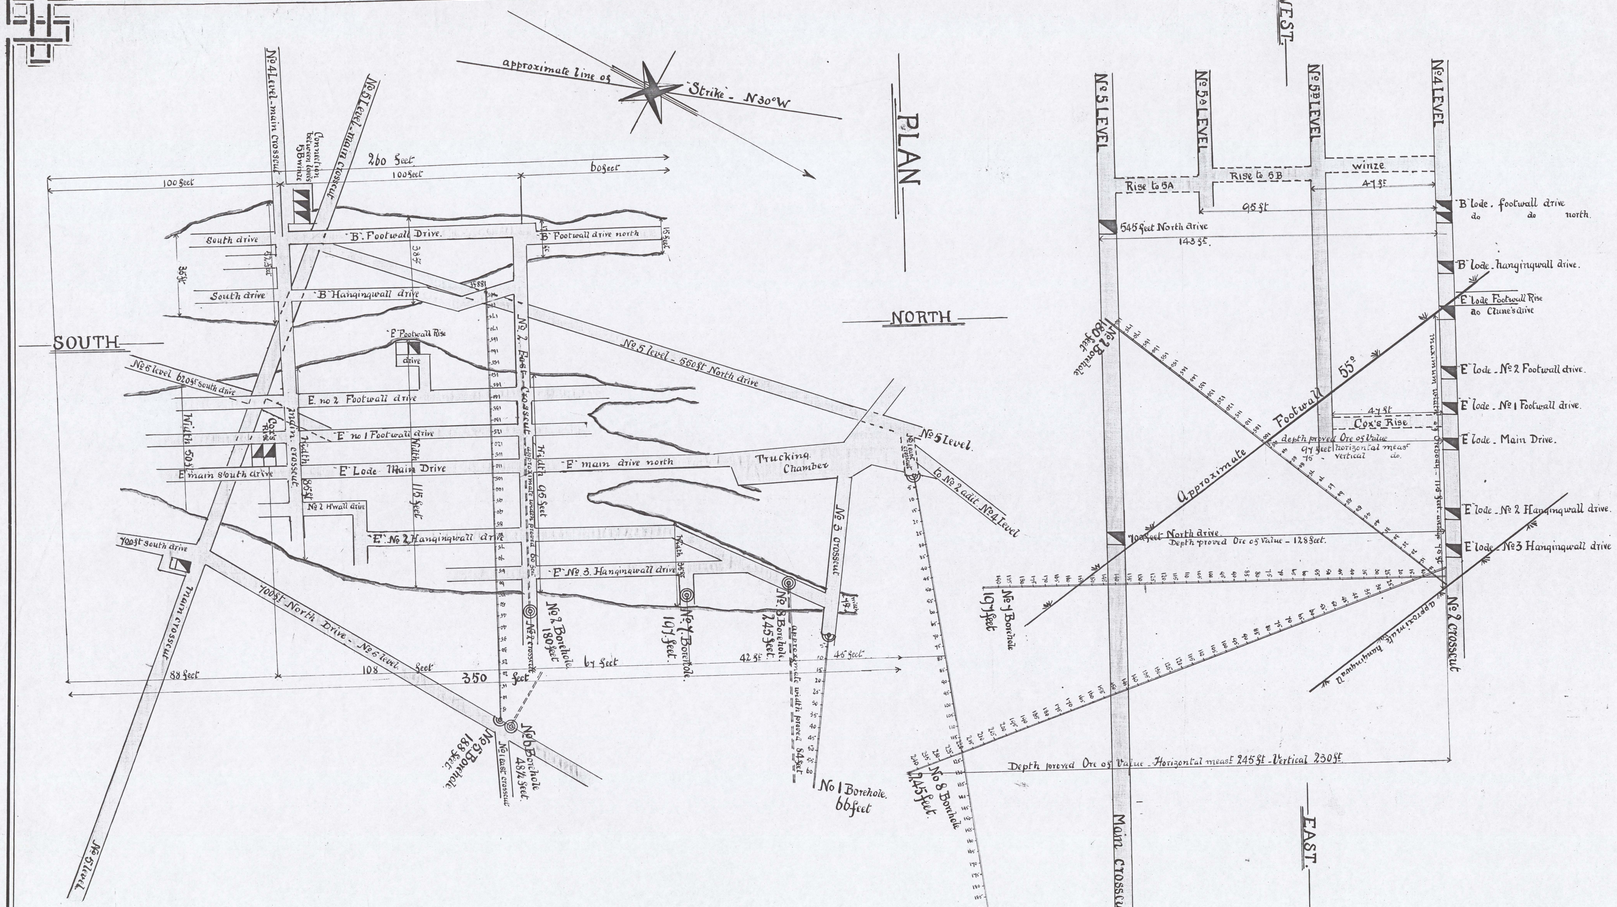

CROSS SECTION.

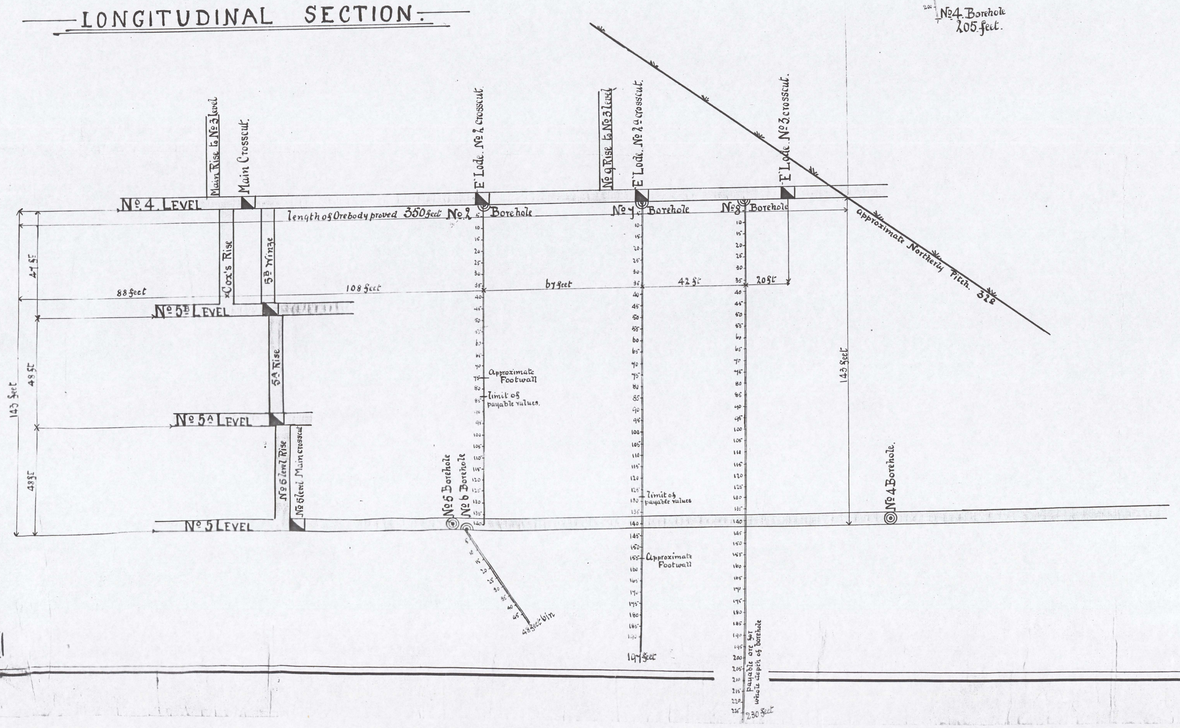

IDEAL SECTIONS

shewing

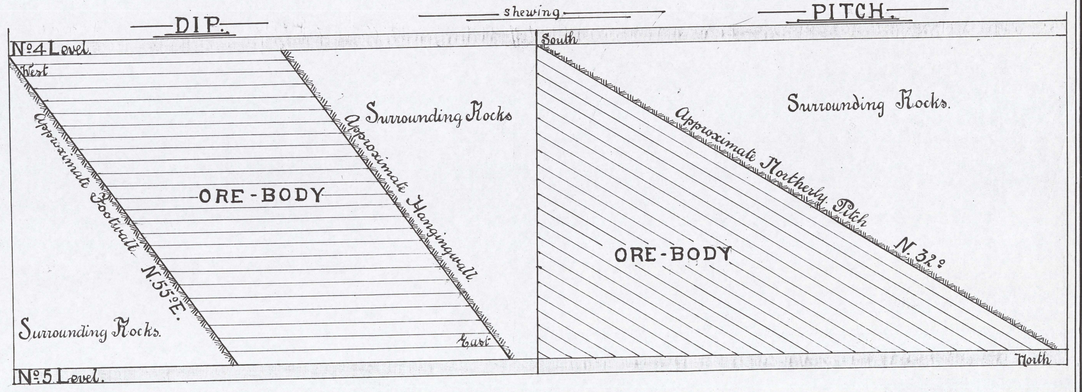

19

0313-015