PLAN OF WORKINGS

OF

THE NEW PINAFORE G.M.Co

AT December 31st 1913

Scale 40 Feet to 1 Inch

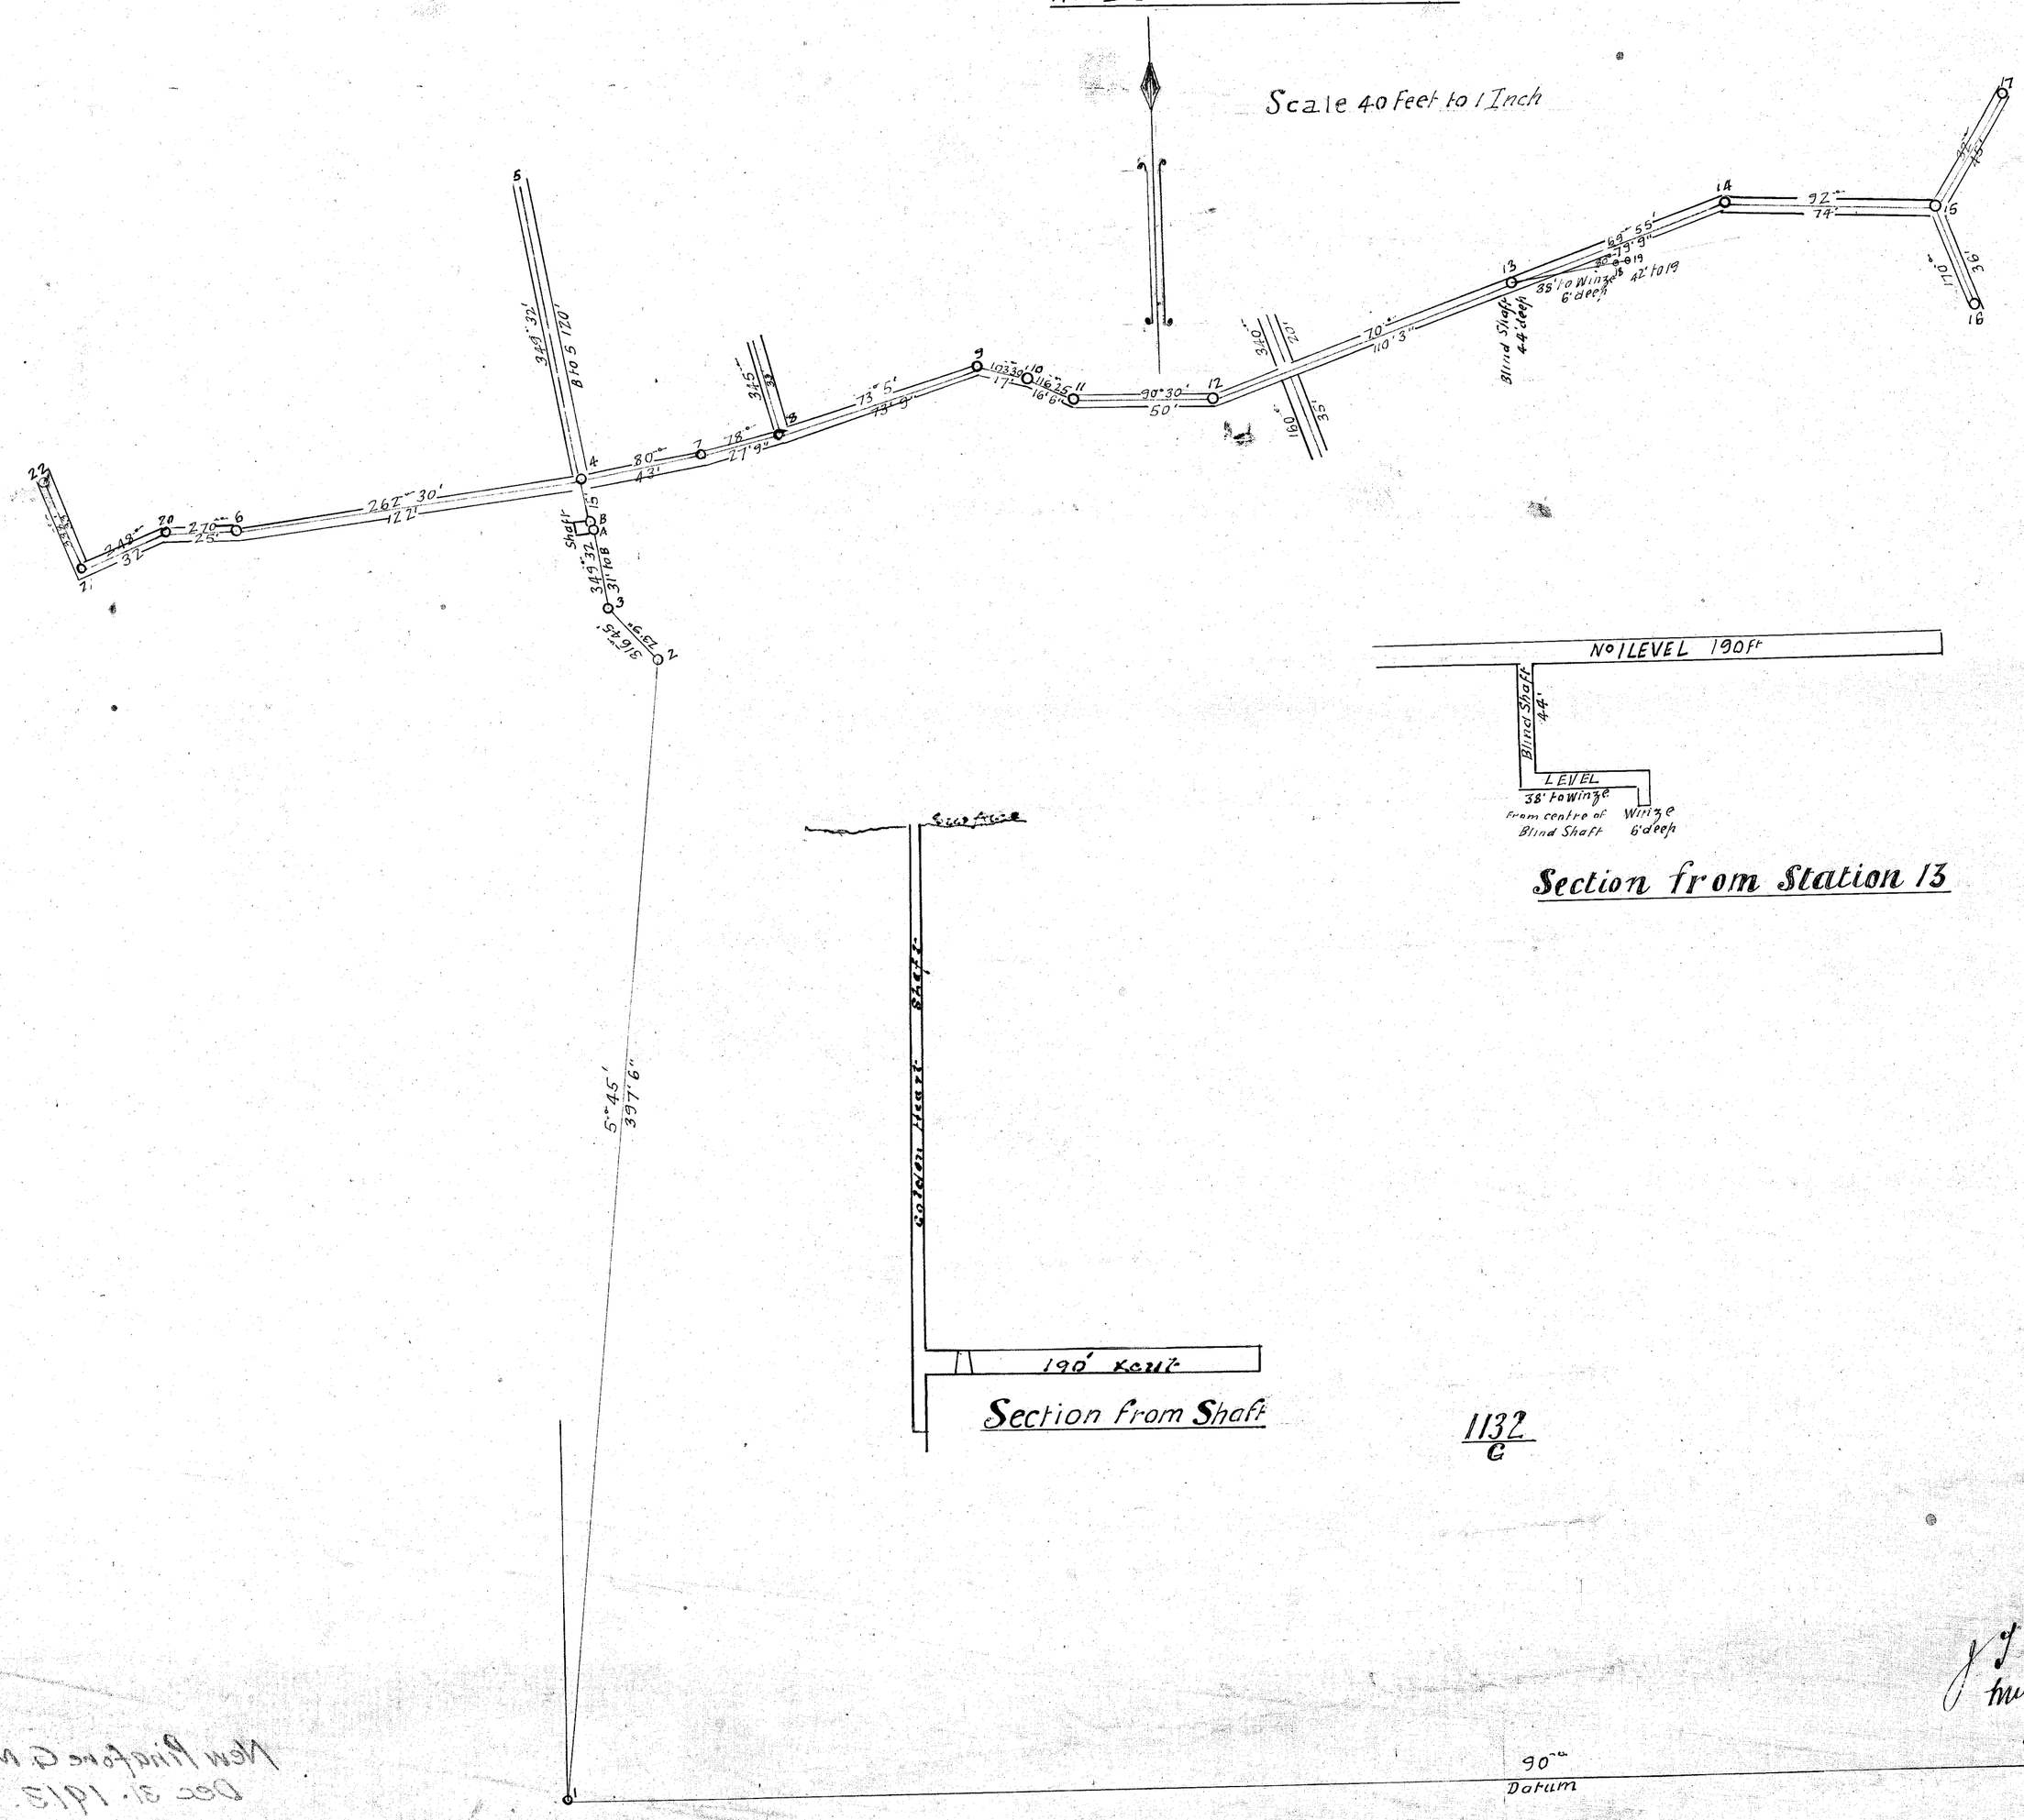

1132
G

J J Stubs
Mine Manager
25/3/14

New Pinafore G.M.
Dec 31. 1913