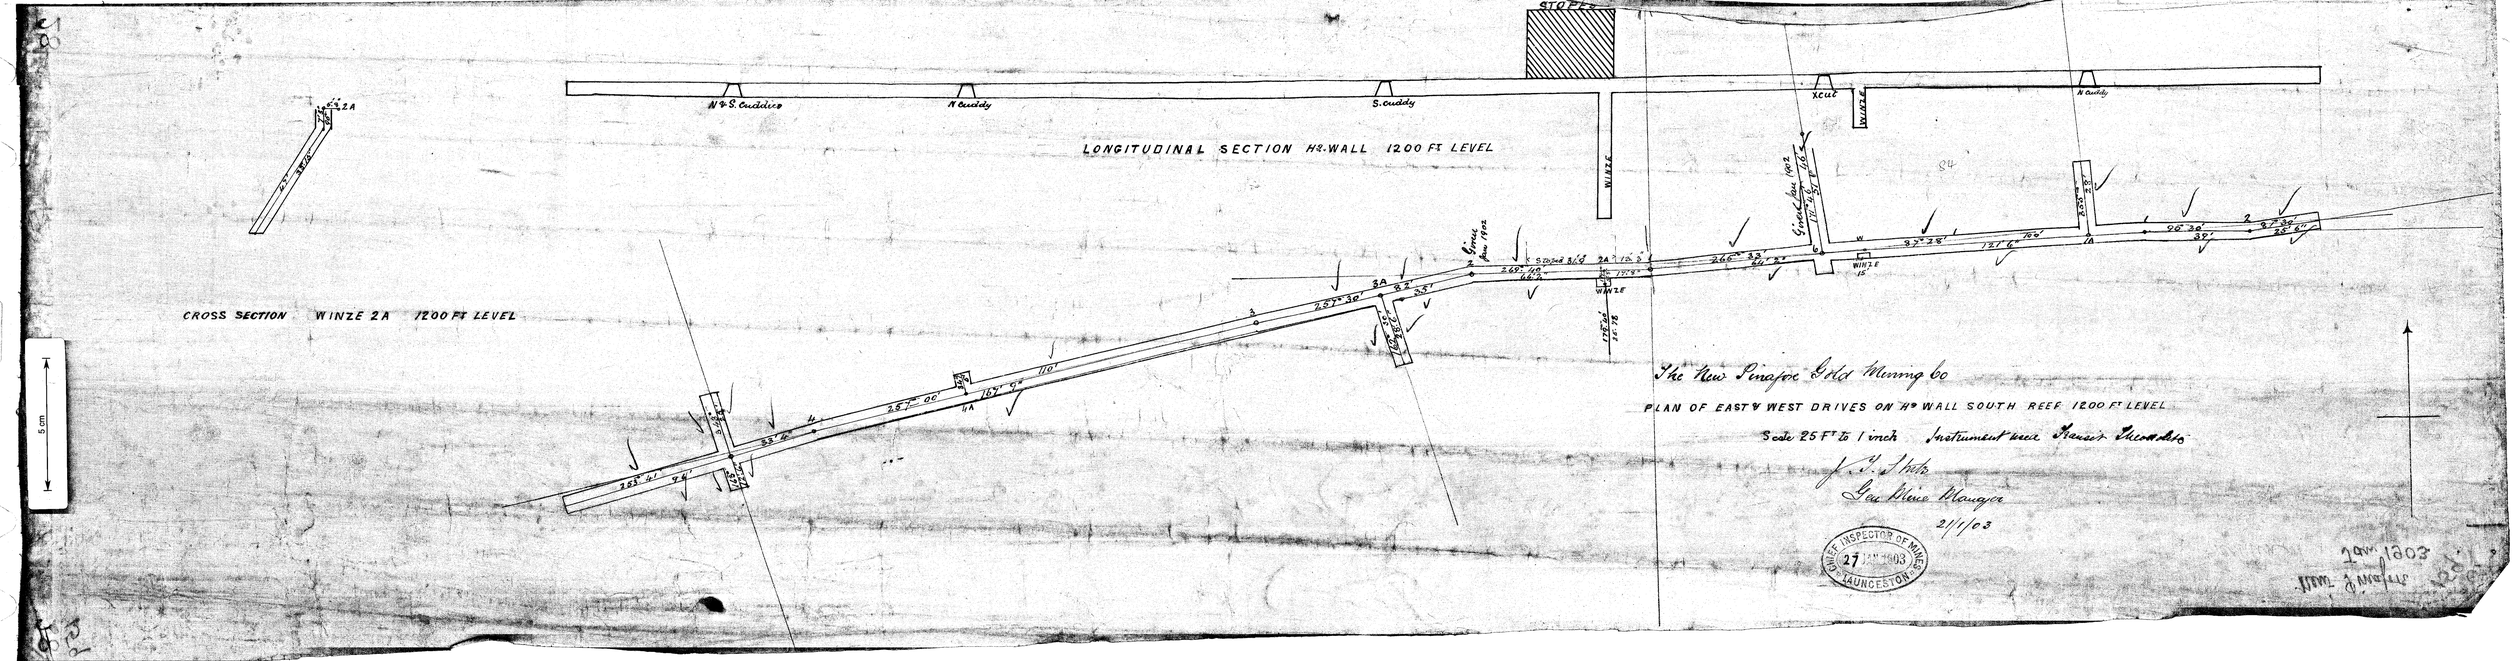
LONGITUDINAL SECTION Hg. WALL 1200 Ft LEVEL
CROSS SECTION WINZE 2A 1200 Ft LEVEL
STOPES
N & S. Cuddies
N Cuddy
S. Cuddy
Xcut
WINZE
5 cm
The New Pinafore Gold Mining Co
PLAN OF EAST & WEST DRIVES ON Hg WALL SOUTH REEF 1200 Ft LEVEL
Scale 25 Ft to 1 inch Instrument used Fraser Theodolite
J. G. Stott
Gen Mine Manager
21/1/03
MINES INSPECTOR OF MINES
27 JAN 1903
LAUNCESTON
21st 1903
Wm. J. McKelle