NEW PINAFORE G.M.

LONGITUDINAL SECTION

Scale 25 Feet to an Inch

Levels 1 & 2 Central shaft and 3, 4, 5 Main shaft managed by me. The measurements corrected. Peter Leslie 19/5/94 & 23/10/94

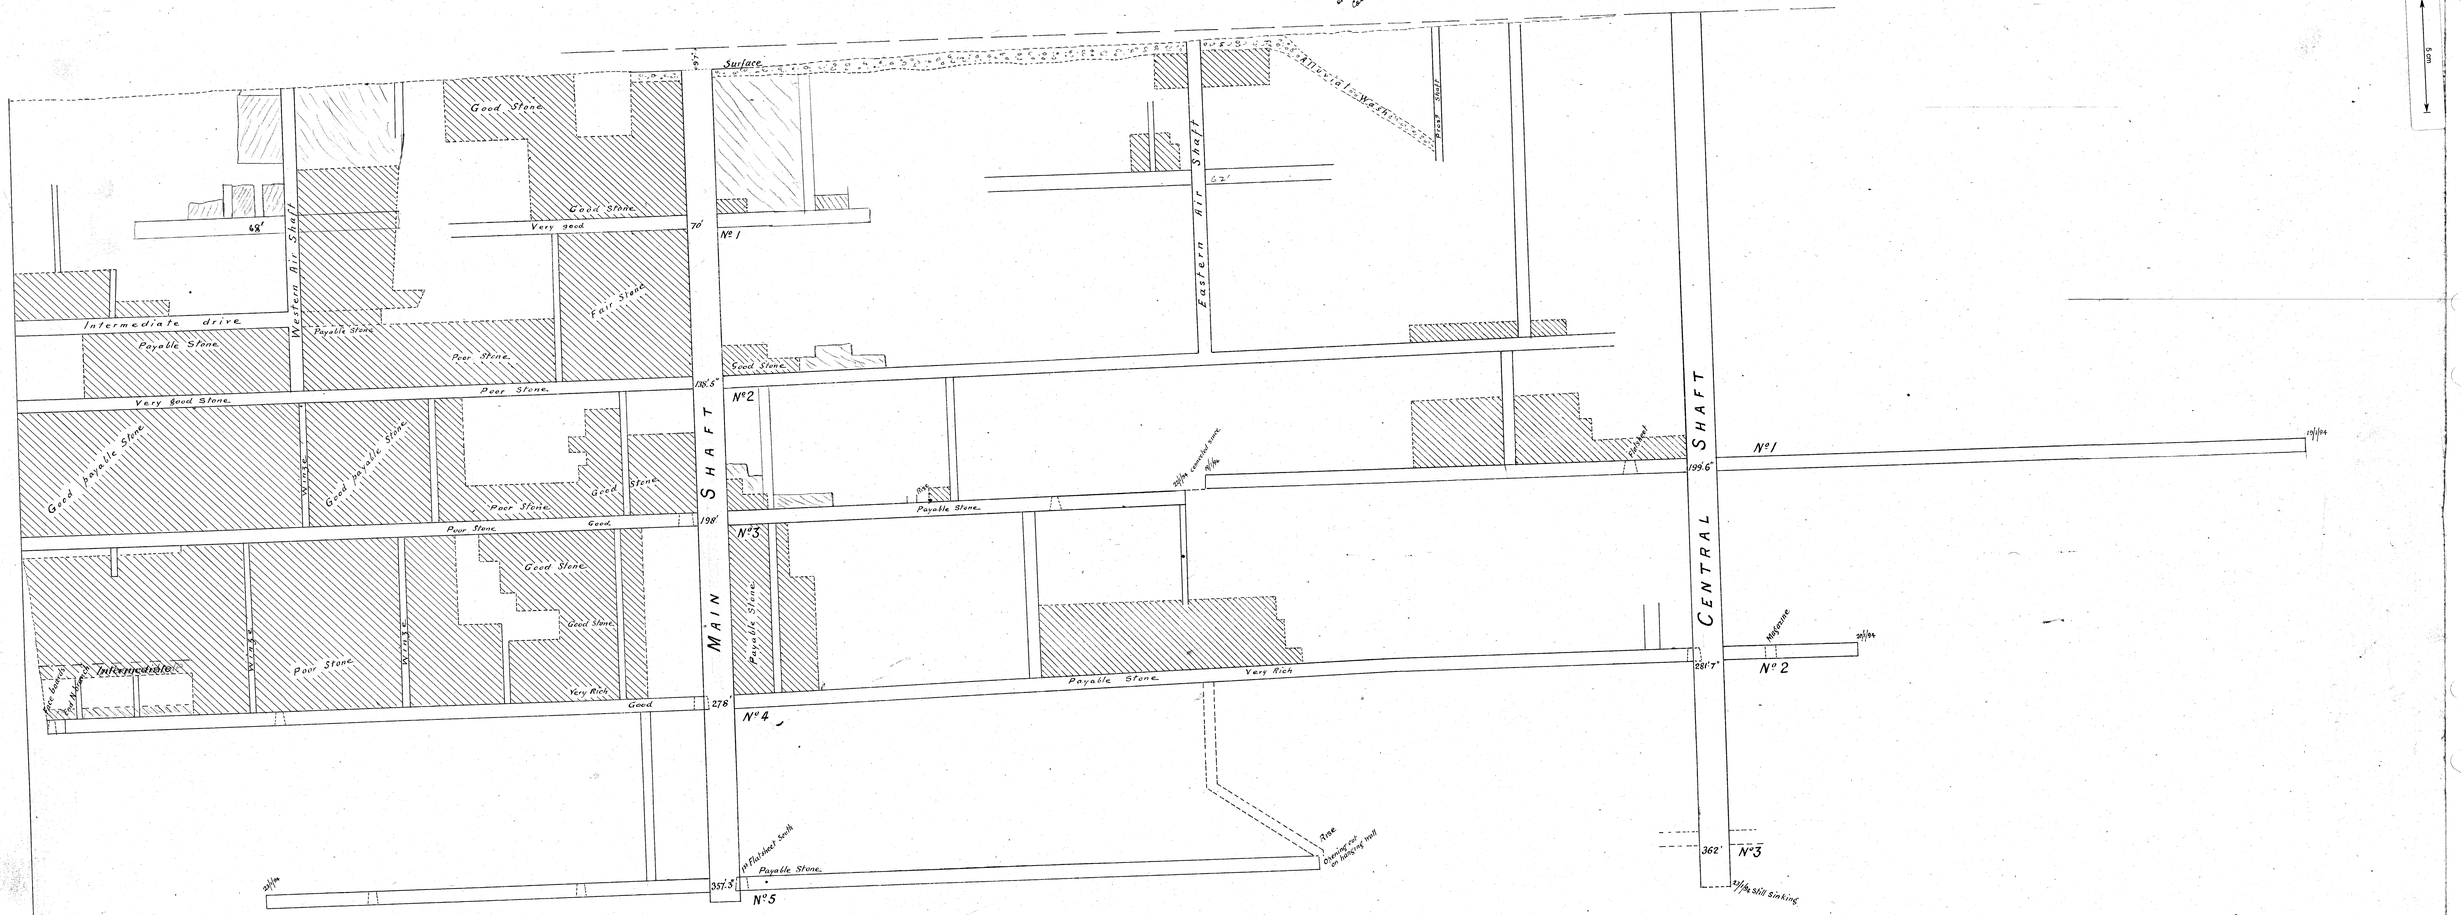
Surface
Pump Shaft
Eastern Air Shaft
Western Air Shaft
MAIN SHAFT
CENTRAL SHAFT
Good Stone
Very good
Fair Stone
Intermediate drive
Payable Stone
Poor Stone
Very Good Stone
Good Payable Stone
Good
Very Rich
Intermediate
Rise
Nº 1
Nº 2
Nº 3
Nº 4
Nº 5
68'
70'
198'
278'
357.5'
62'
199.6'
281.7'
362'
Nº 1 Flat dipping south
Rise
Opening out on hanging wall
Nº 1 Sill sinking
