
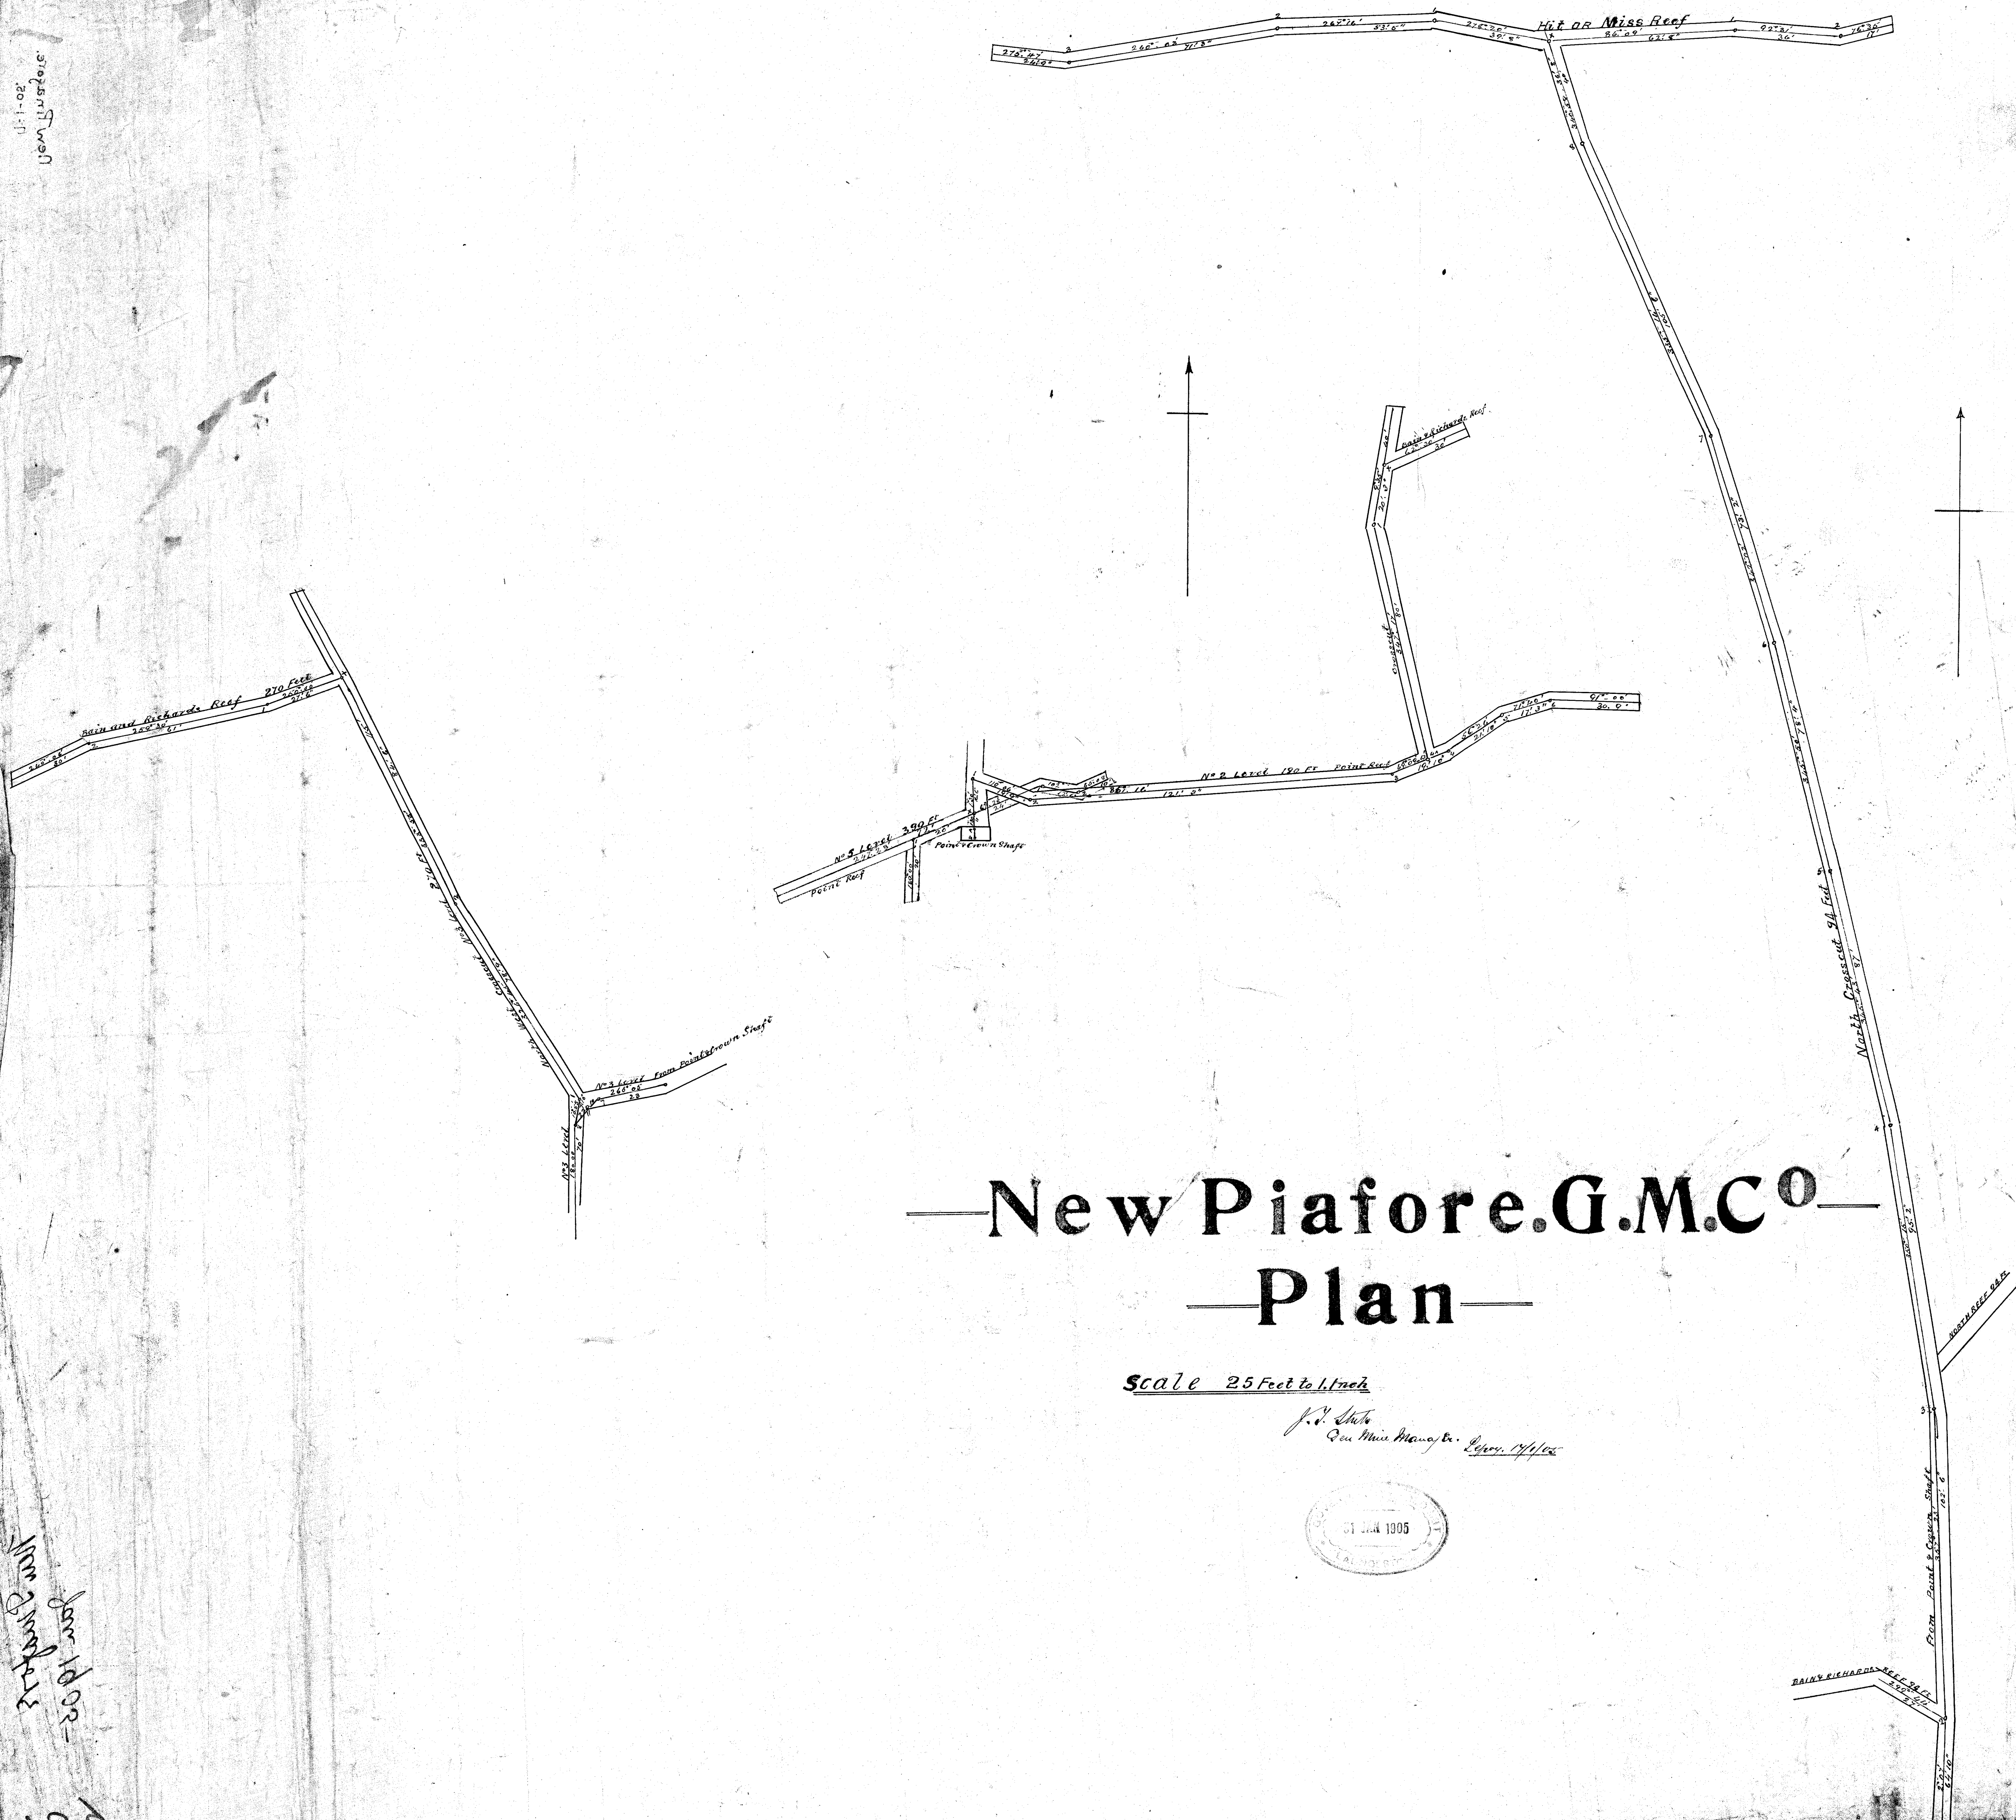


20-1-77  

Jan 16 02 -  

12d

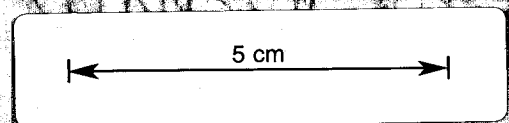

—New Piafore.G.M.C<sup>o</sup>—  
—Plan—

Scale 25 Feet to 1. inch

J. V. Stuts  
Gen. Mgr. M. & E. Depoy. 17/1/02

