NEW PINAFORE G.M. Co NO L.A

LONGITUDINAL SECTION

EASTERN BLOCK

Scale 25 feet to an inch

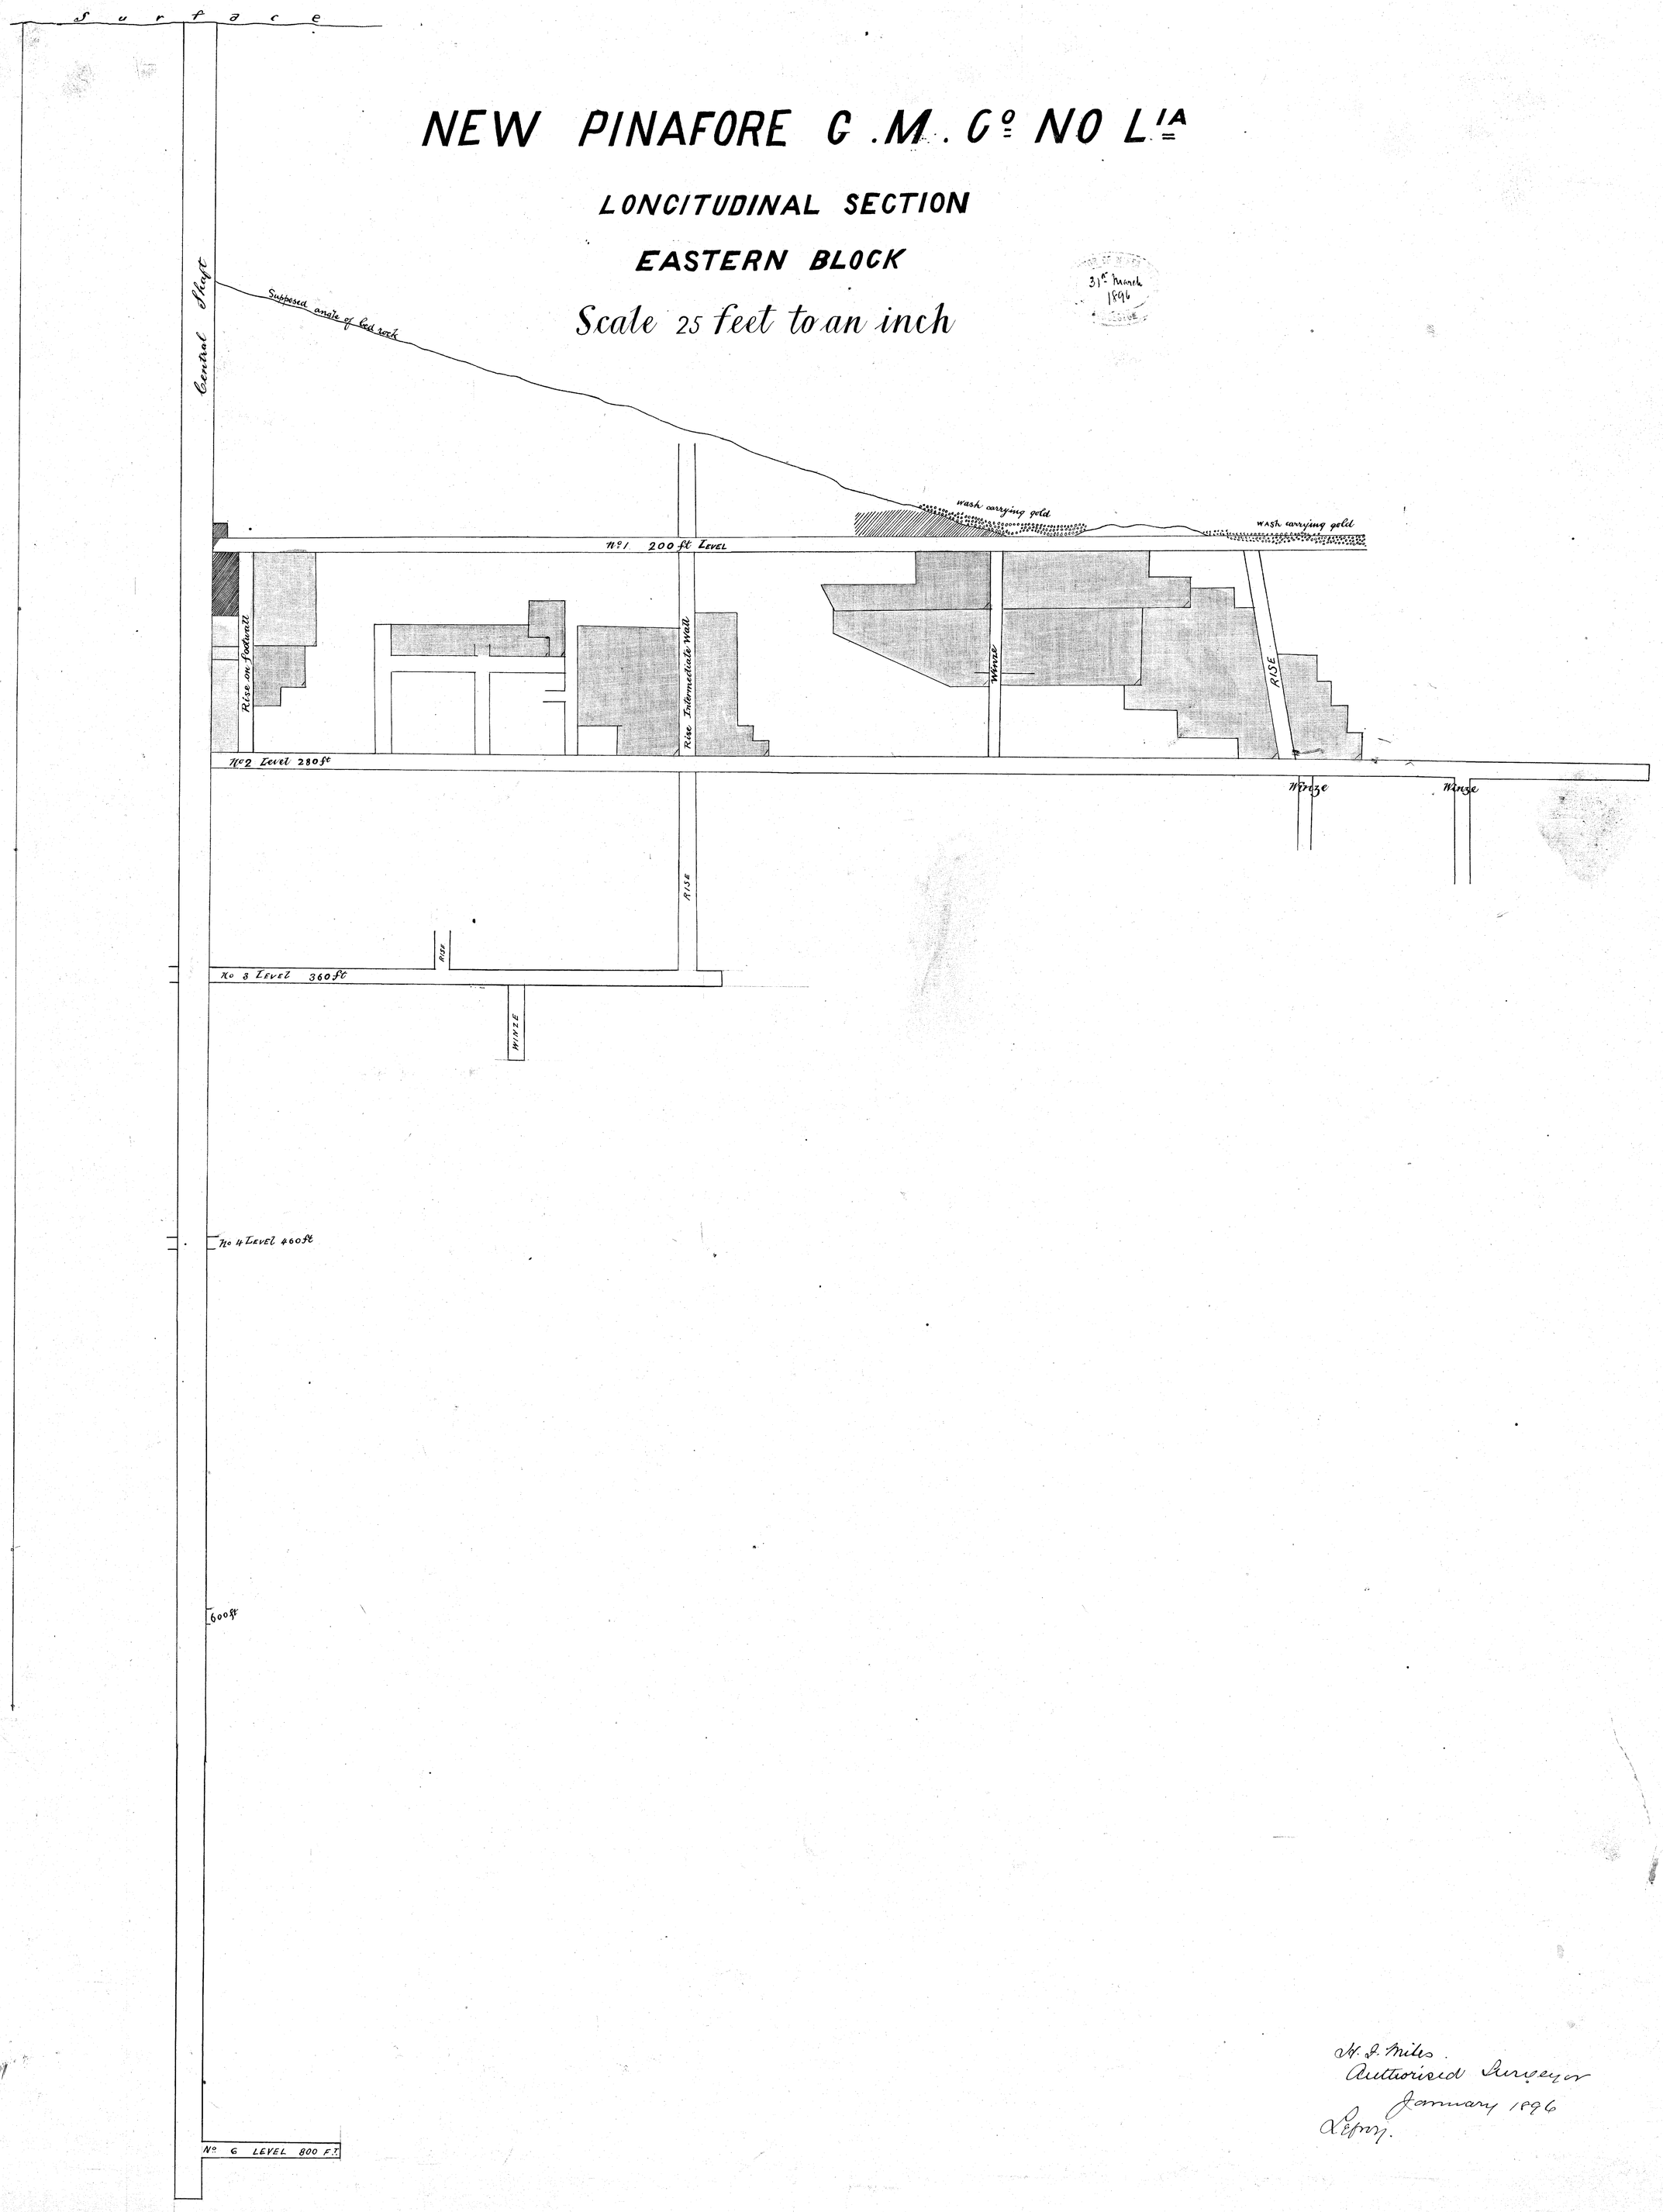

H. J. Miles.
Authorised Surveyor
January 1896
Lease.

58