

85

5 cm

314
29



85

New Pinafore G.M. Co NO Lia

Transverse Section

Central Shaft

Scale 25 feet to an inch

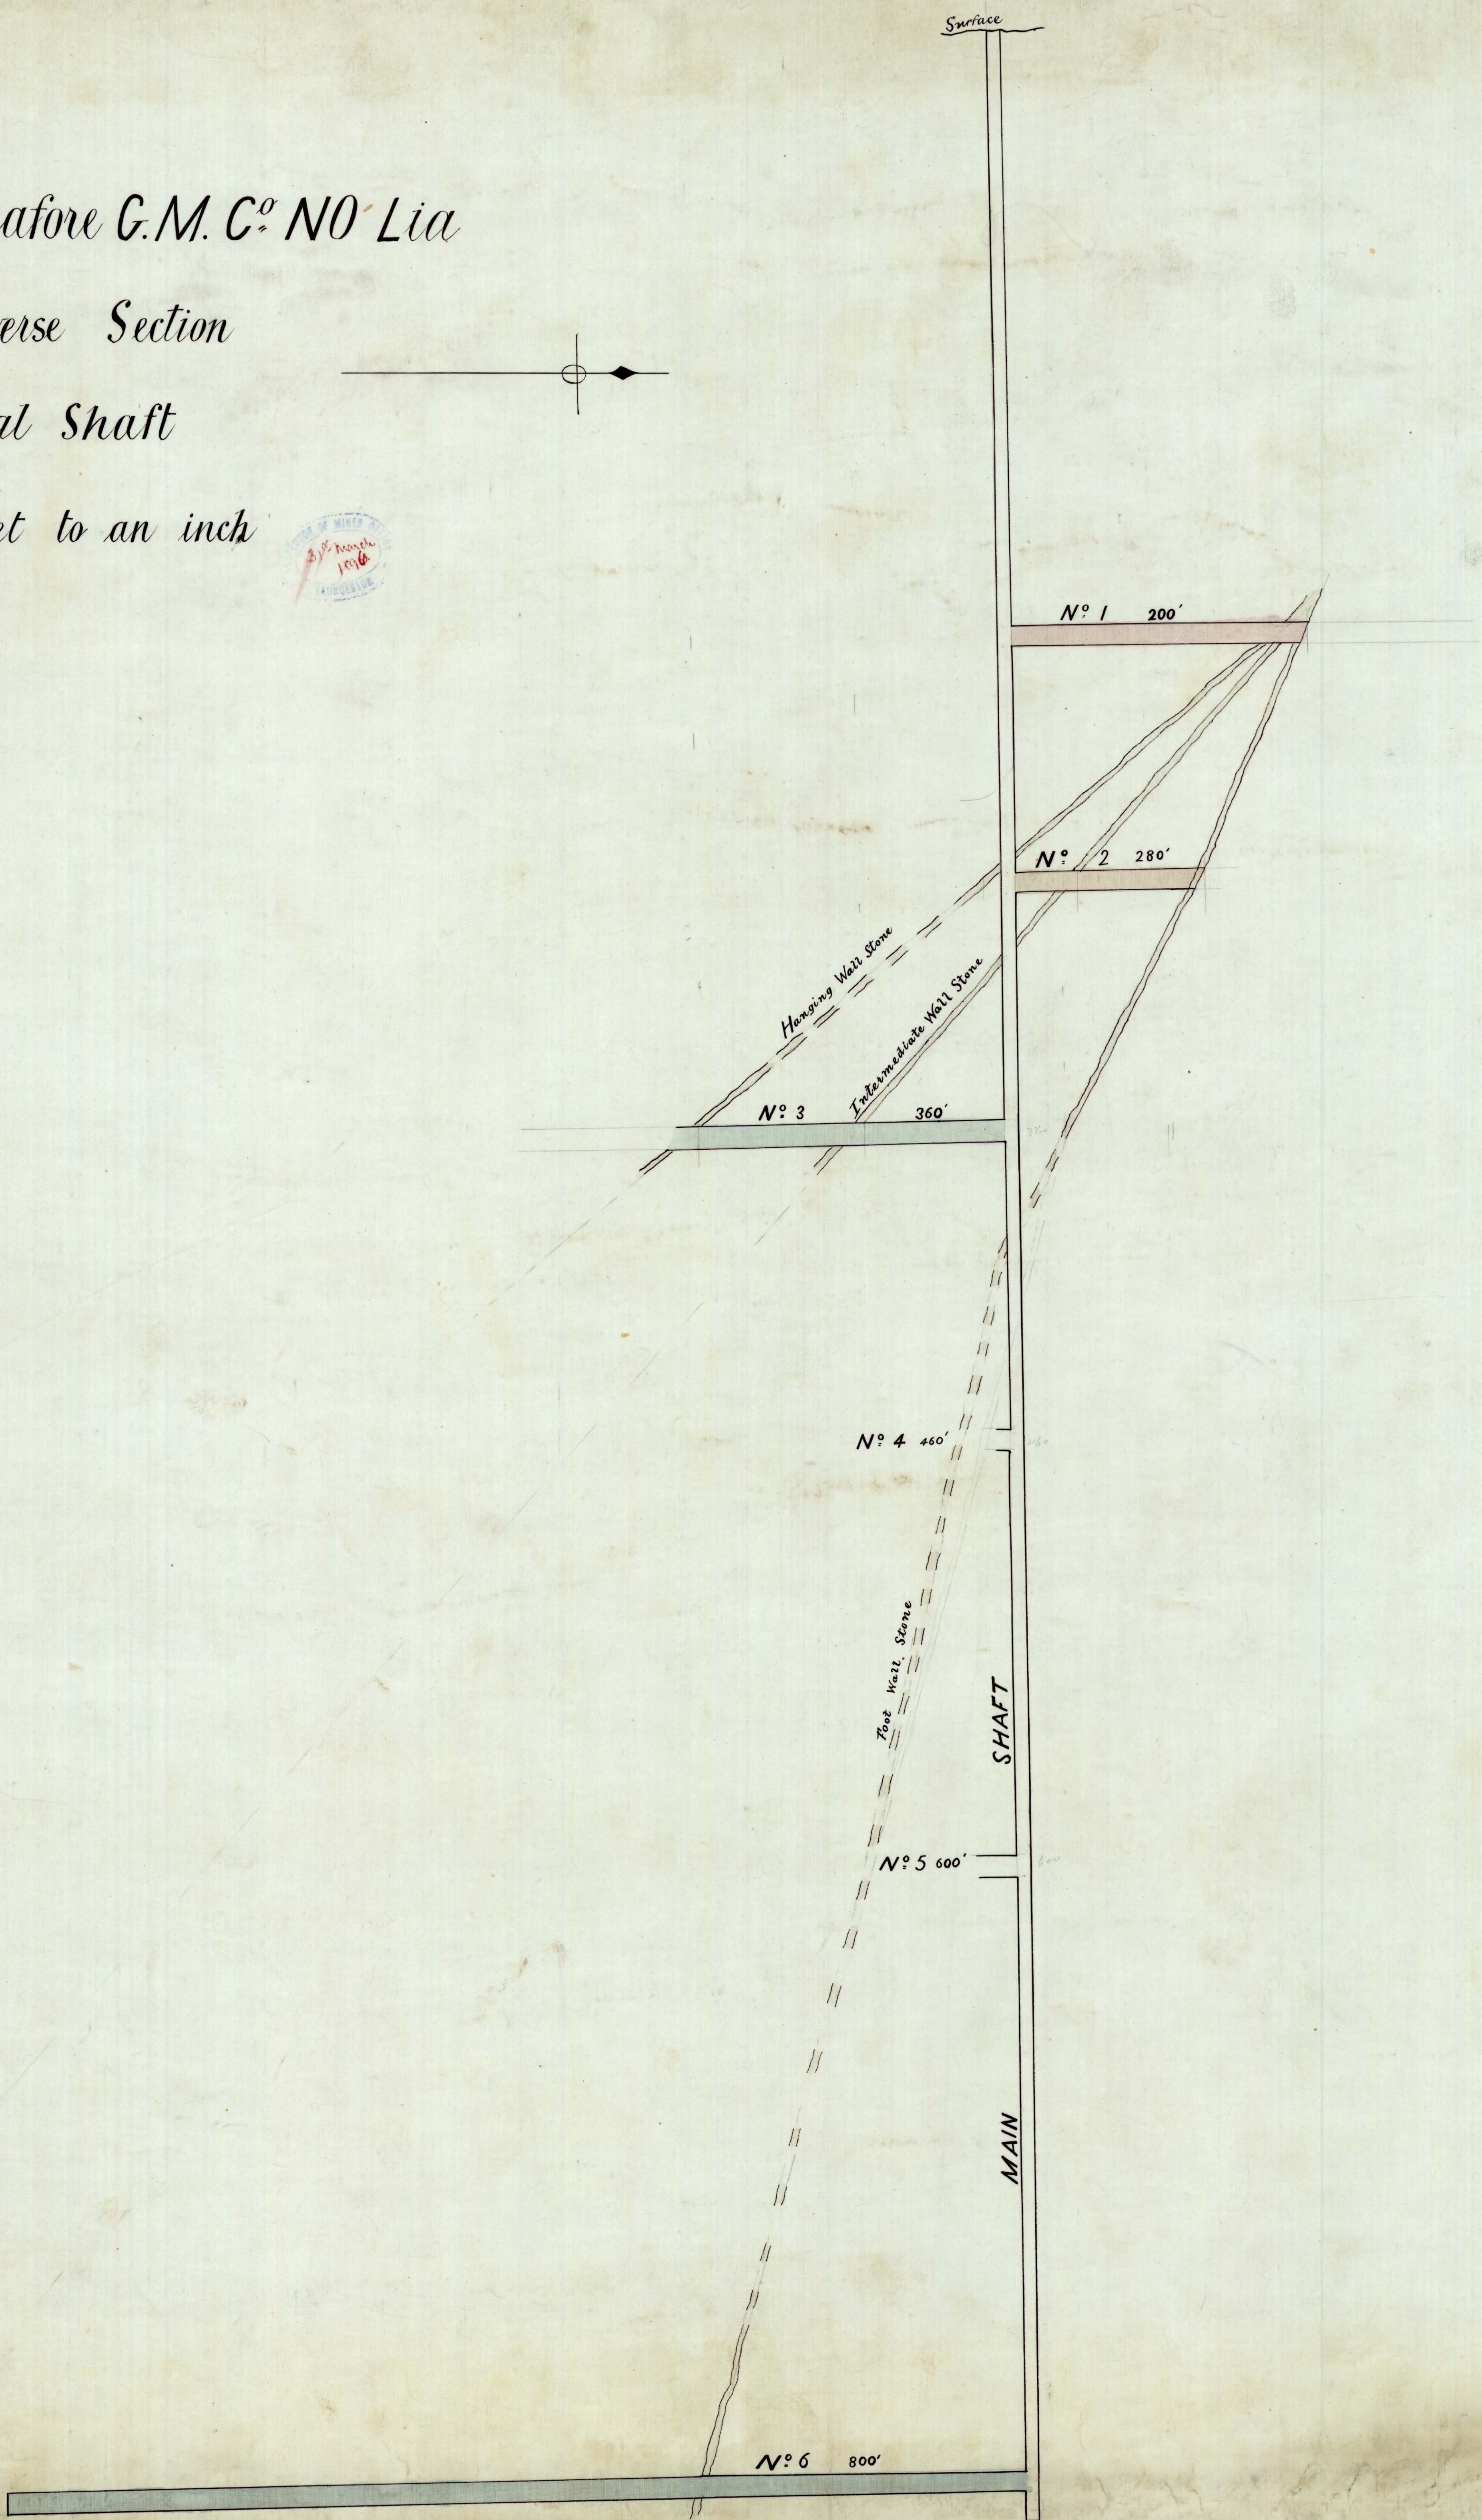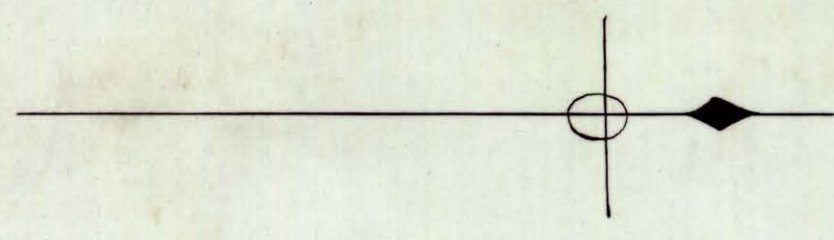

W. S. Miles.
Authorized Surveyor
January 1896

1888 New Pinafore