314
38.

Scale 2 .. in the

NEW PINAFORE G M Co

LEFROY

Scale 25 feet to an inch

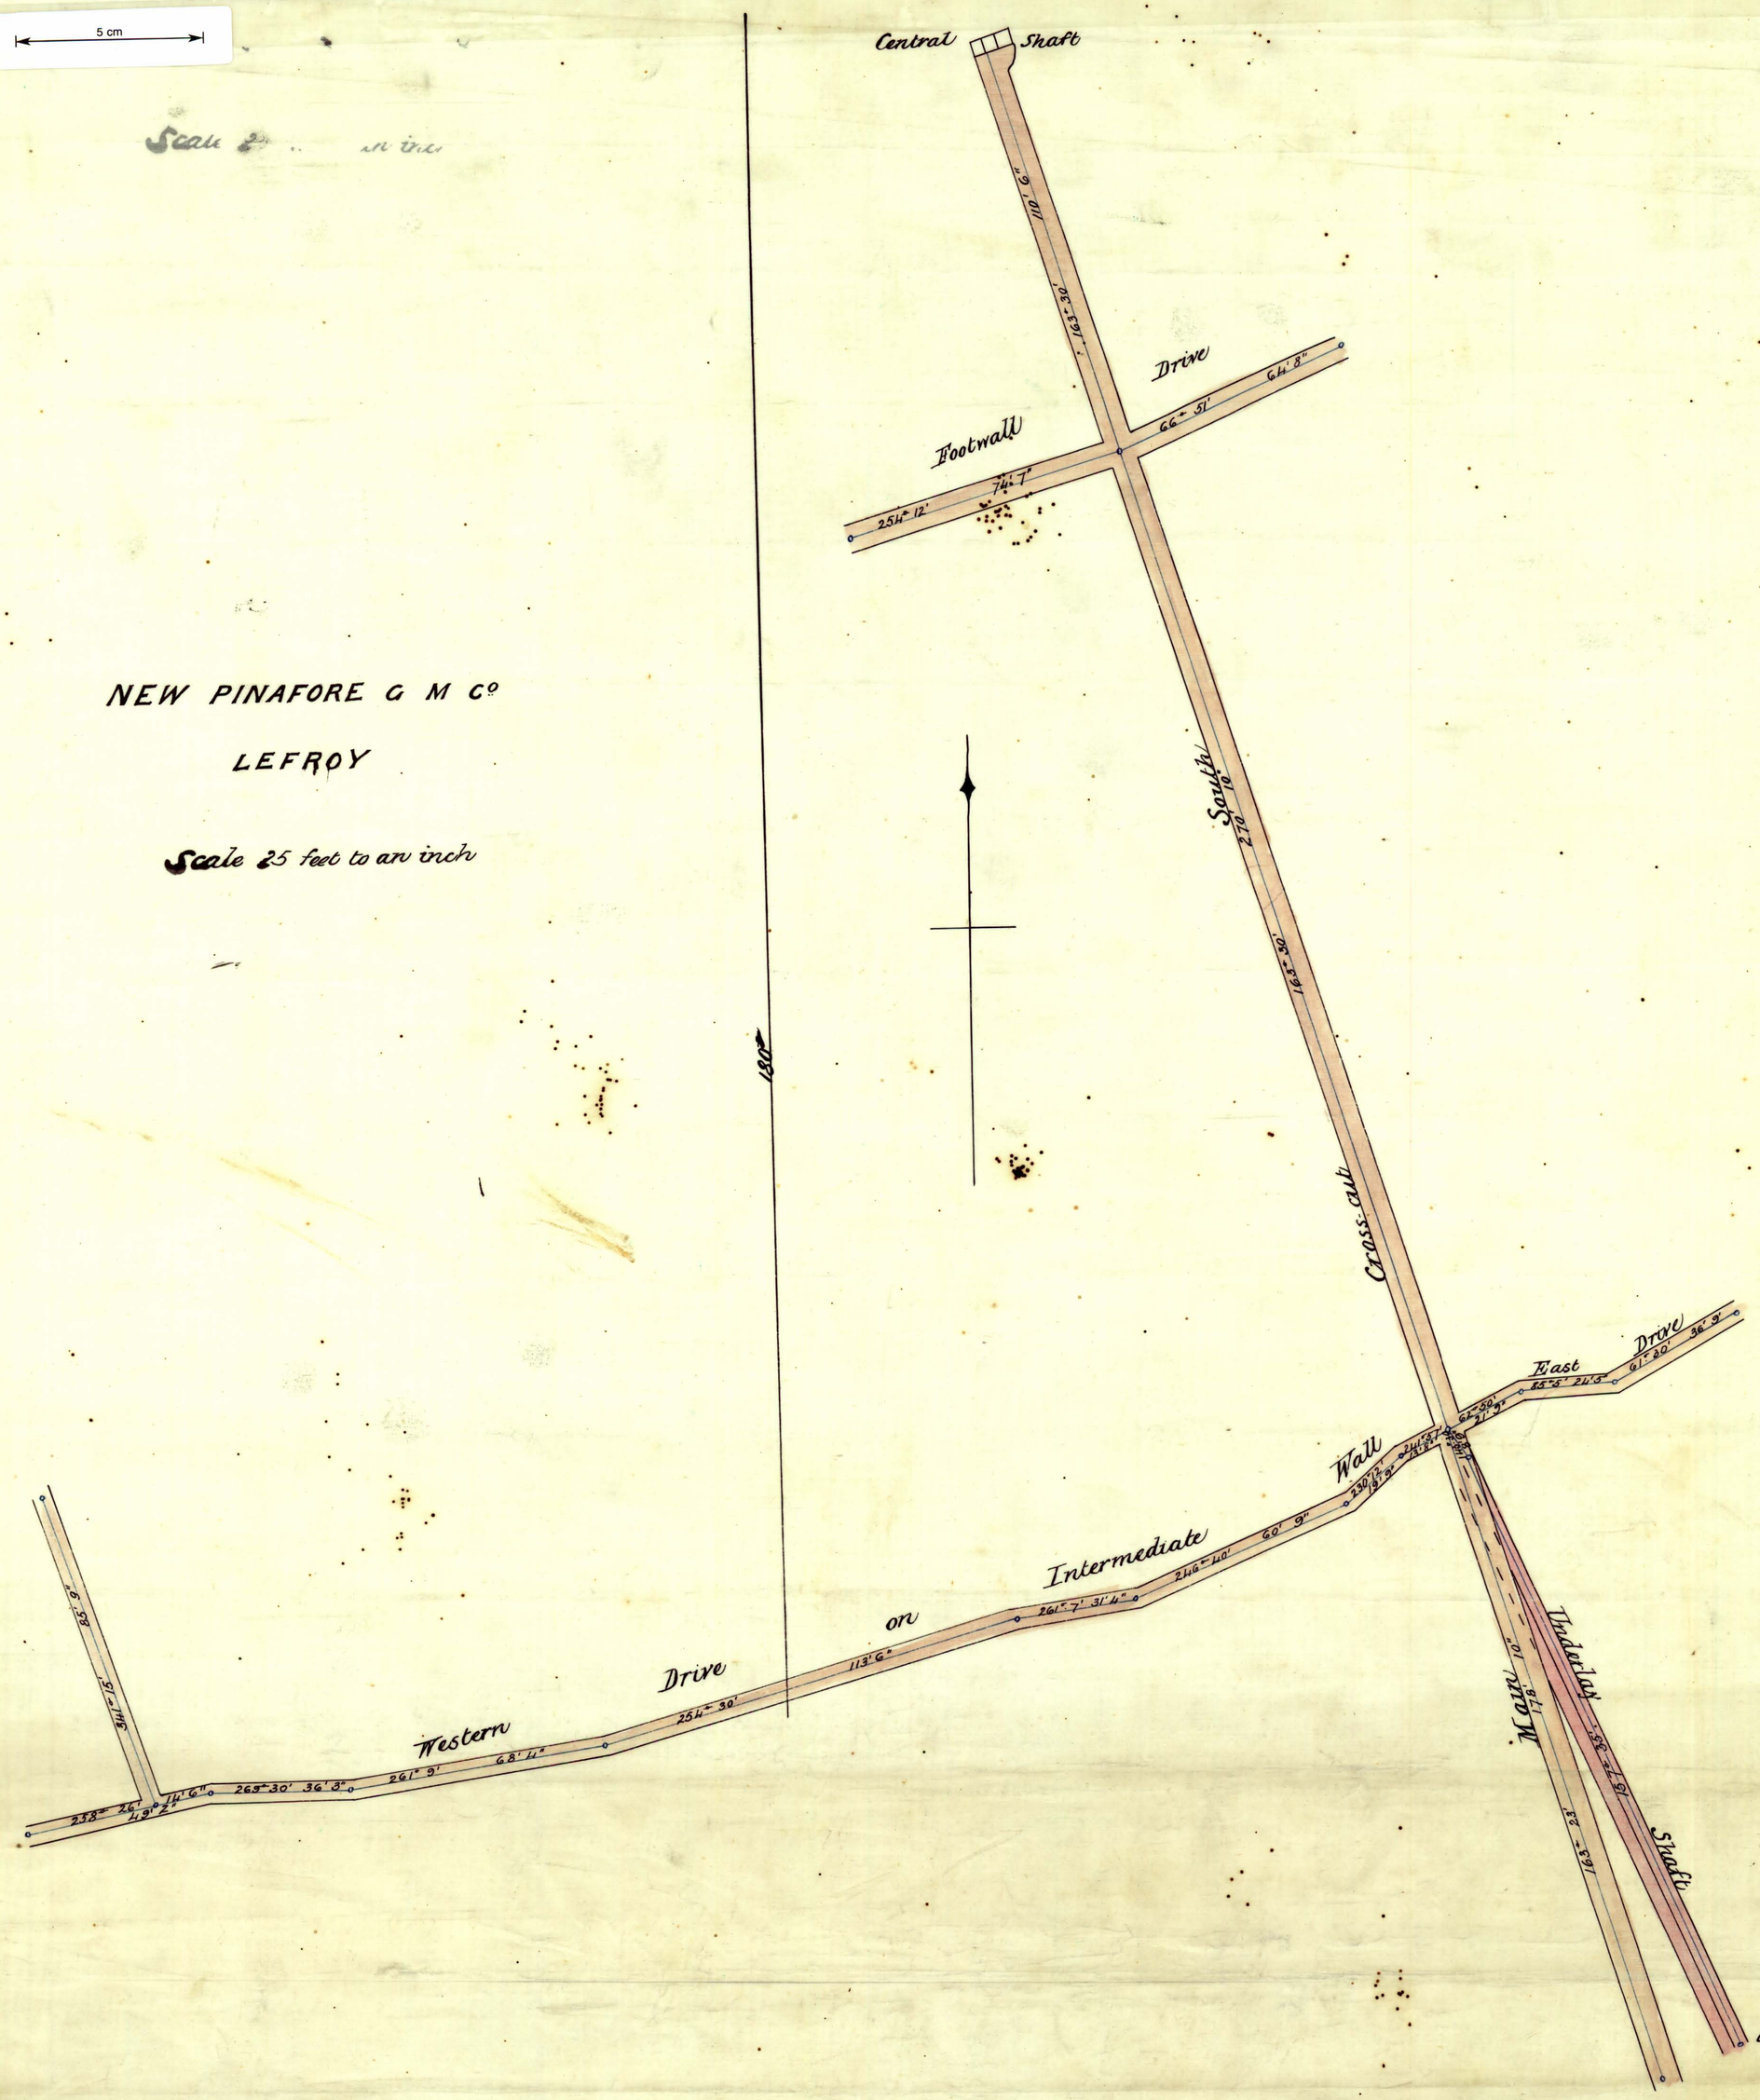

H. J. Miles.
Inverway.
Authorised Surveyor
Jany 94.

1497