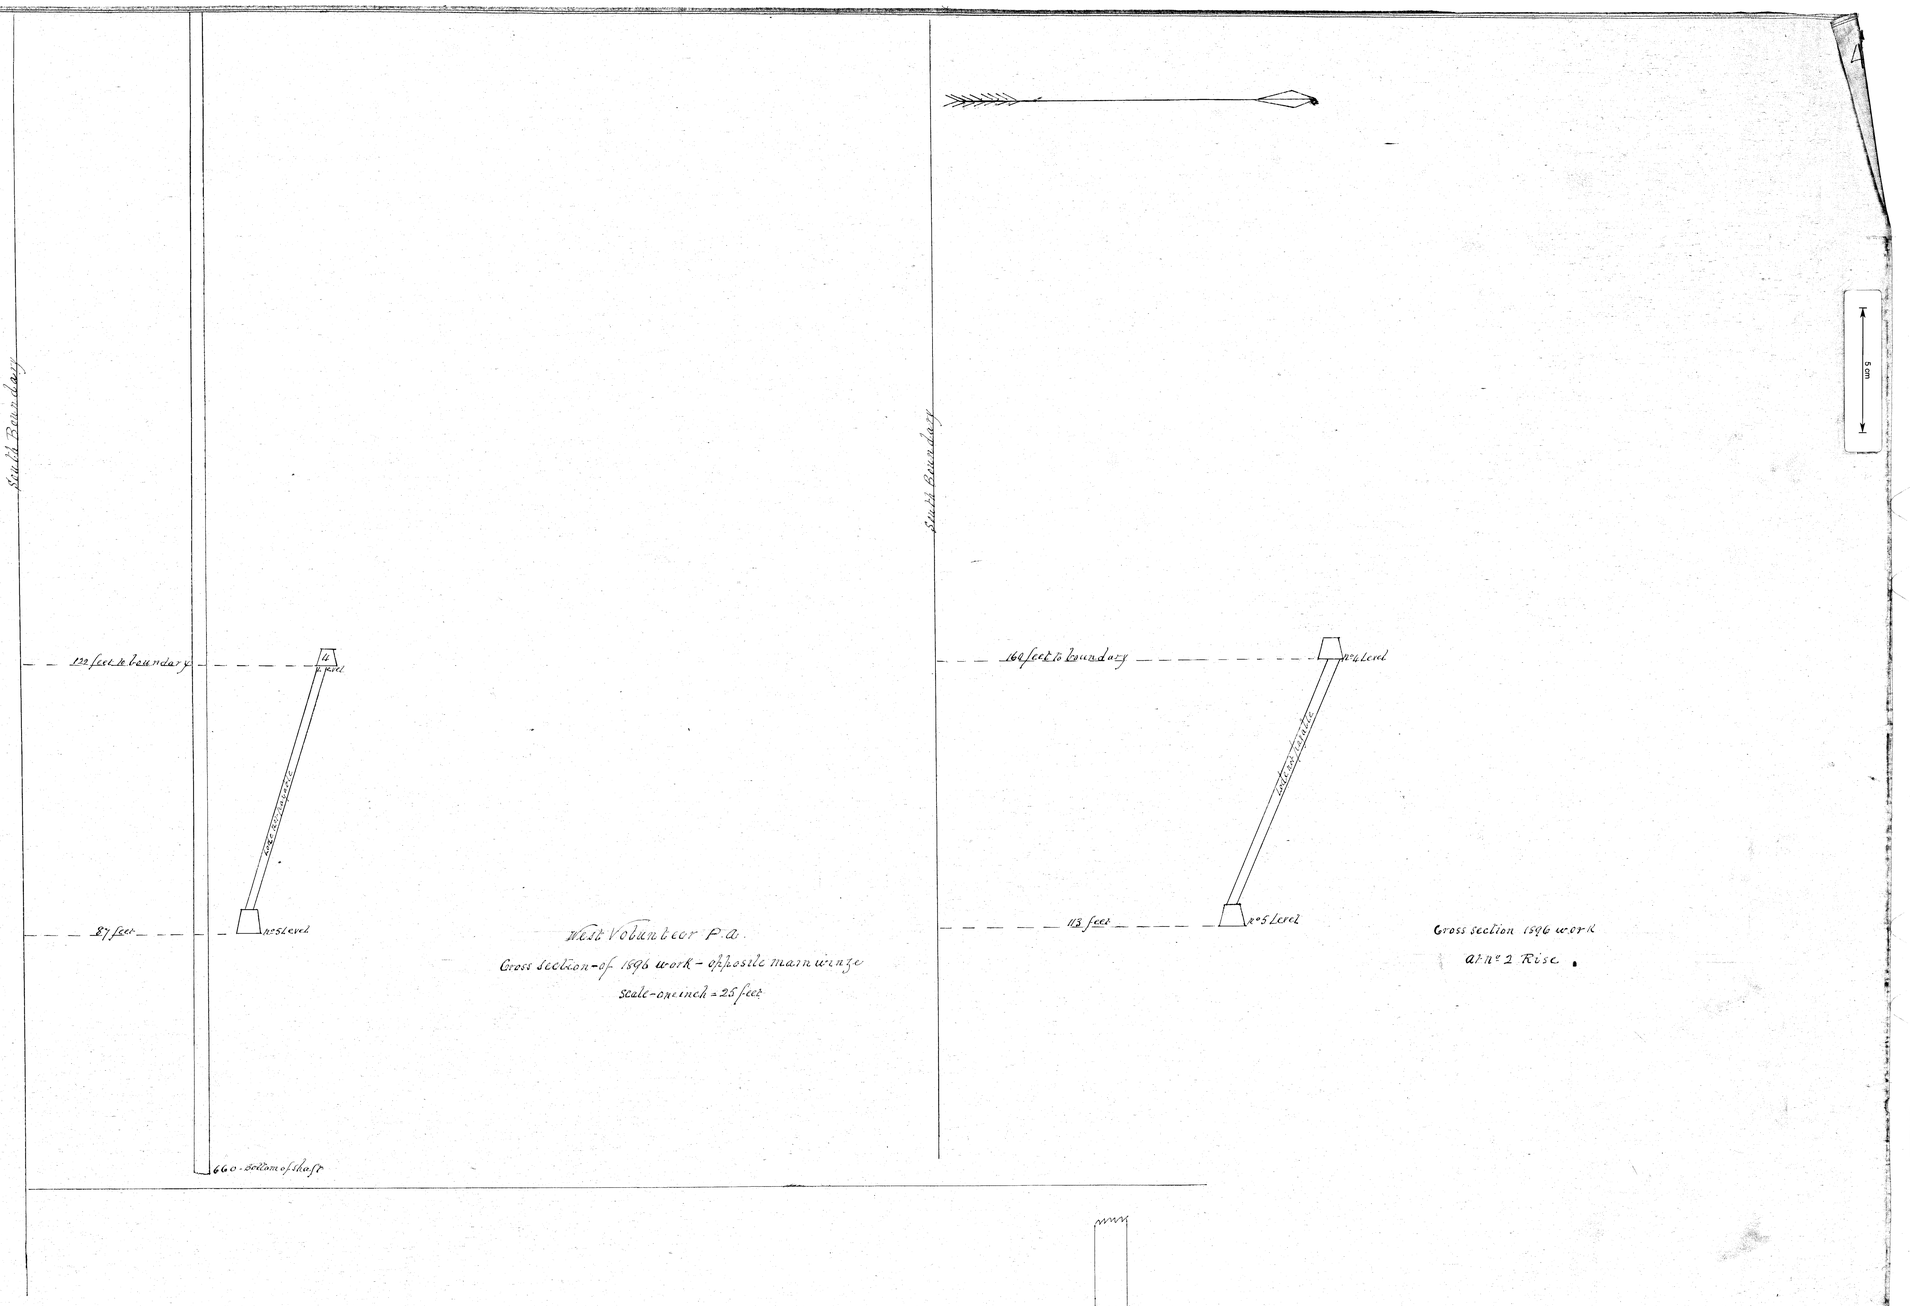

West Volunteer P.A.
Cross section - of 1896 work - opposite main winze
scale - one inch = 25 feet

Cross section 1896 work
at No 2 Rise.

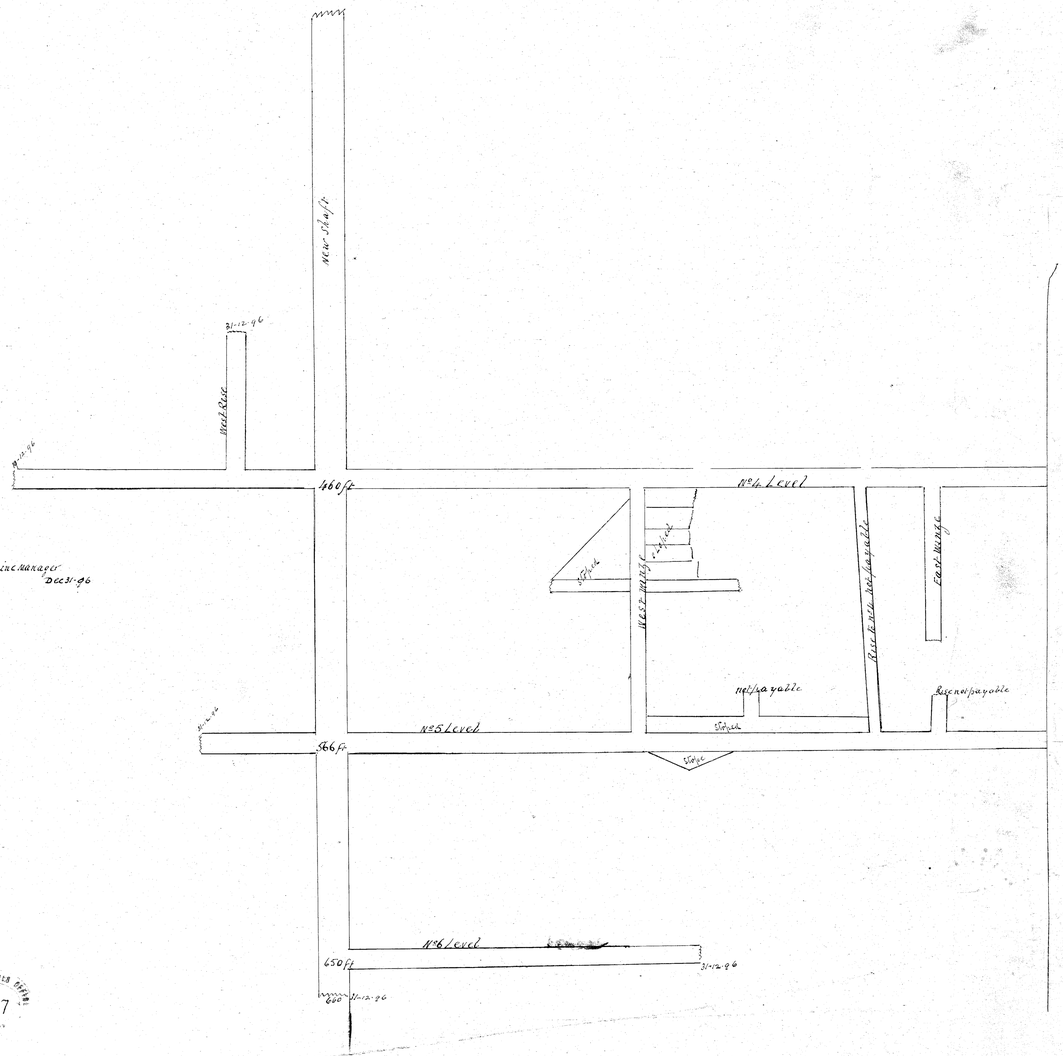

West Volunteer P.A. Lefroy.
Longitudinal section of 1896 work
Scale - one inch = 25 feet
J.M. Pitcer. mine manager
Dec 31-96

REGISTRAR OF MINES OFFICE
12/3/97

Section Jan. 1897