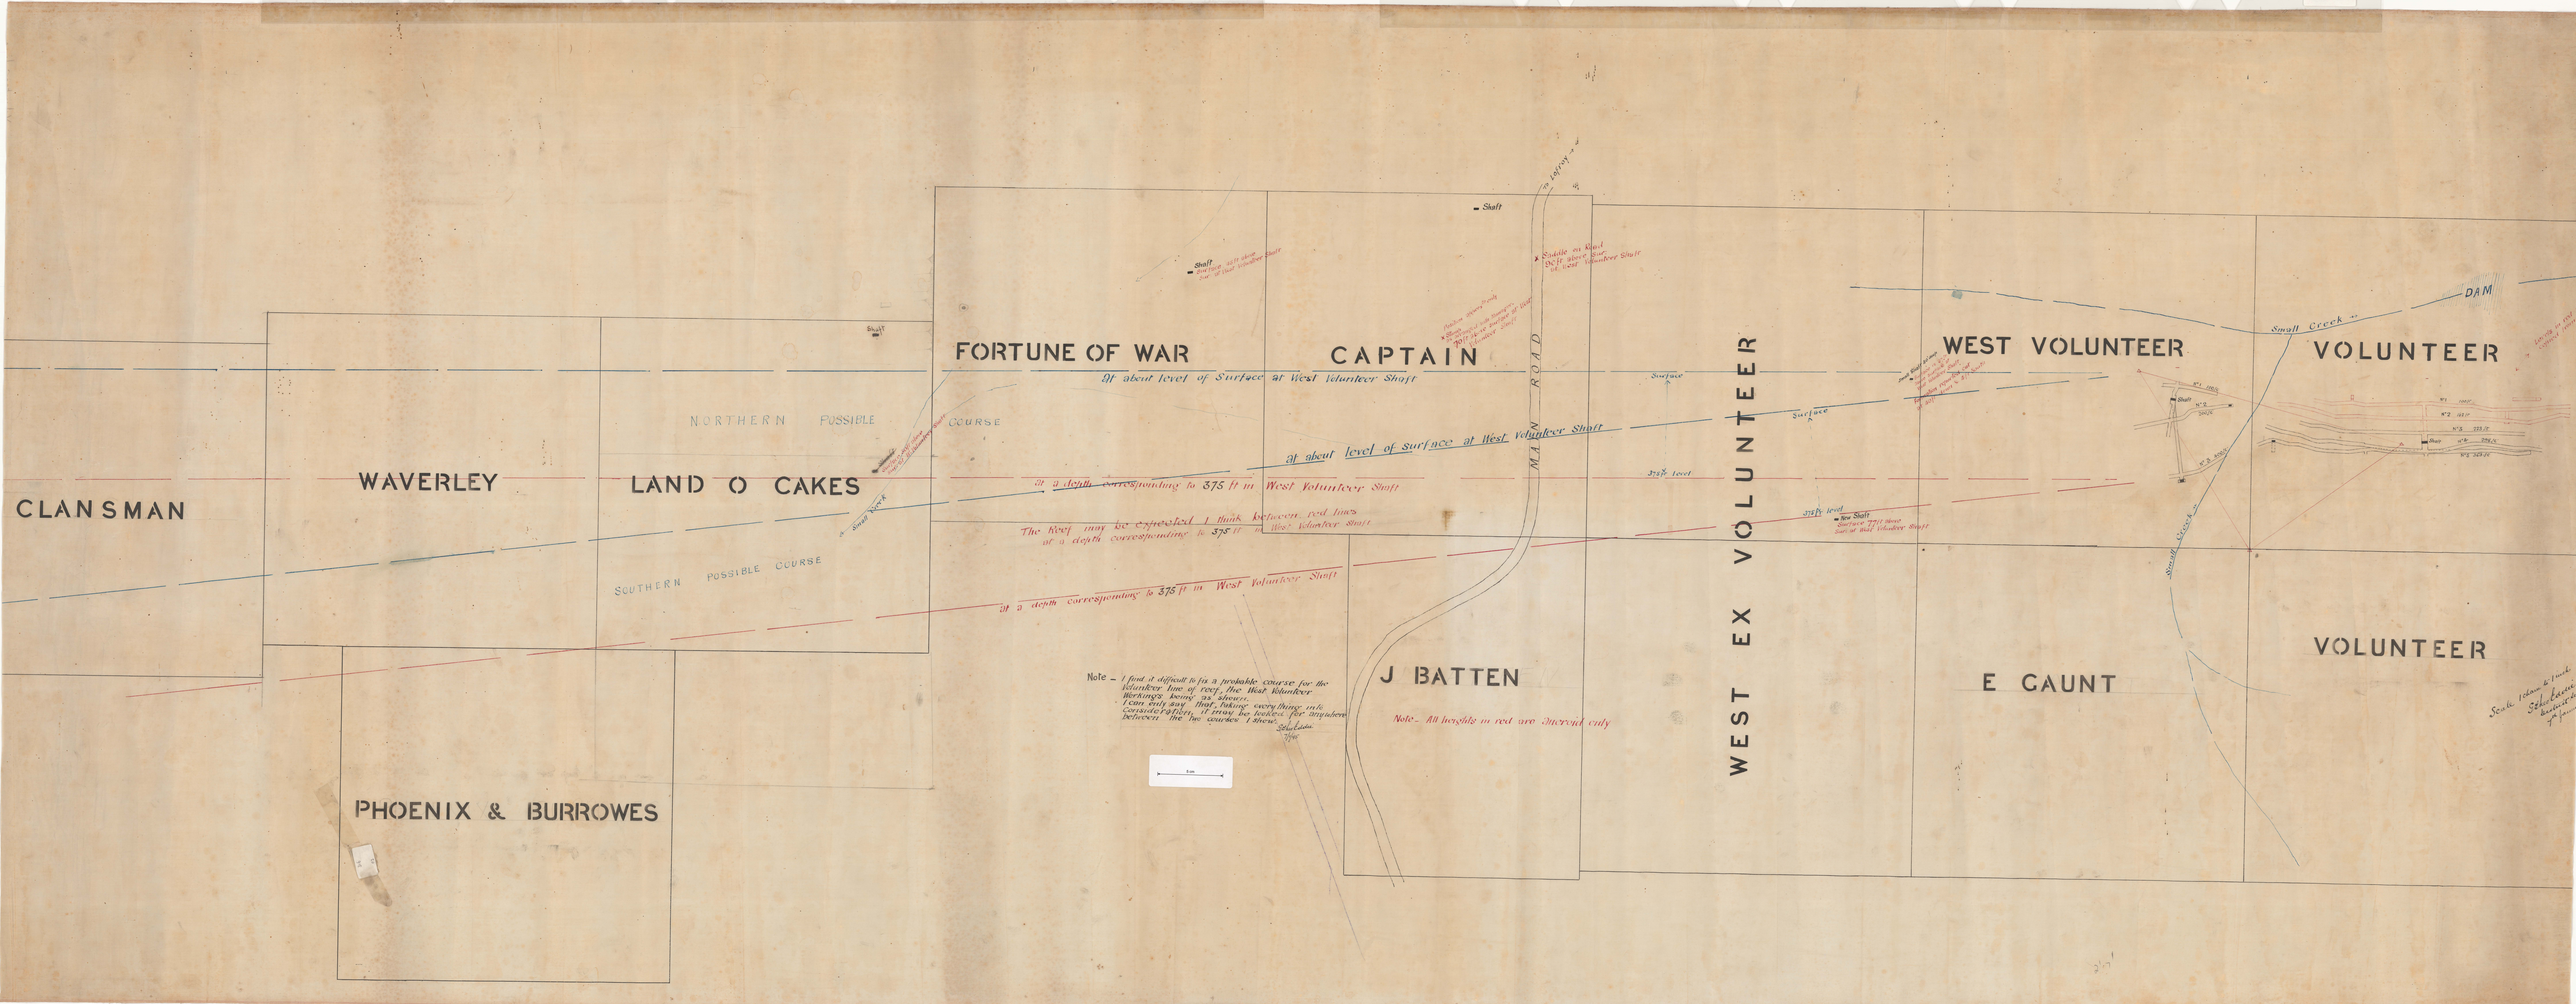
CLANSMAN
WAVERLEY
LAND O CAKES
NORTHERN POSSIBLE COURSE
SOUTHERN POSSIBLE COURSE
Small Creek
FORTUNE OF WAR
CAPTAIN
At about level of Surface at West Volunteer Shaft
at about level of surface at West Volunteer Shaft
at a depth corresponding to 375 ft in West Volunteer Shaft
The Reef may be expected I think between red lines at a depth corresponding to 375 ft in West Volunteer Shaft
at a depth corresponding to 375 ft in West Volunteer Shaft
MAIN ROAD
Shaft
Saddle on Road 20 ft above Surface at West Volunteer Shaft
Surface
375ft level
West Shaft
Surface 7ft above Level at West Volunteer Shaft
WEST EX VOLUNTEER
WEST VOLUNTEER
DAM
Small Creek
VOLUNTEER
VOLUNTEER
J BATTEN
E CAUNT
PHOENIX & BURROWES
Note – I find a difficult to fix a probable course for the Volunteer line of reef, the West Volunteer Workings being so blown. I can only say that, taking everything into Consideration, it must be looked for somewhere between the two courses I have laid down
Note – All heights in red are observed only