
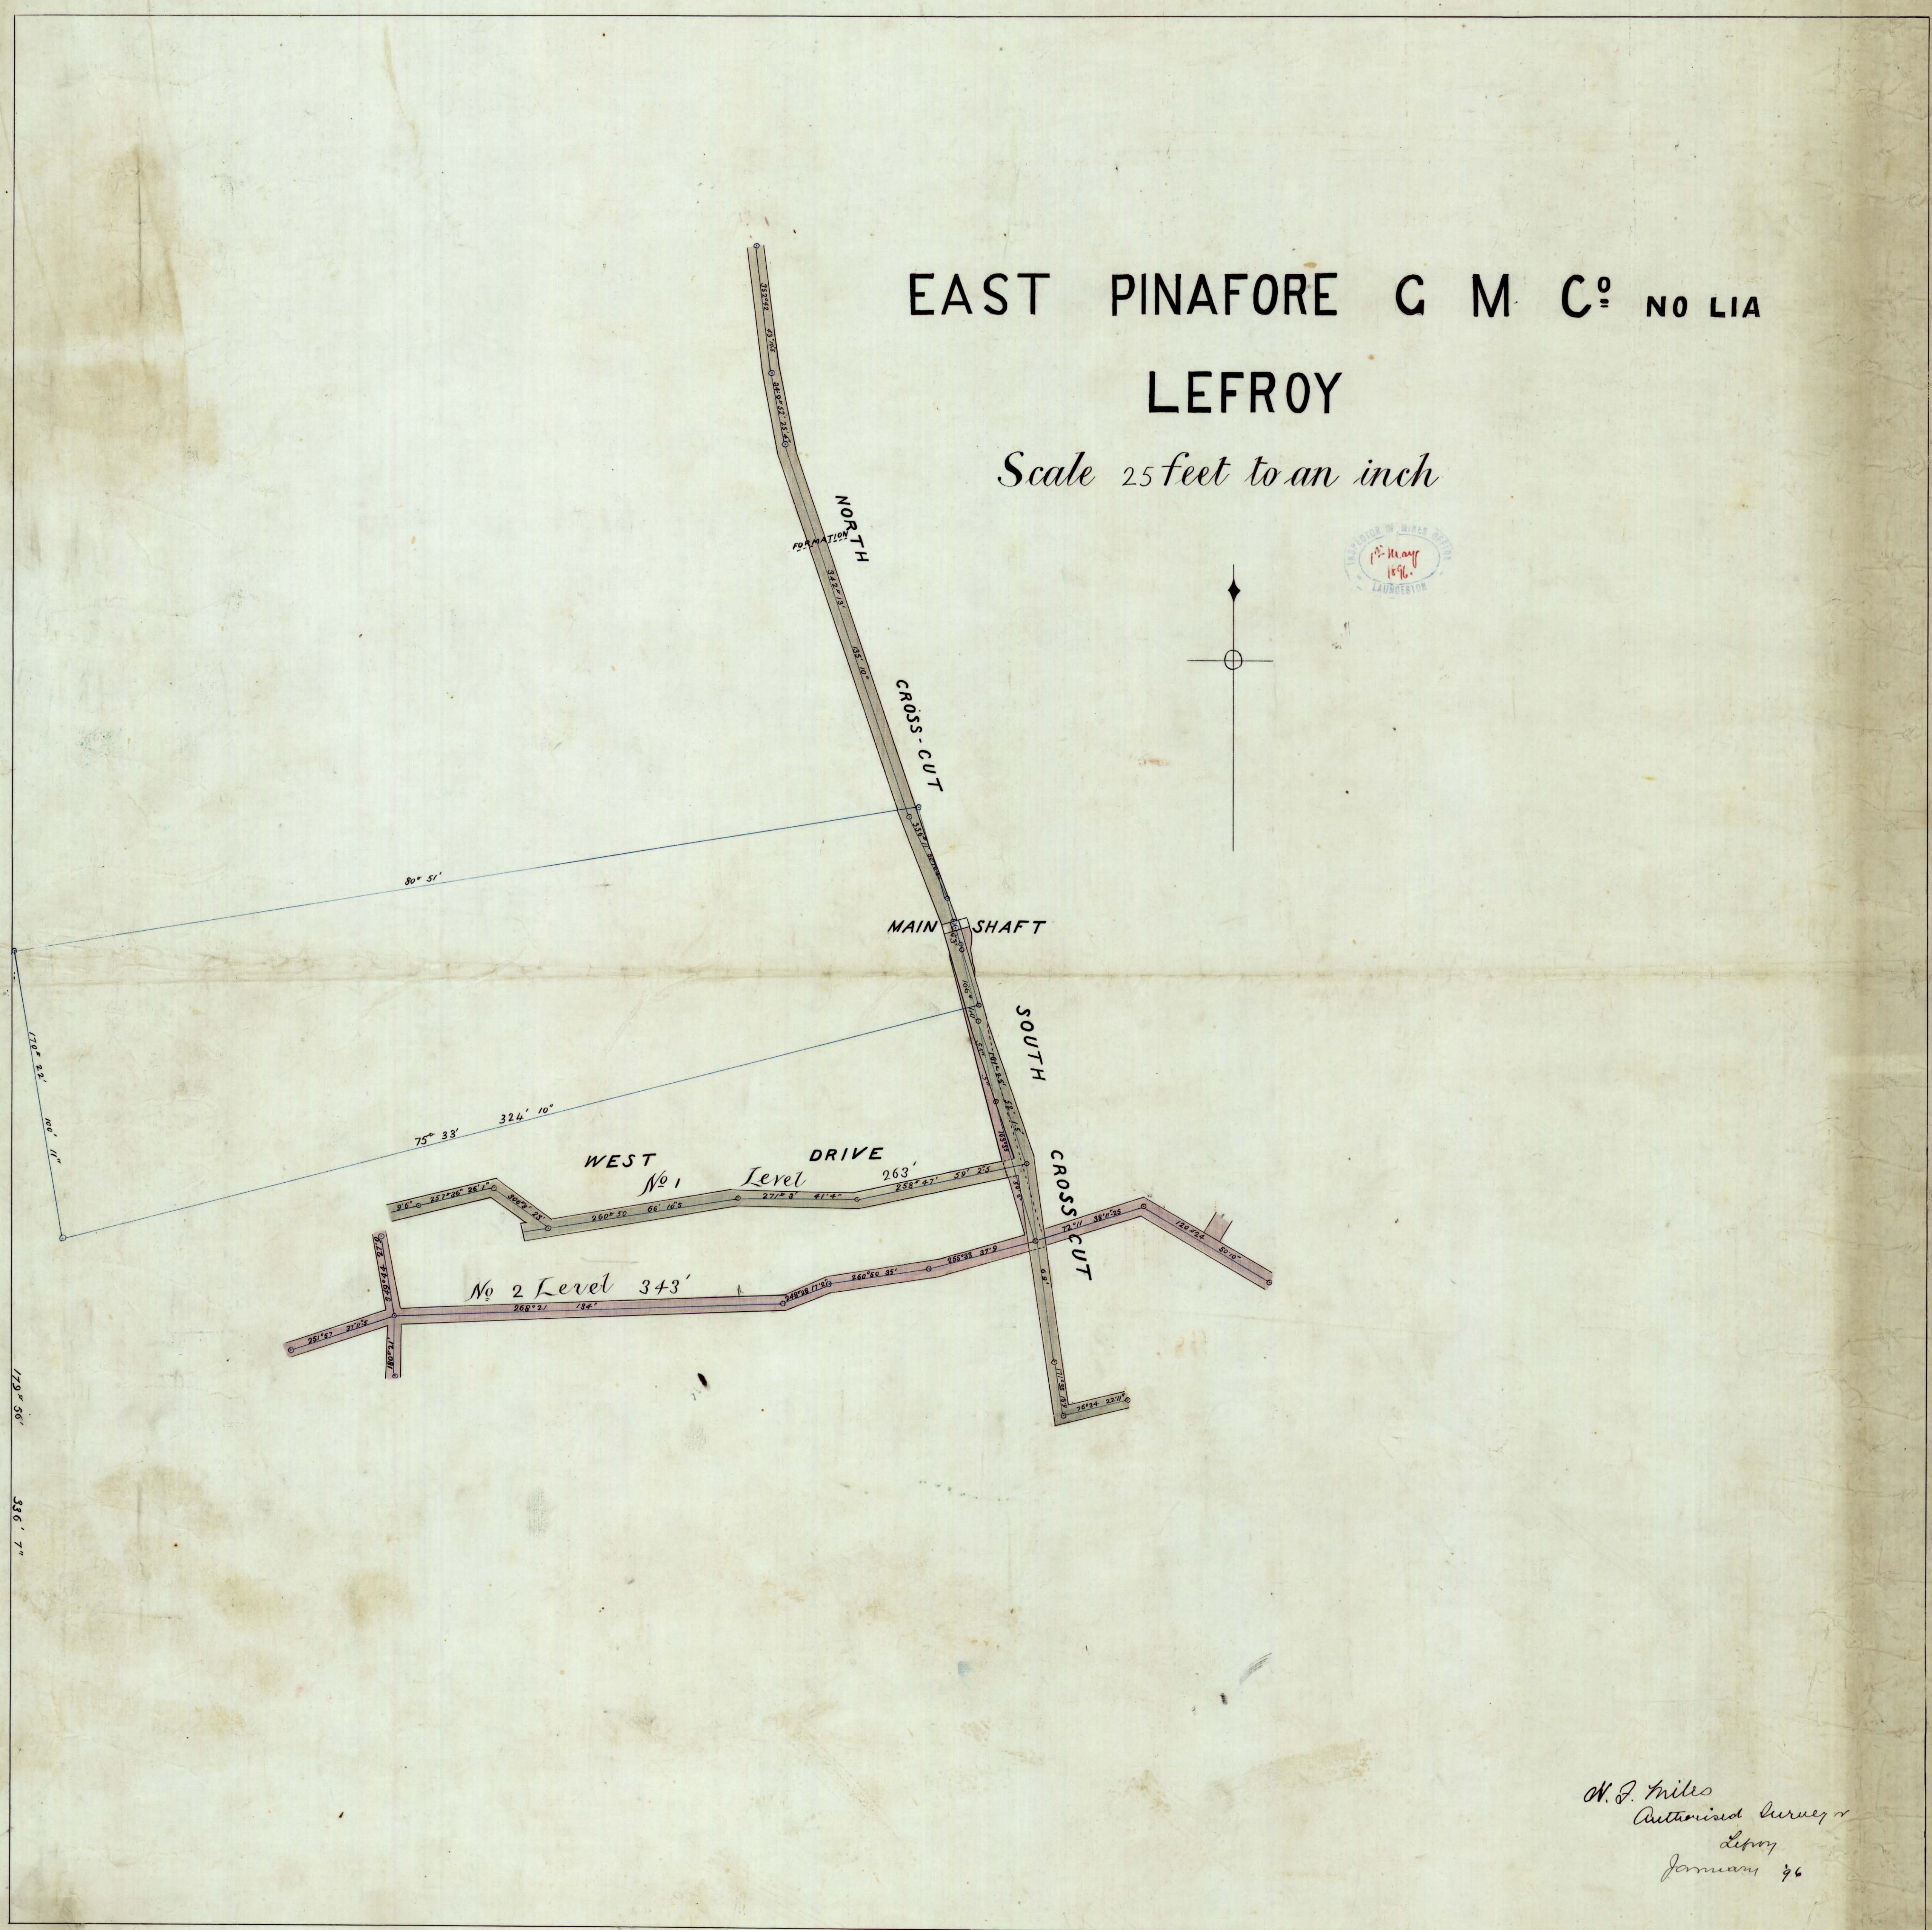


5 cm

41
2081. m. 1
1003

EAST PINAFORE C M C^o NO LIA LEFROY

Scale 25 feet to an inch

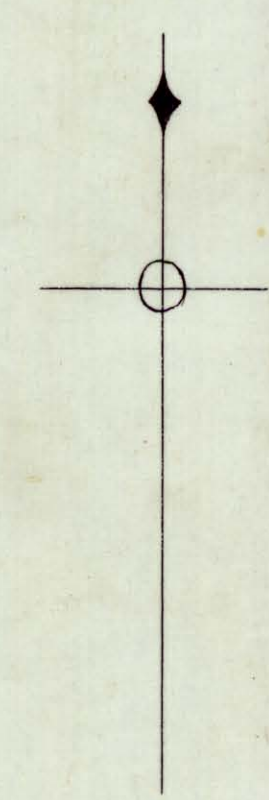

W. J. Miles
Authorised Surveyor
Levey
January 76

42