



27th March
1894
LAUGHER

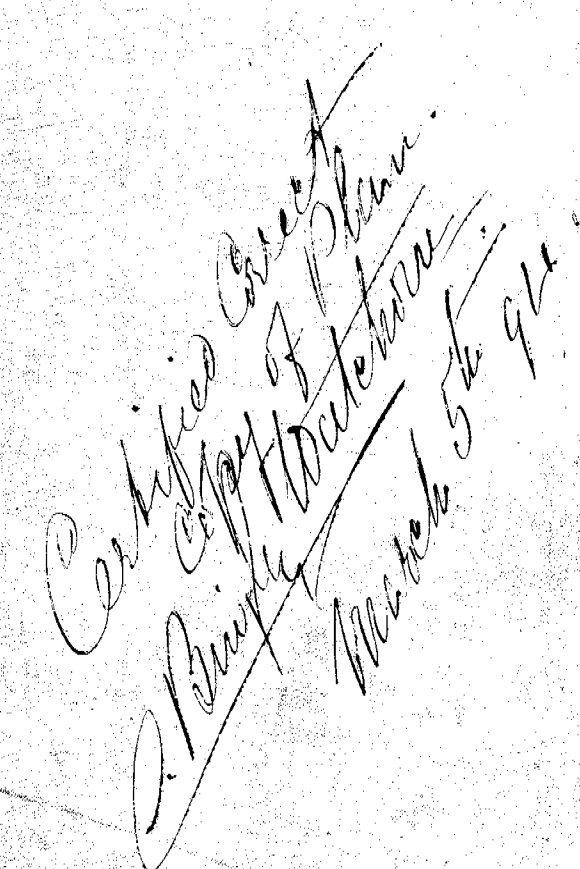

W
L