
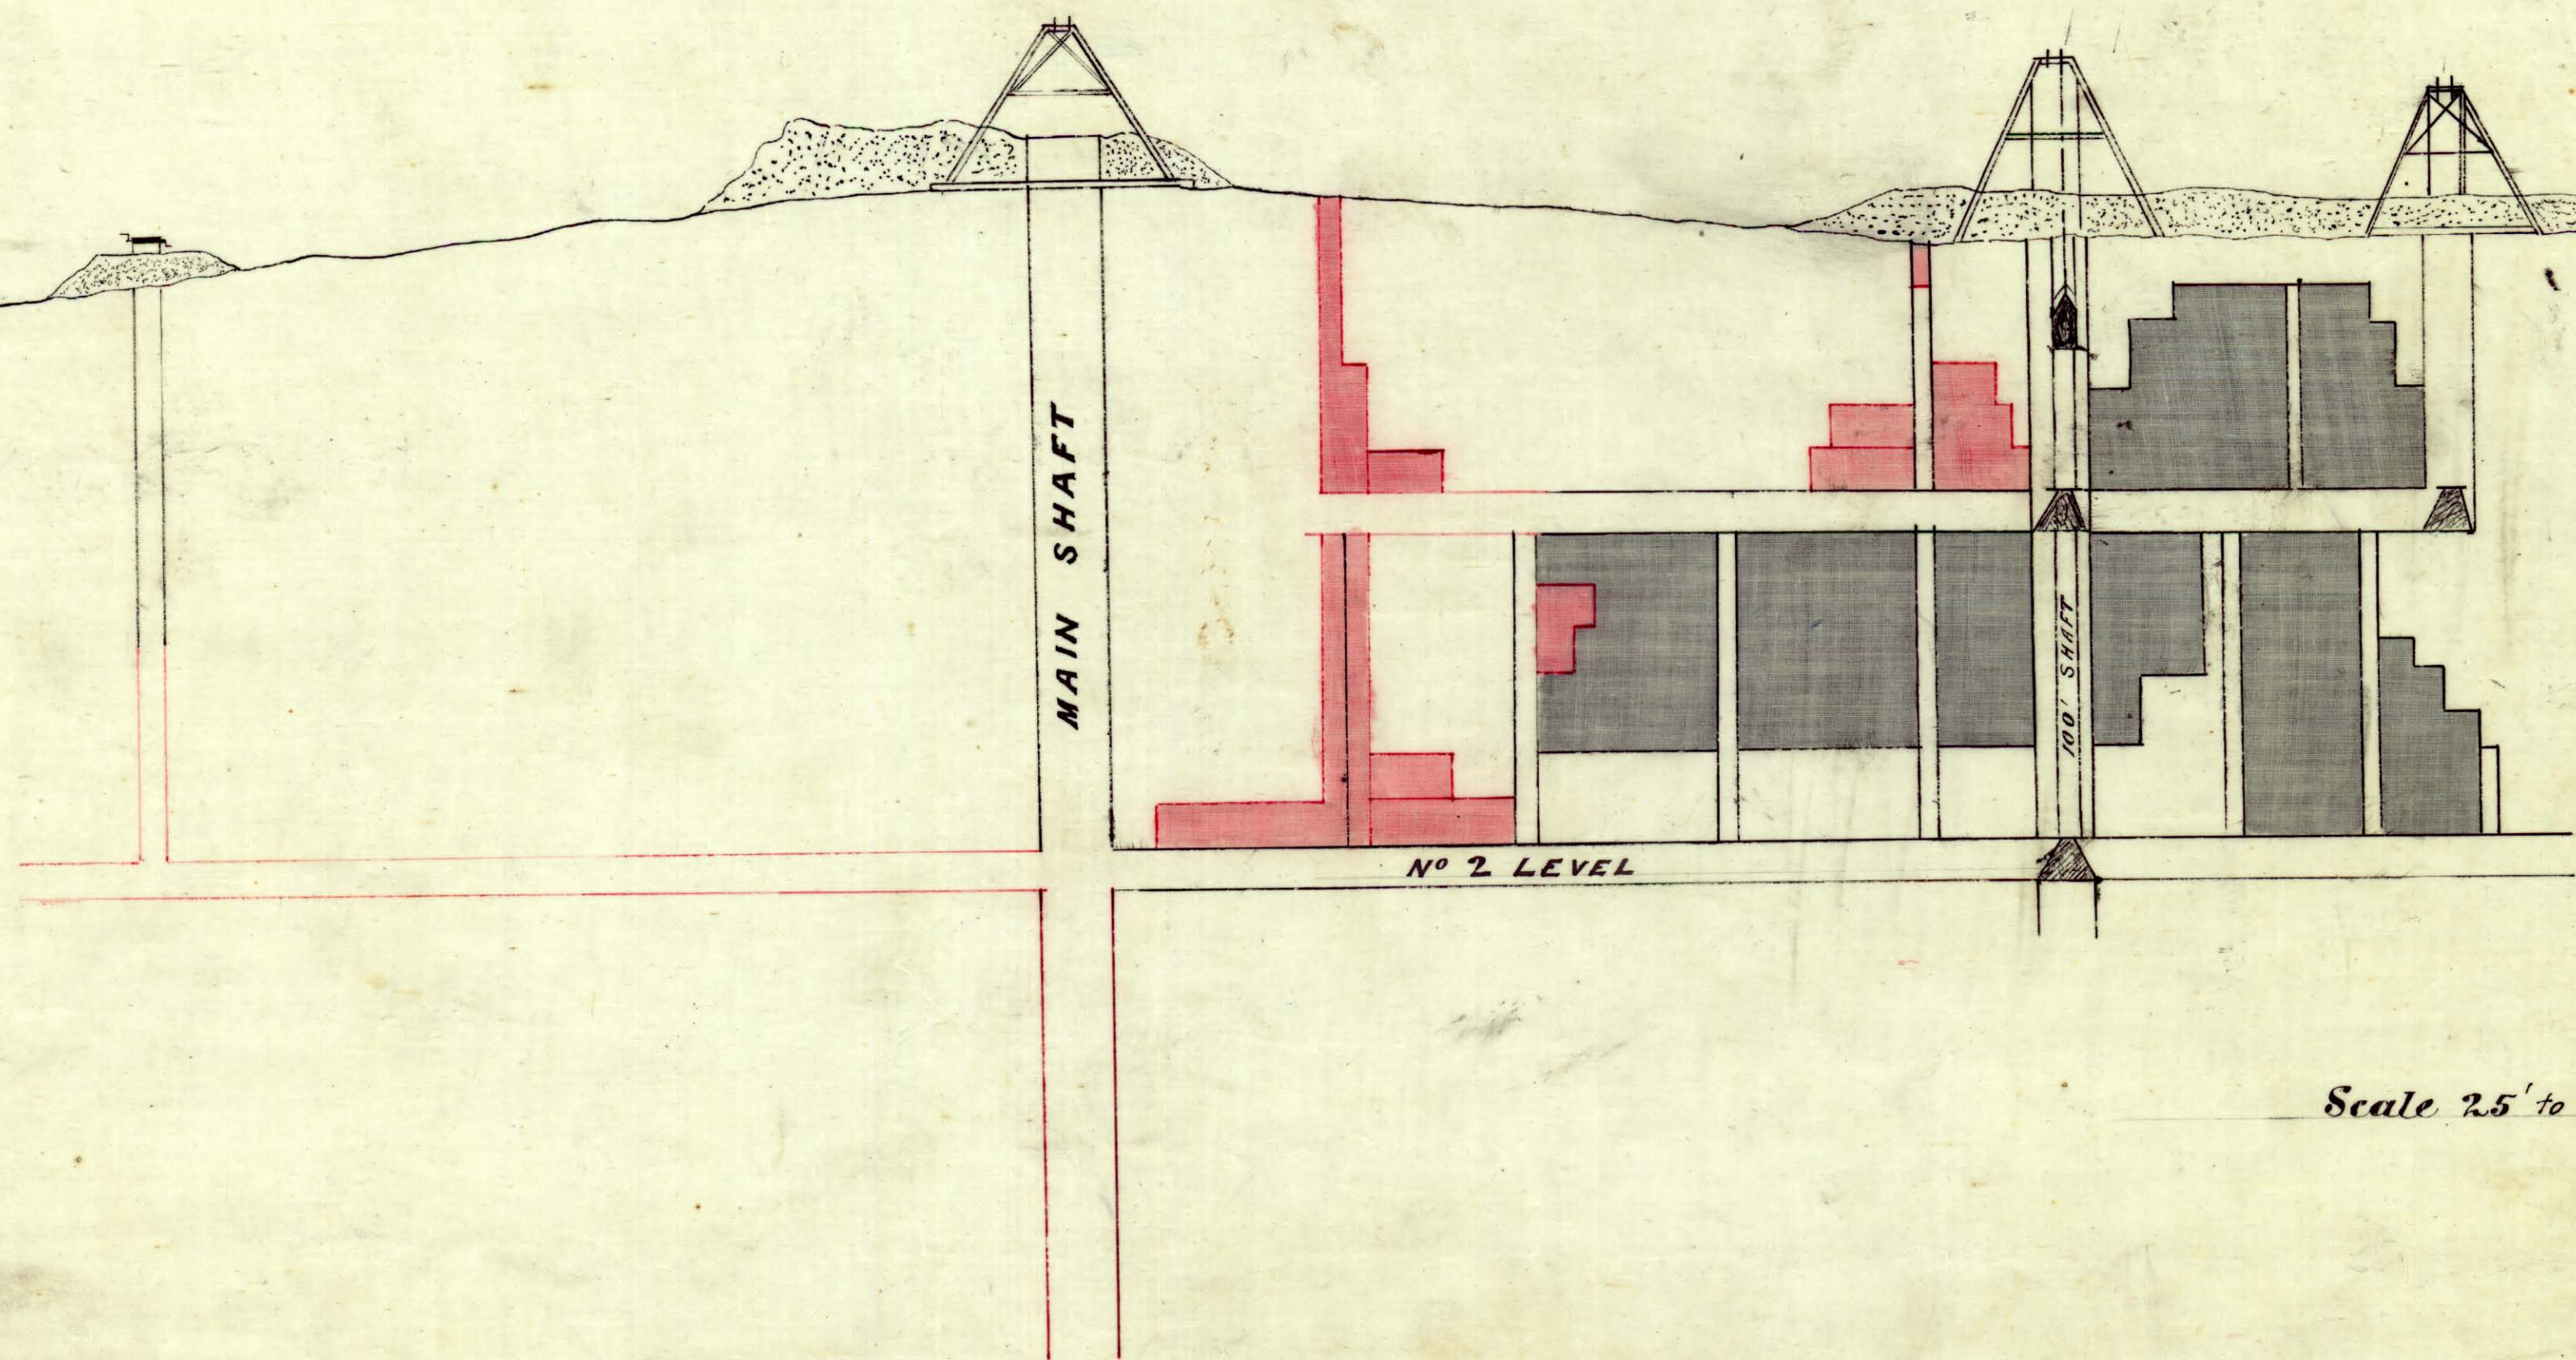


VOLUNTEER G.M. LEFROY

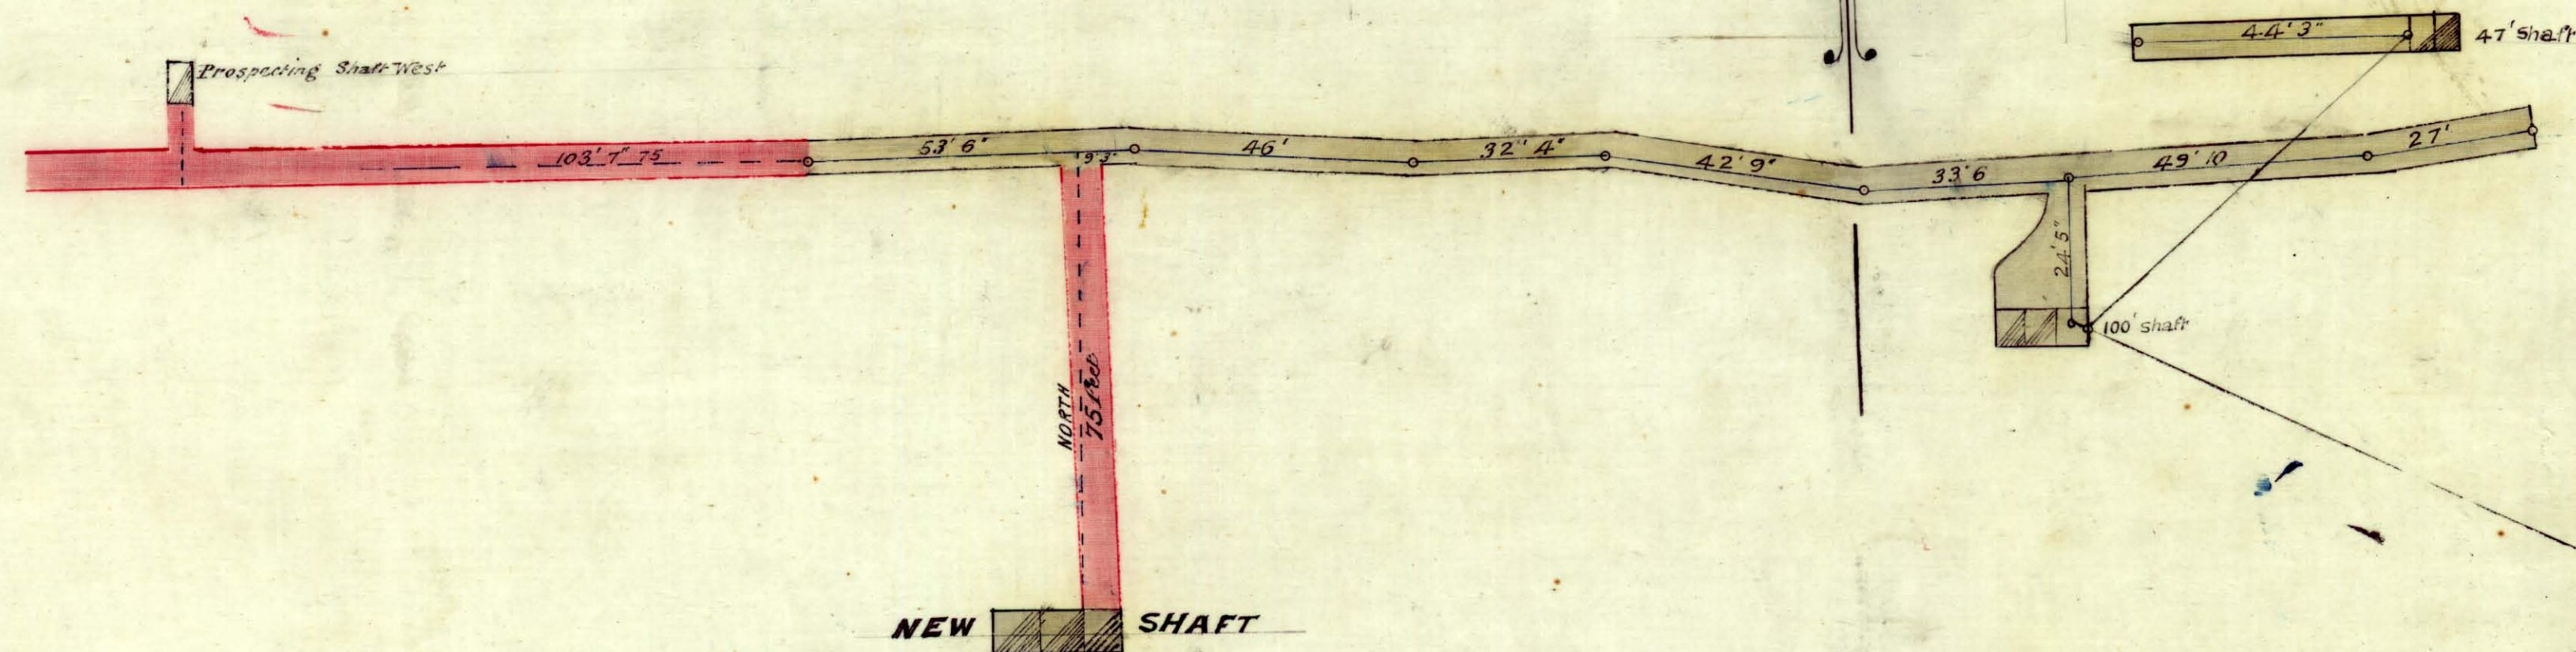

Scale 2.5' to one inch