
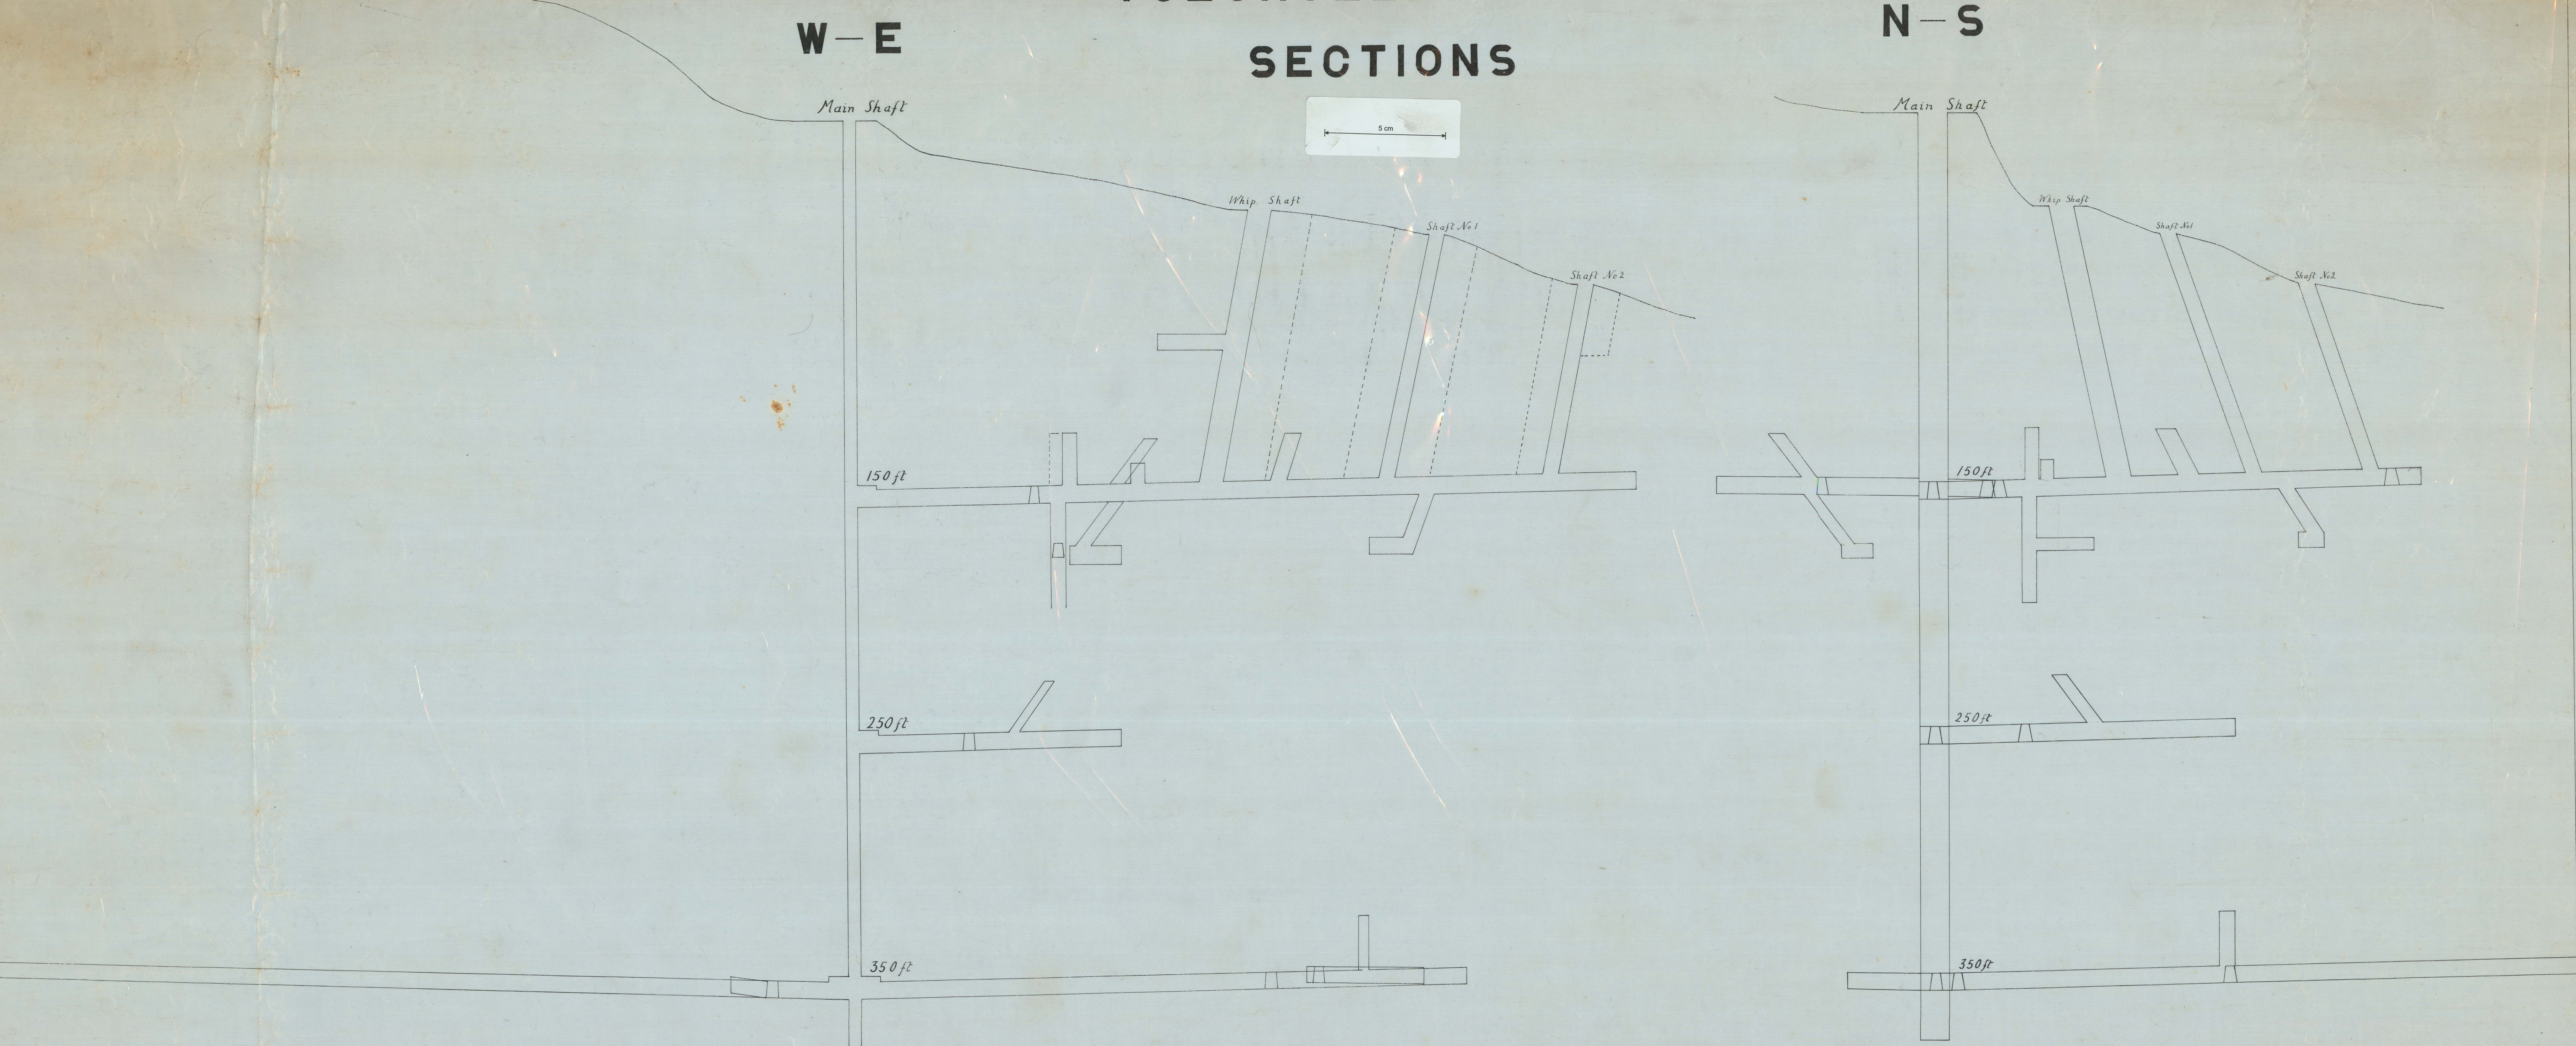


# VOLUNTEER MINE SECTIONS

W-E

N-S

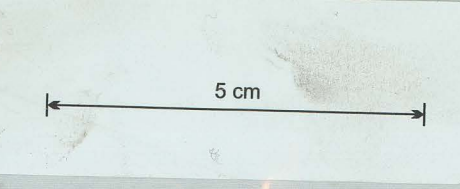

Scale

1 in = 25 ft

Hartwell Conder  
Dec 1904

Volunteer Mine  
for 1904