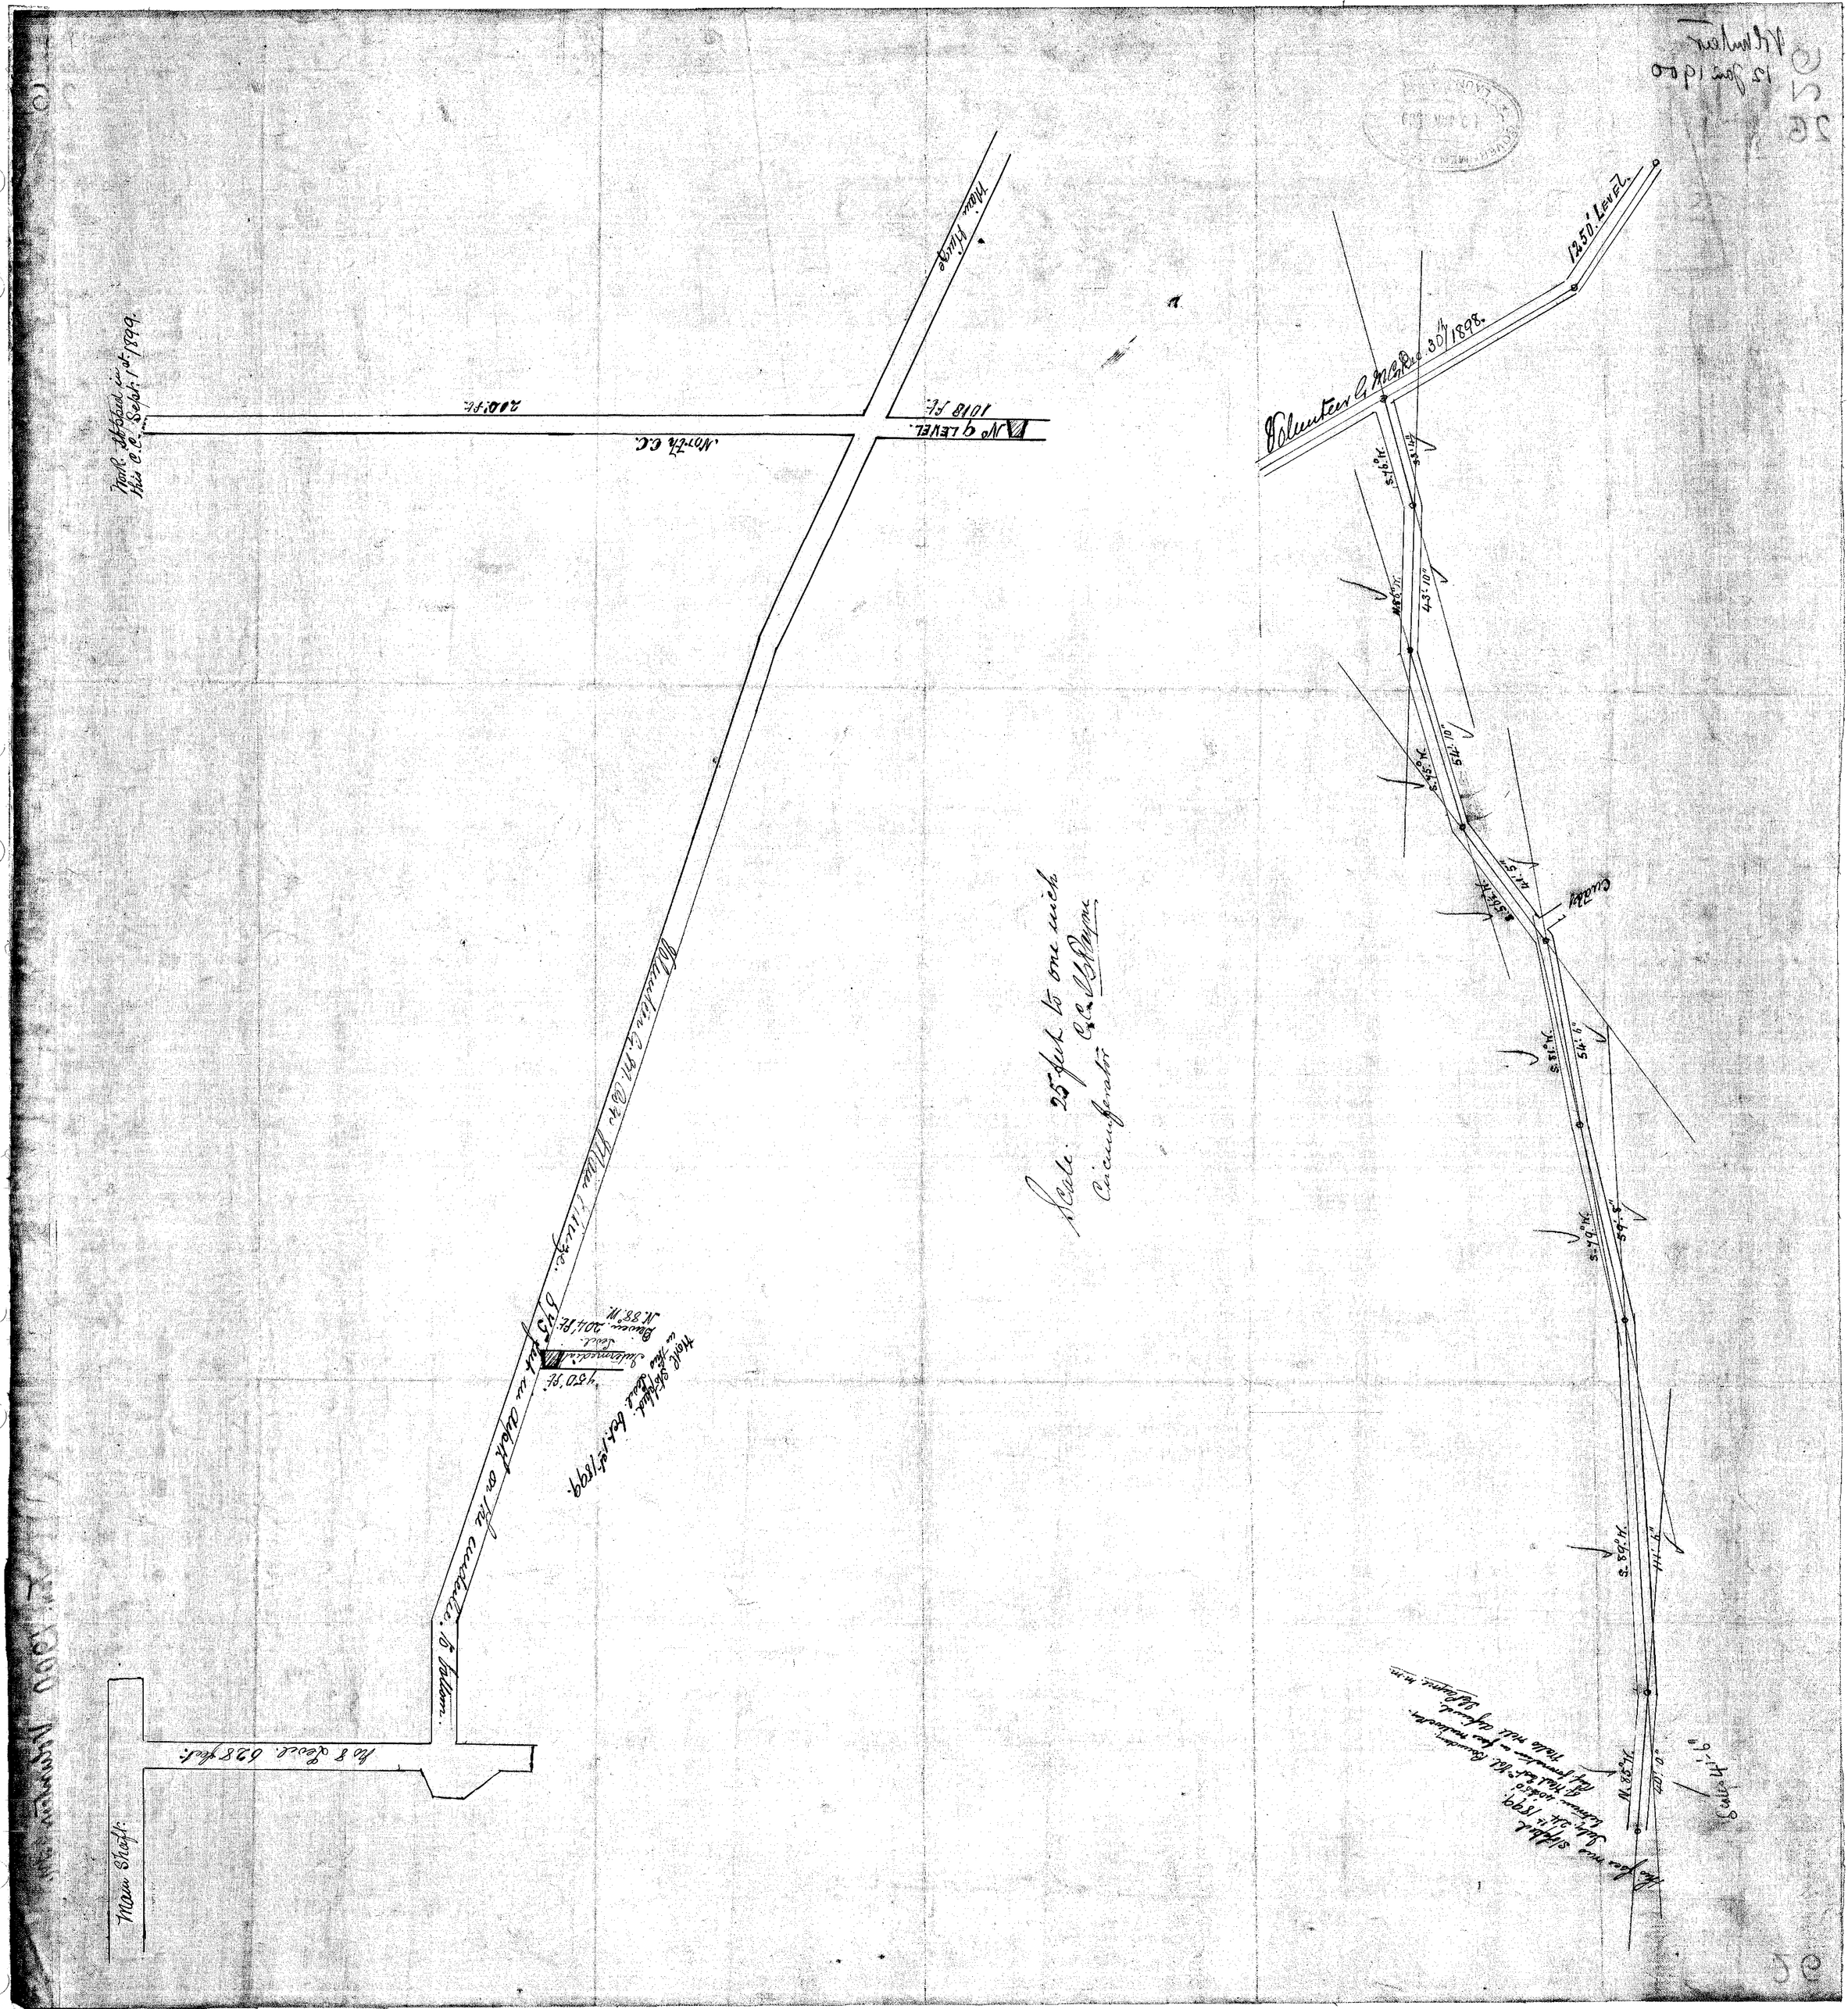
Scale: 25 feet to one inch
C. C. Schlepper
Circulating Engineer
Volunteer G. M. & R. Co. 30th 1898.
1250 Level.
Main Shaft.
No 8 Level. 628 feet.
Old Workings Pr. Water Ways.
Hole 8 feet in depth on the contact of bottom.
Hole 8 feet in depth. Feb. 1st 1899.
450 ft.
Drove 204 ft. N 88° W
No 9 LEVEL.
1018 ft.
North E.C.
200 ft.
Hole 8 feet in his E.C. Sept. 1st 1899.
Main Stope.
Cross Cut
Hole opened in Sept. 1898.
Hole 8 feet in depth.