WEST PINAFORE G. M.

Scale 25 Feet to an Inch

Levels shown with blue side lines are copied from Mr Watchorn's plan of July 1892

Measurements are in links except No 1 level
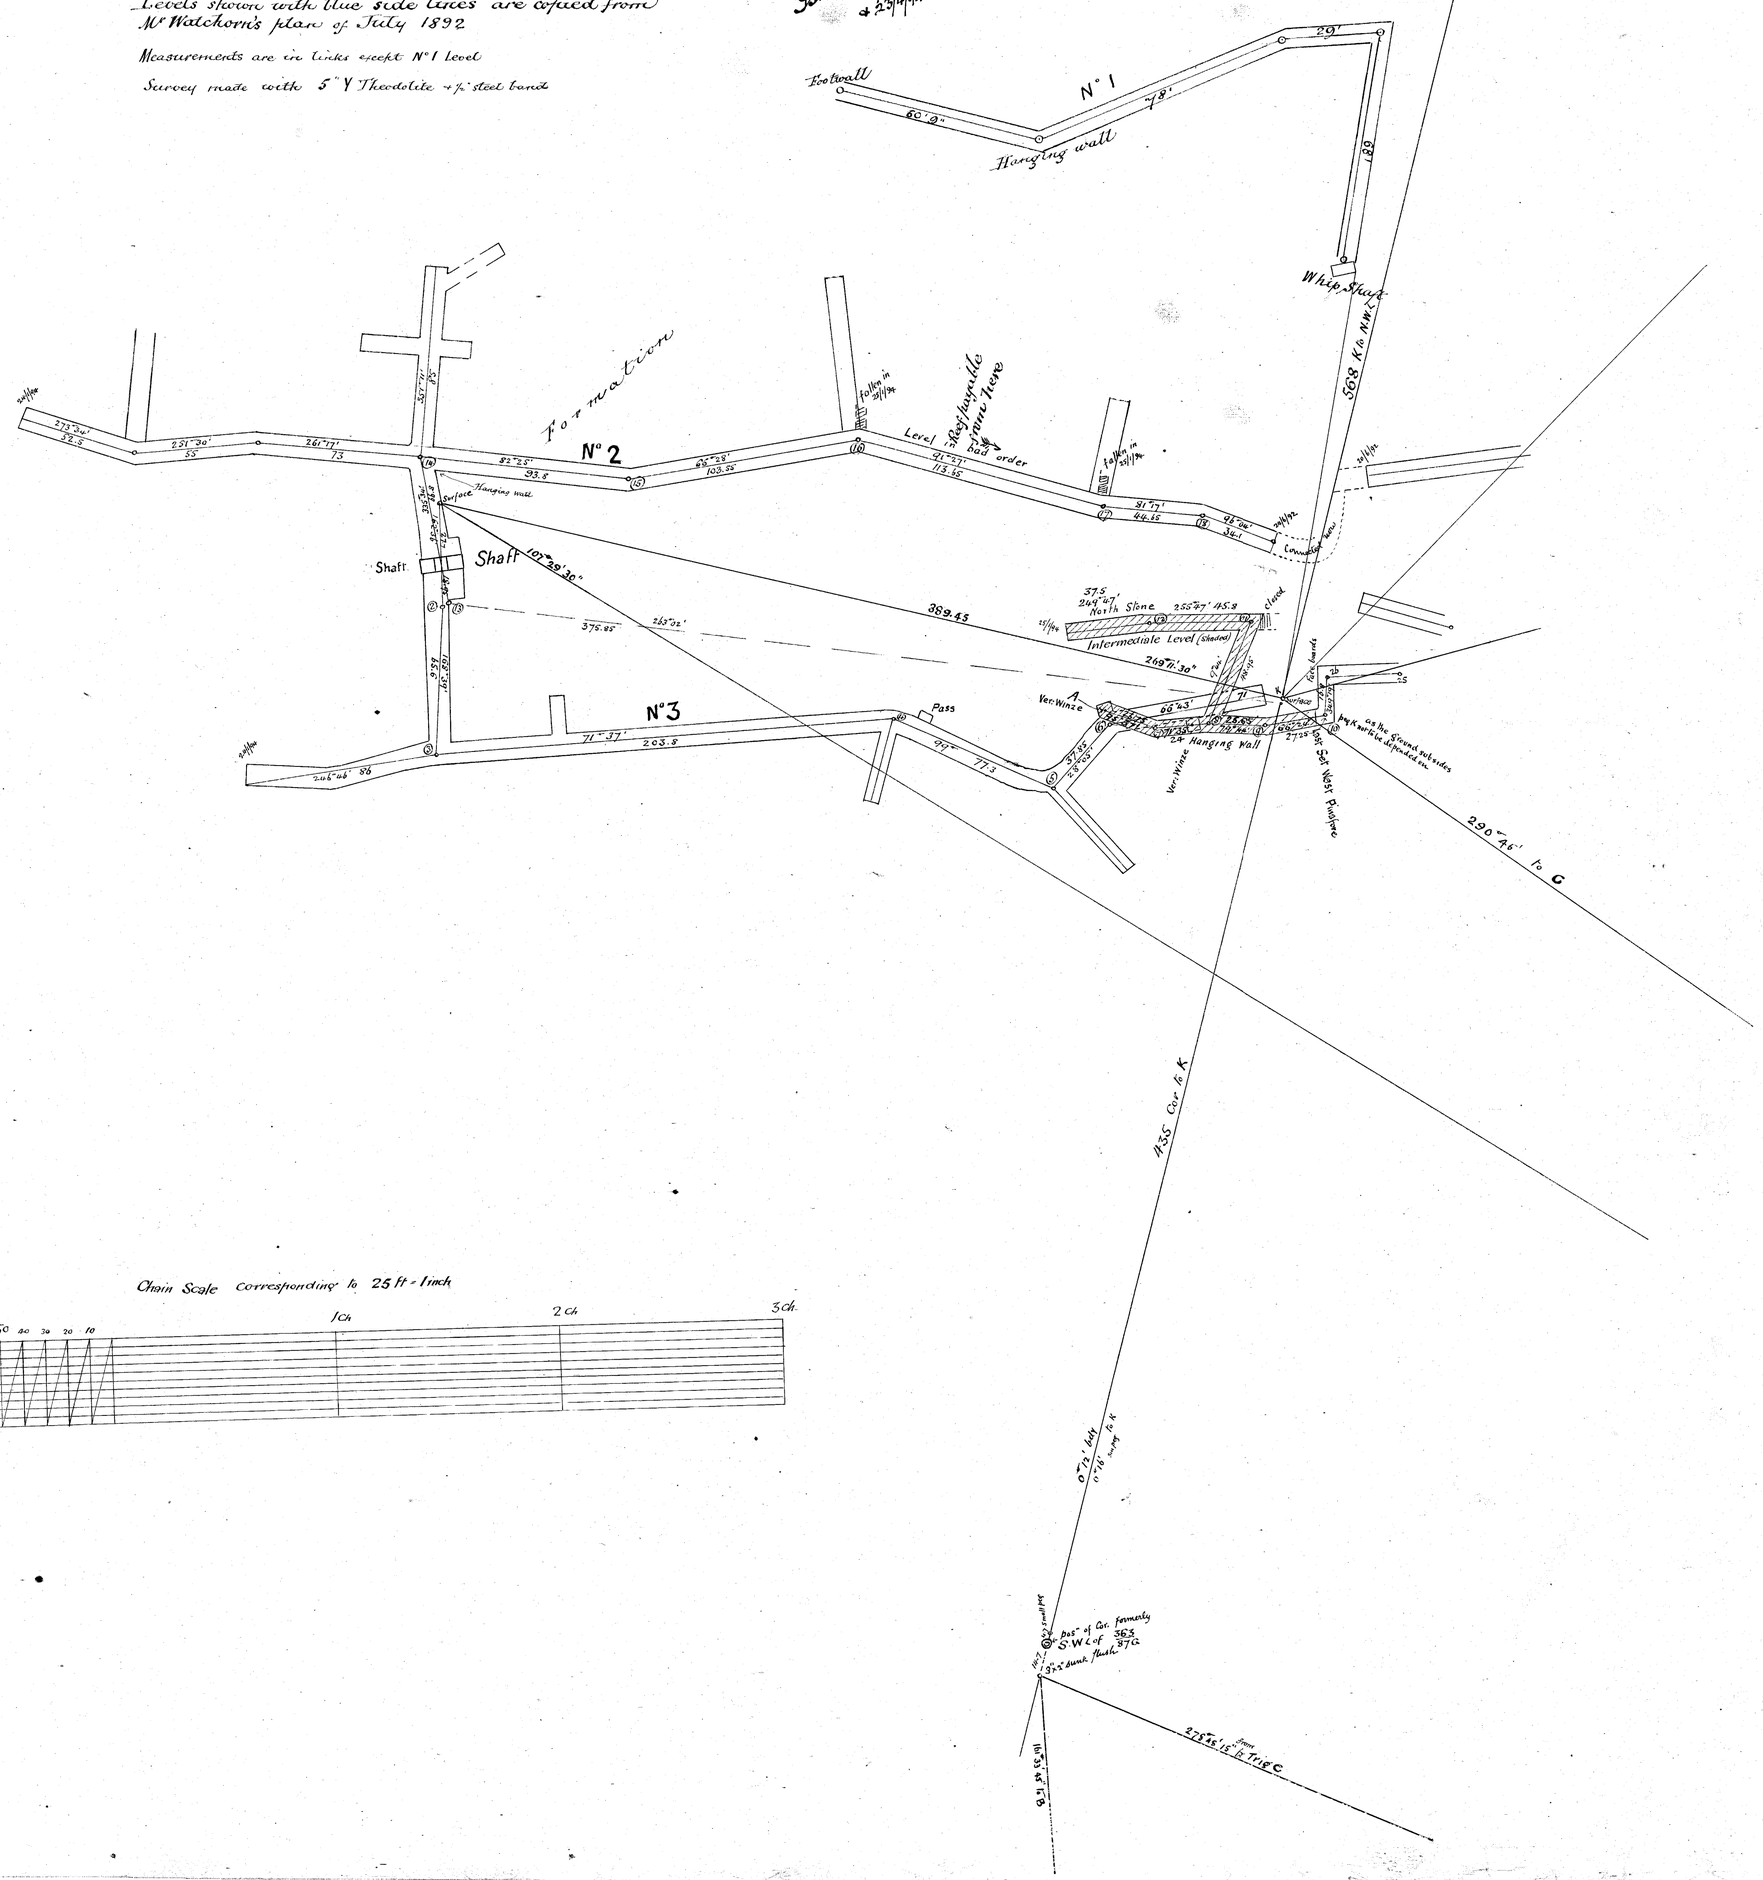
Survey made with 5" Y Theodolite & 1/2" steel band