


THE TASMANIA CROWN, LIMITED.

Scale 30 Feet to an Inch

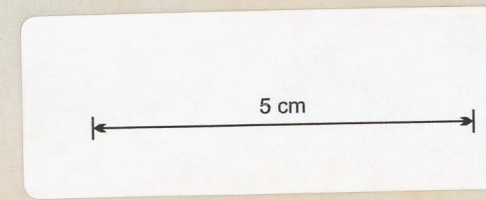

736 M



Note: Colored portions denote
work done in 1897-98

MONTANA TRIBUTE

L. P. Tully
Manager
Apr. 20/1901