


5 cm

LONGITUDINAL SECTION

MAIN LODE

SCALE 30 FEET TO 1 INCH

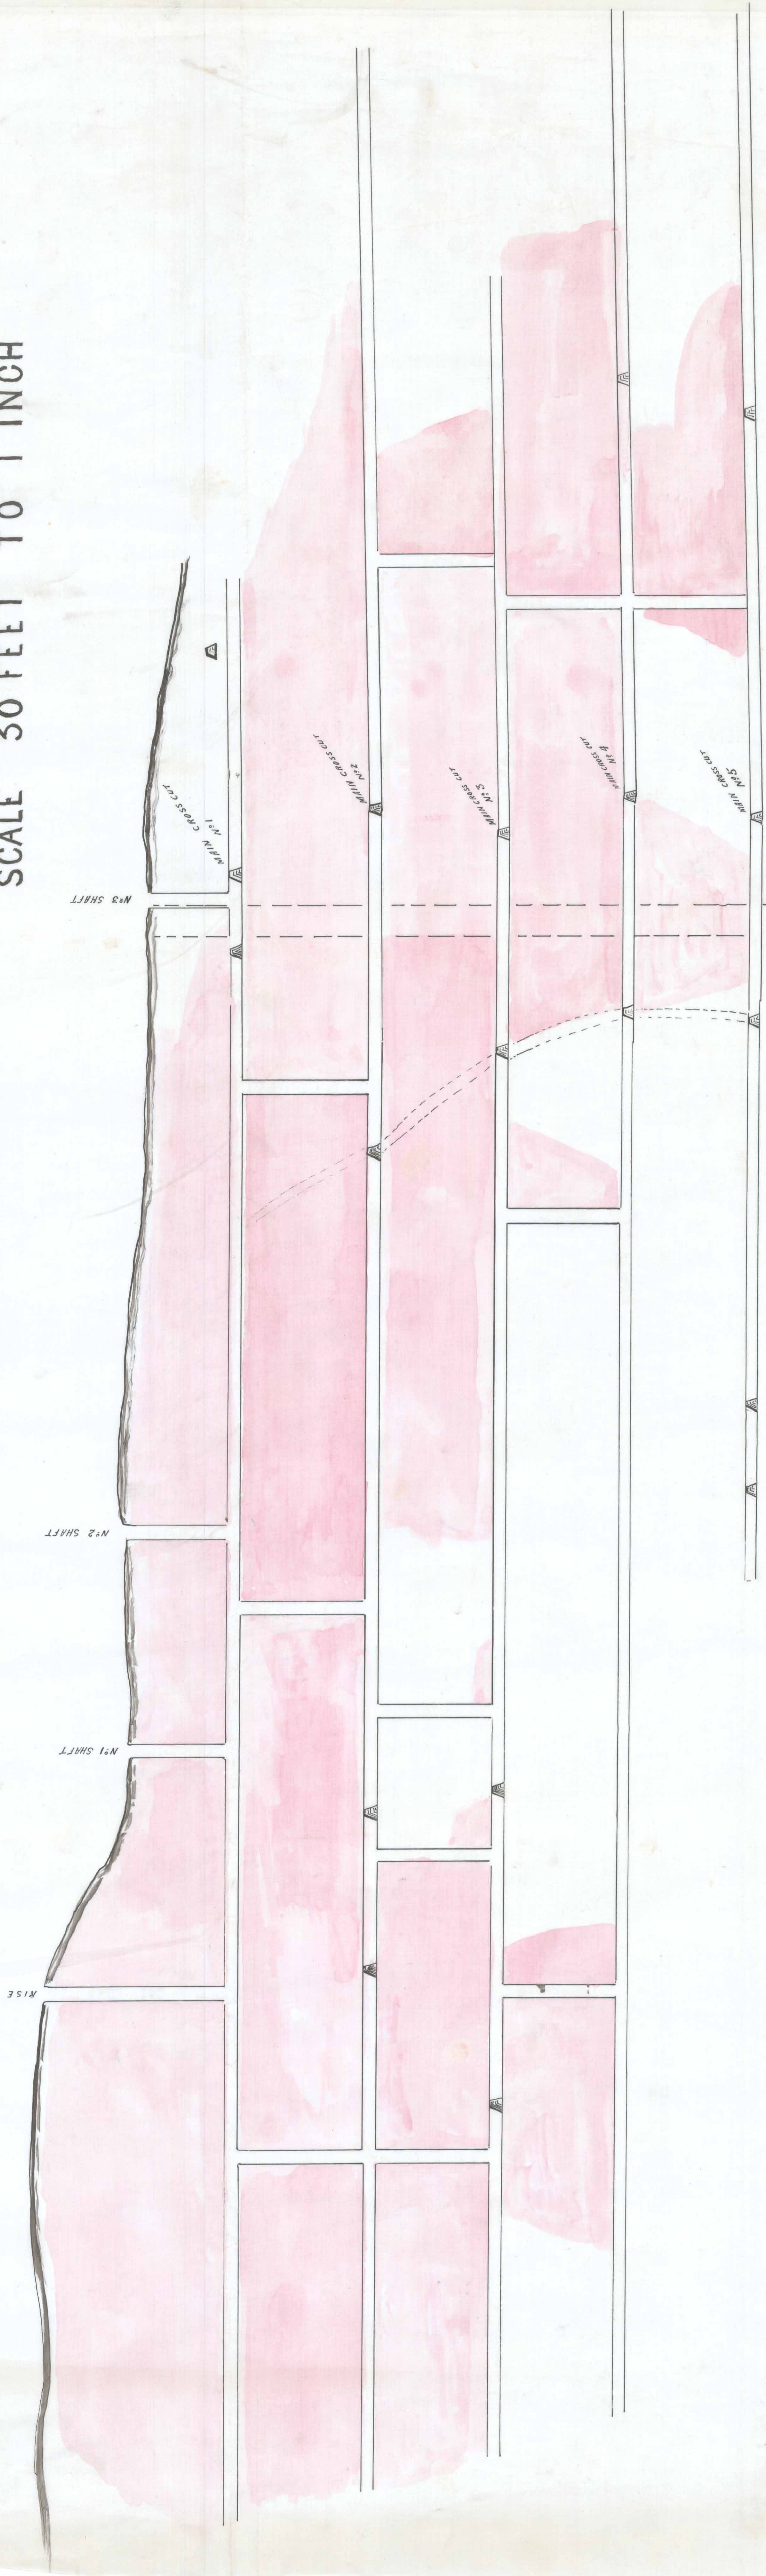

M
A
I
N
S
H
A
F
T

2 MAY 1980
LITHO

MAIN CROSS CUT
No 8

MAIN CROSS CUT
No 7

MAIN CROSS CUT
No 6