


2

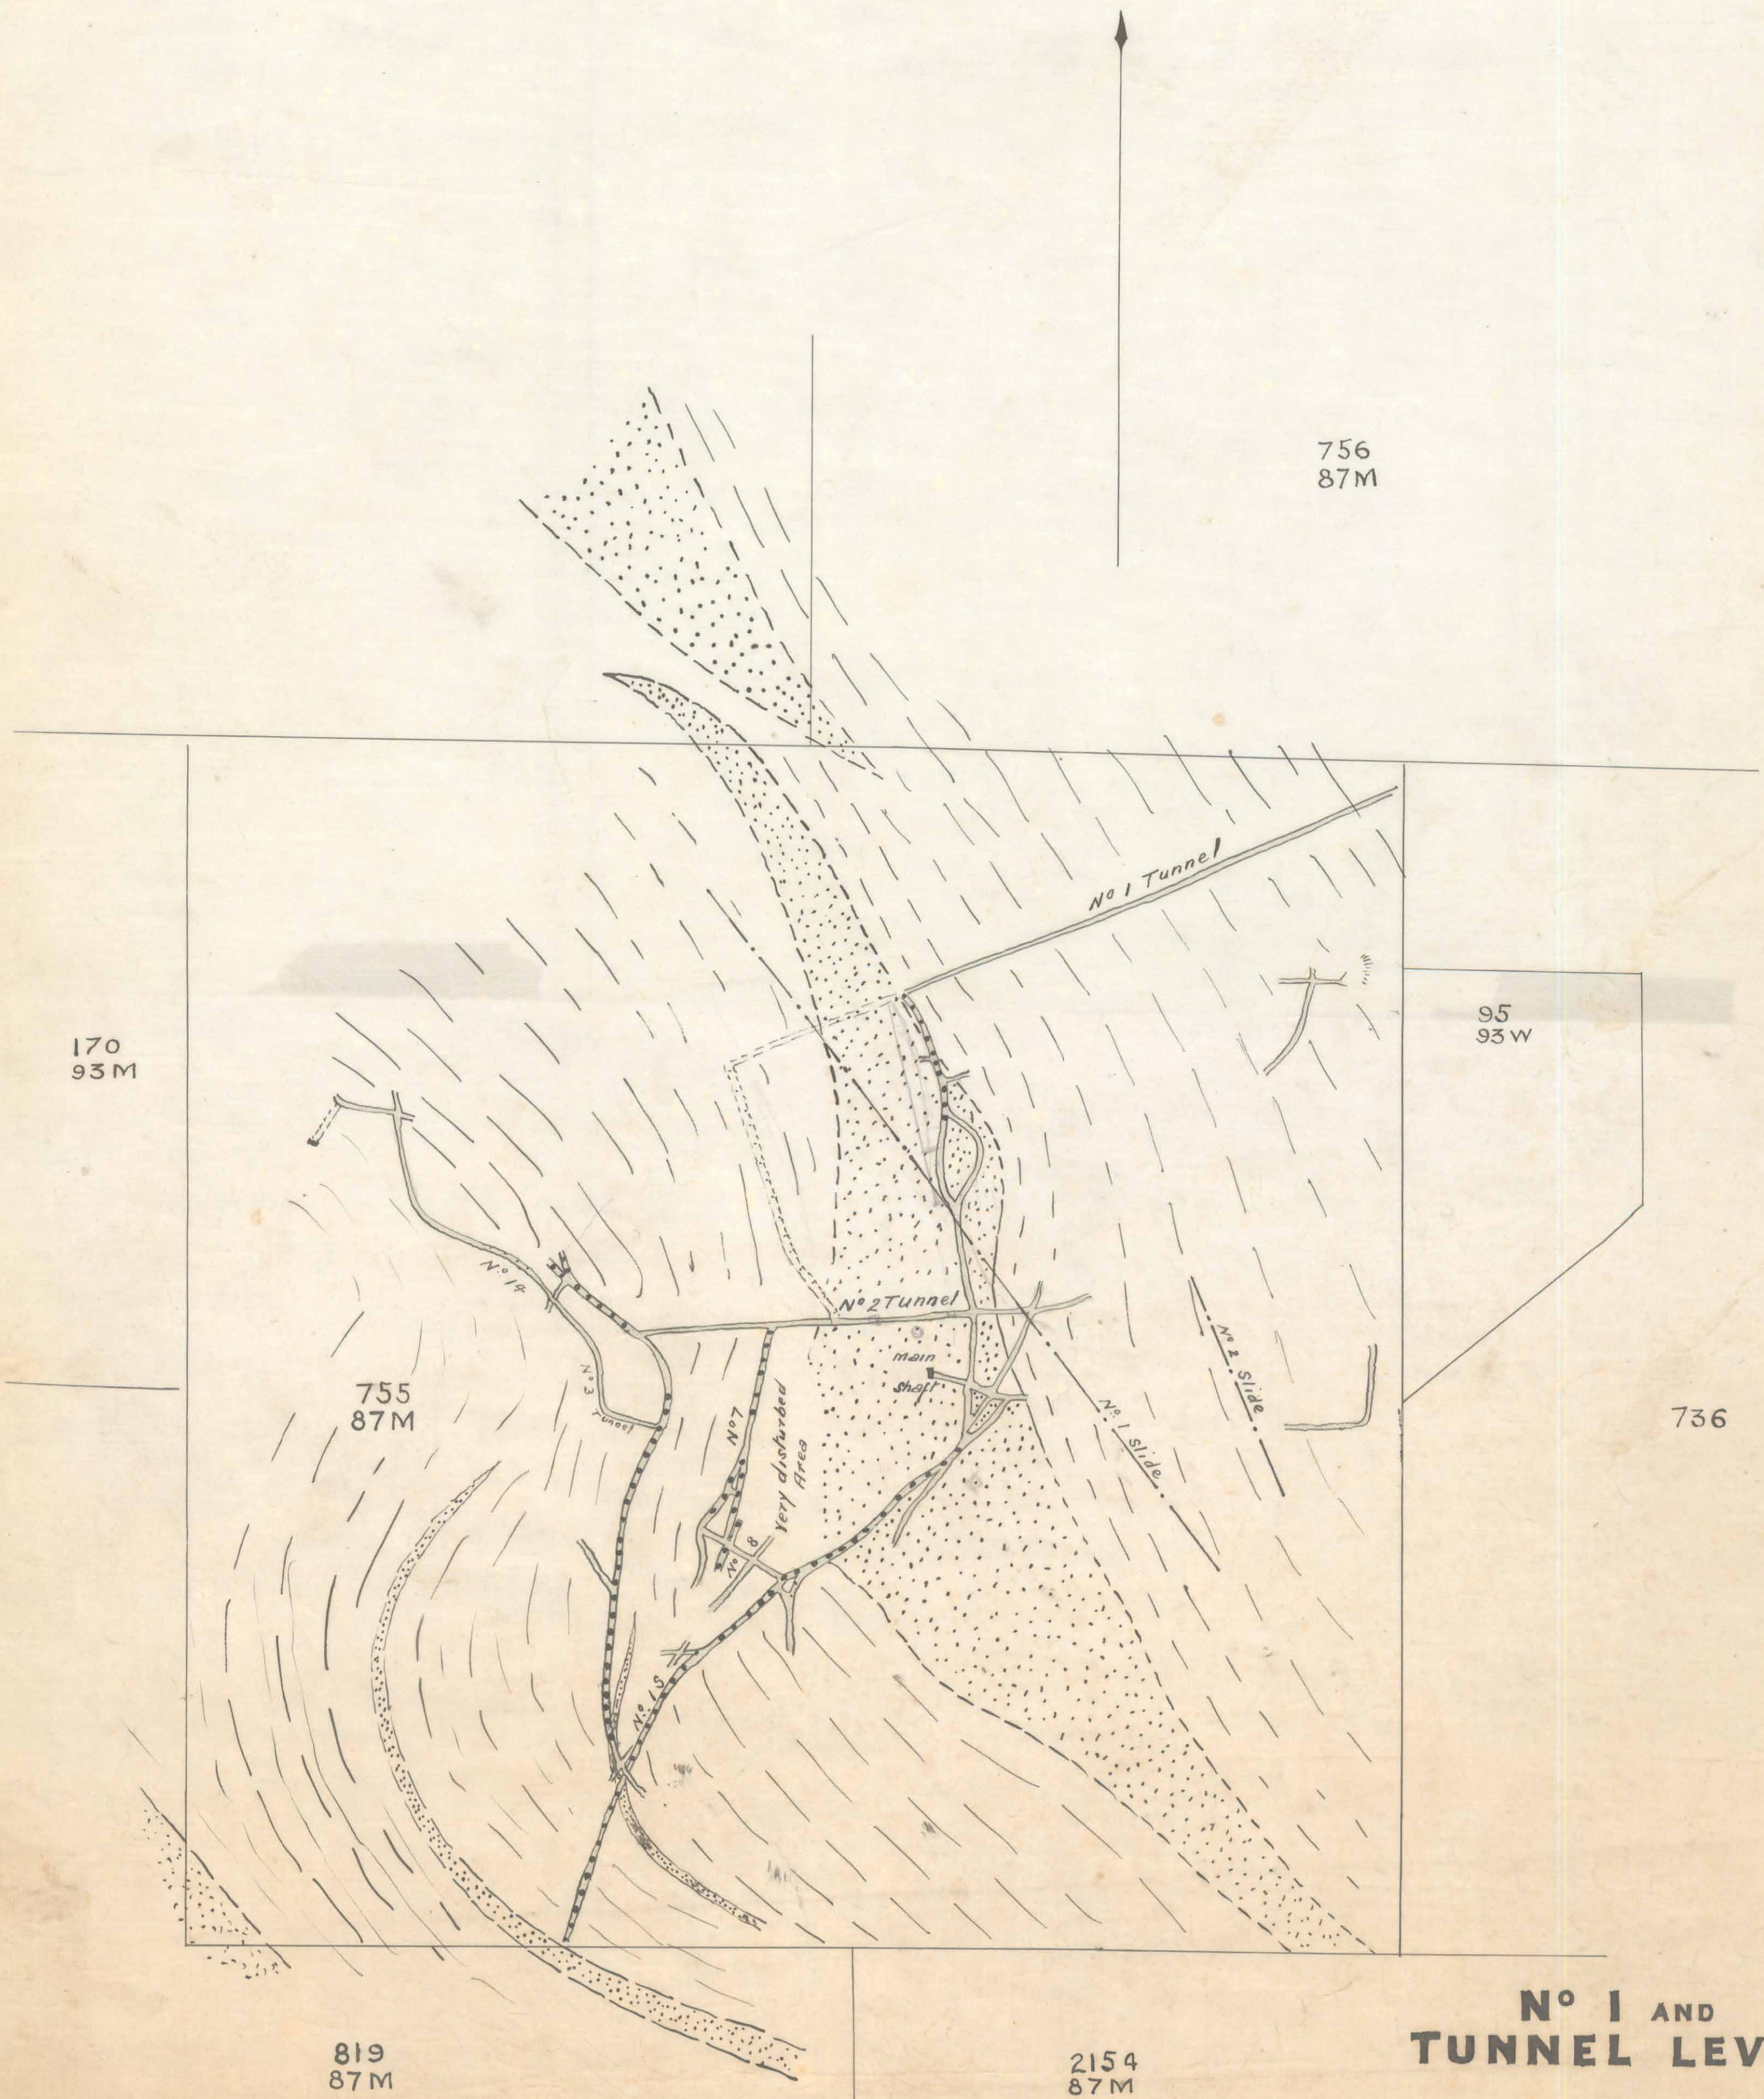

Nº 1 AND
TUNNEL LEVELS