


5 cm

44

LONGITUDINAL SECTION

WEST LODE

SCALE 30 FEET TO AN INCH

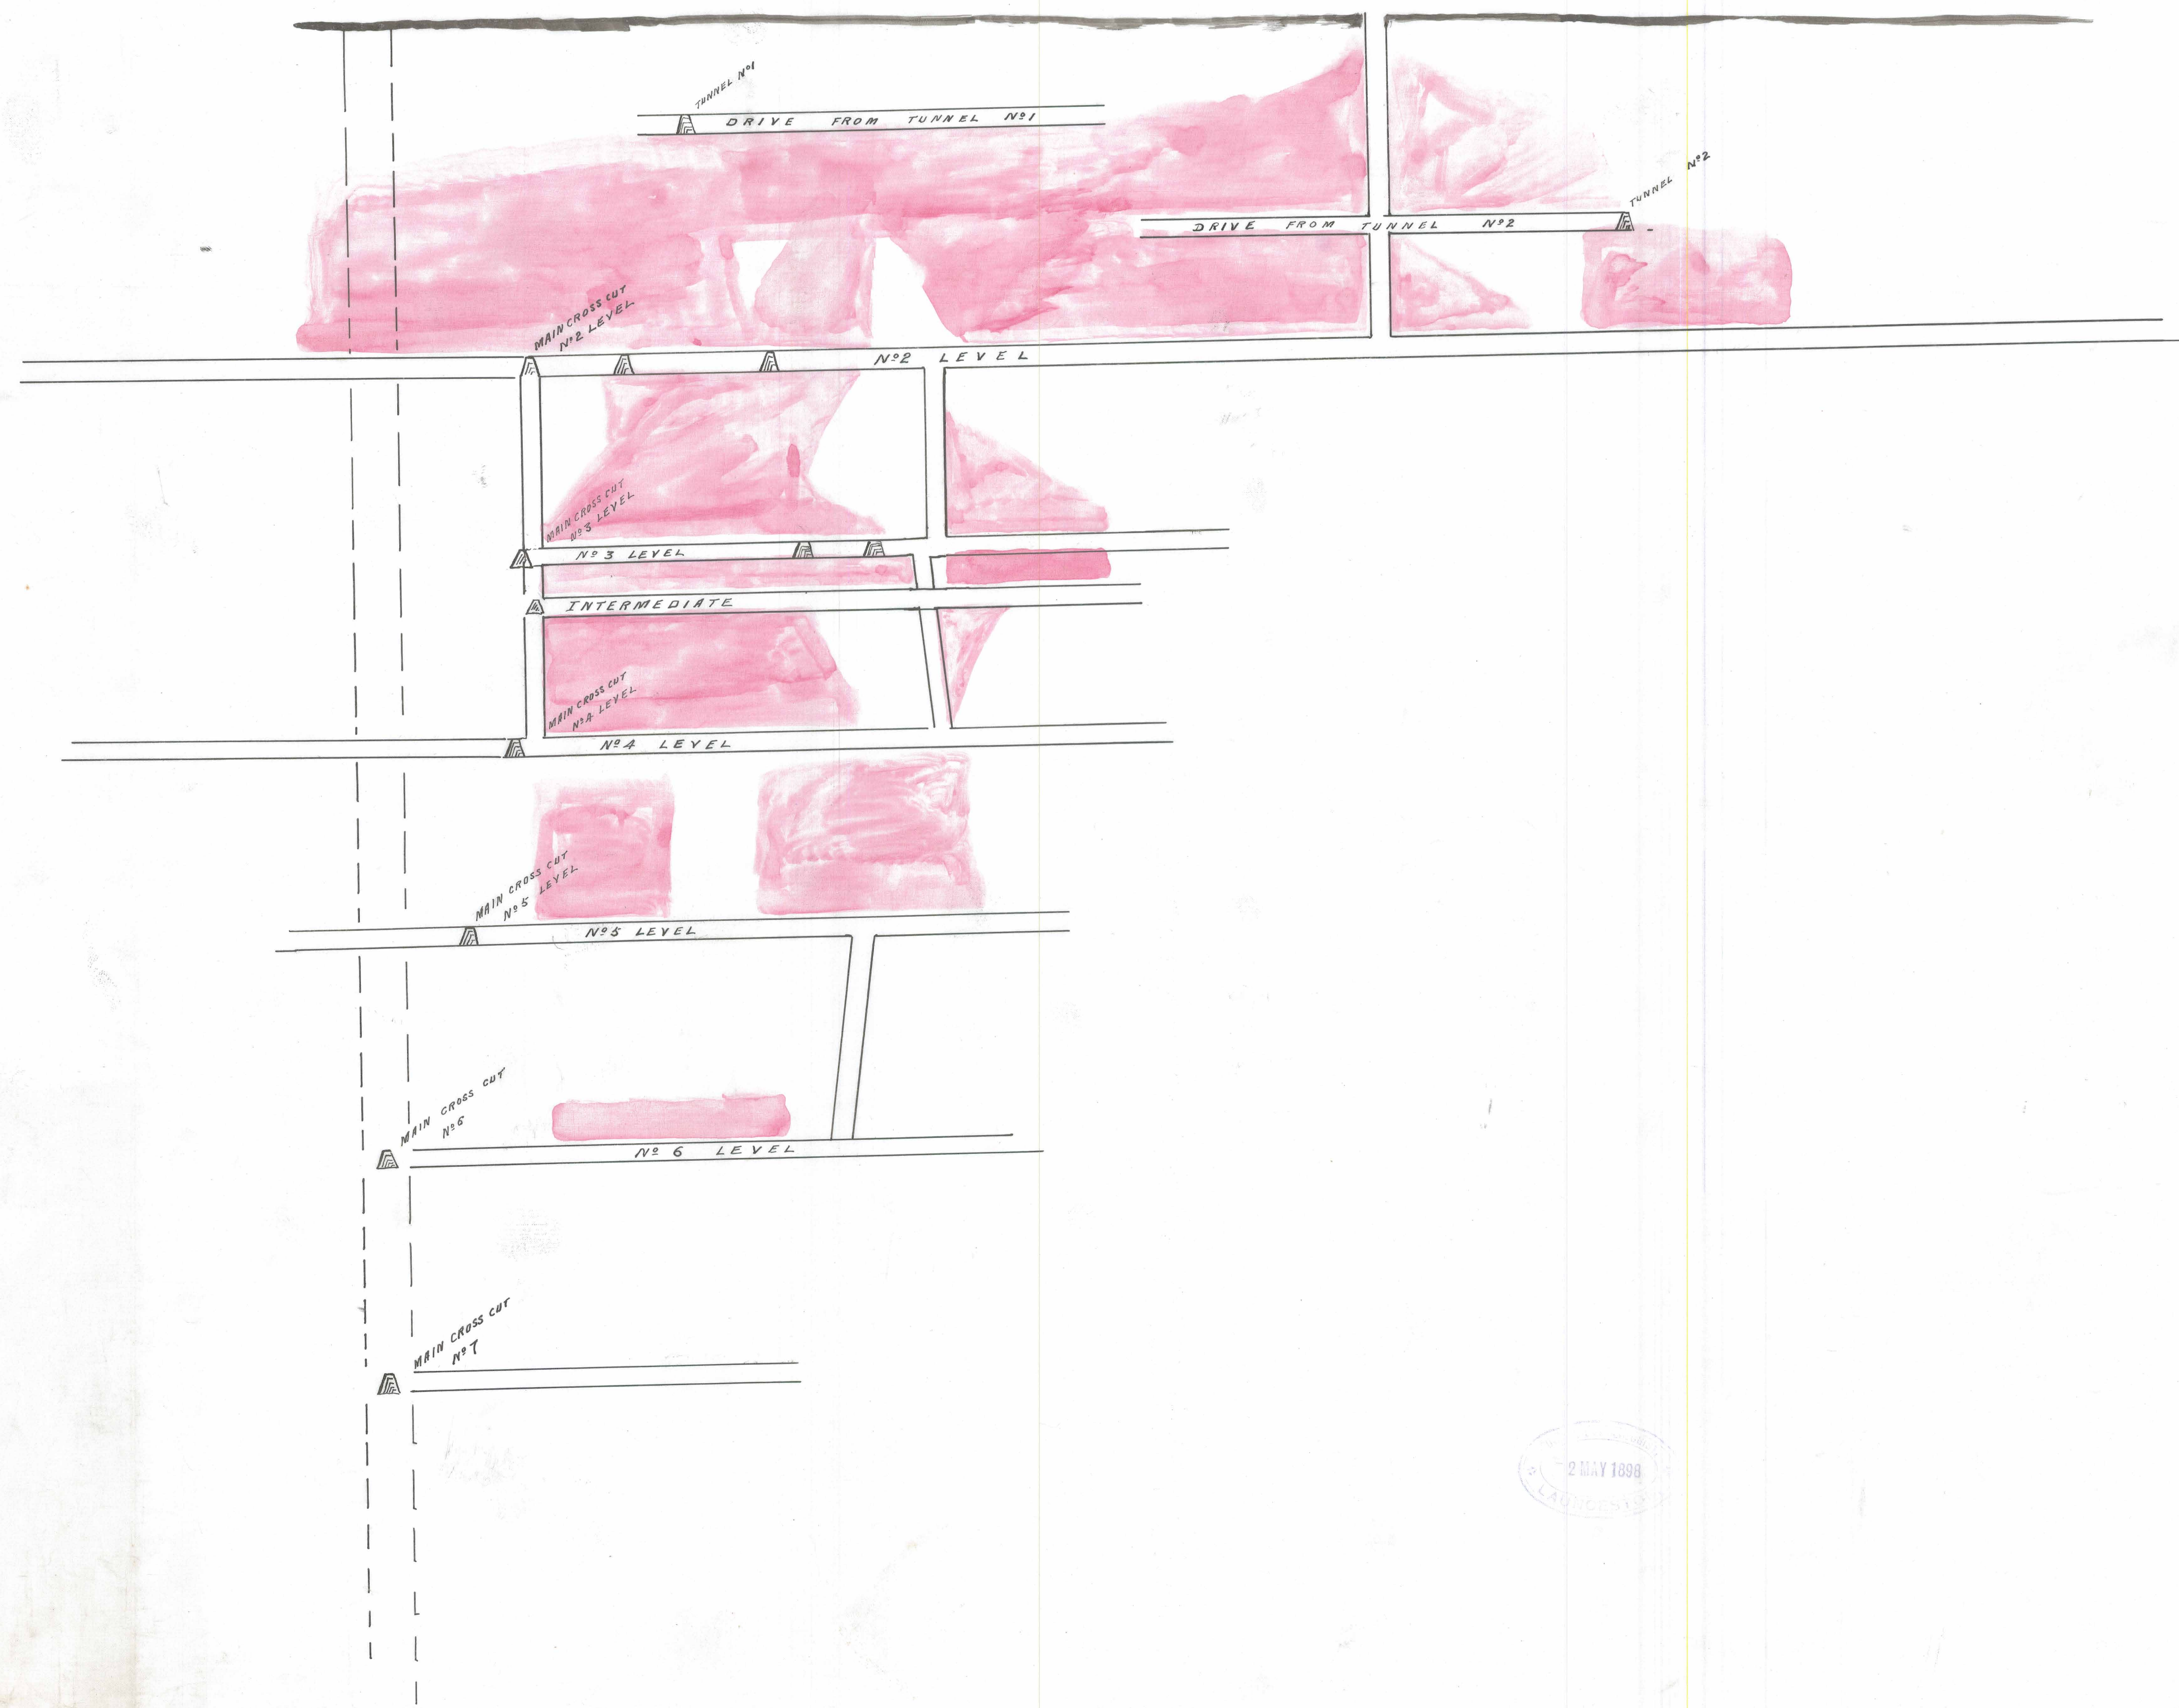

2 MAY 1898

47