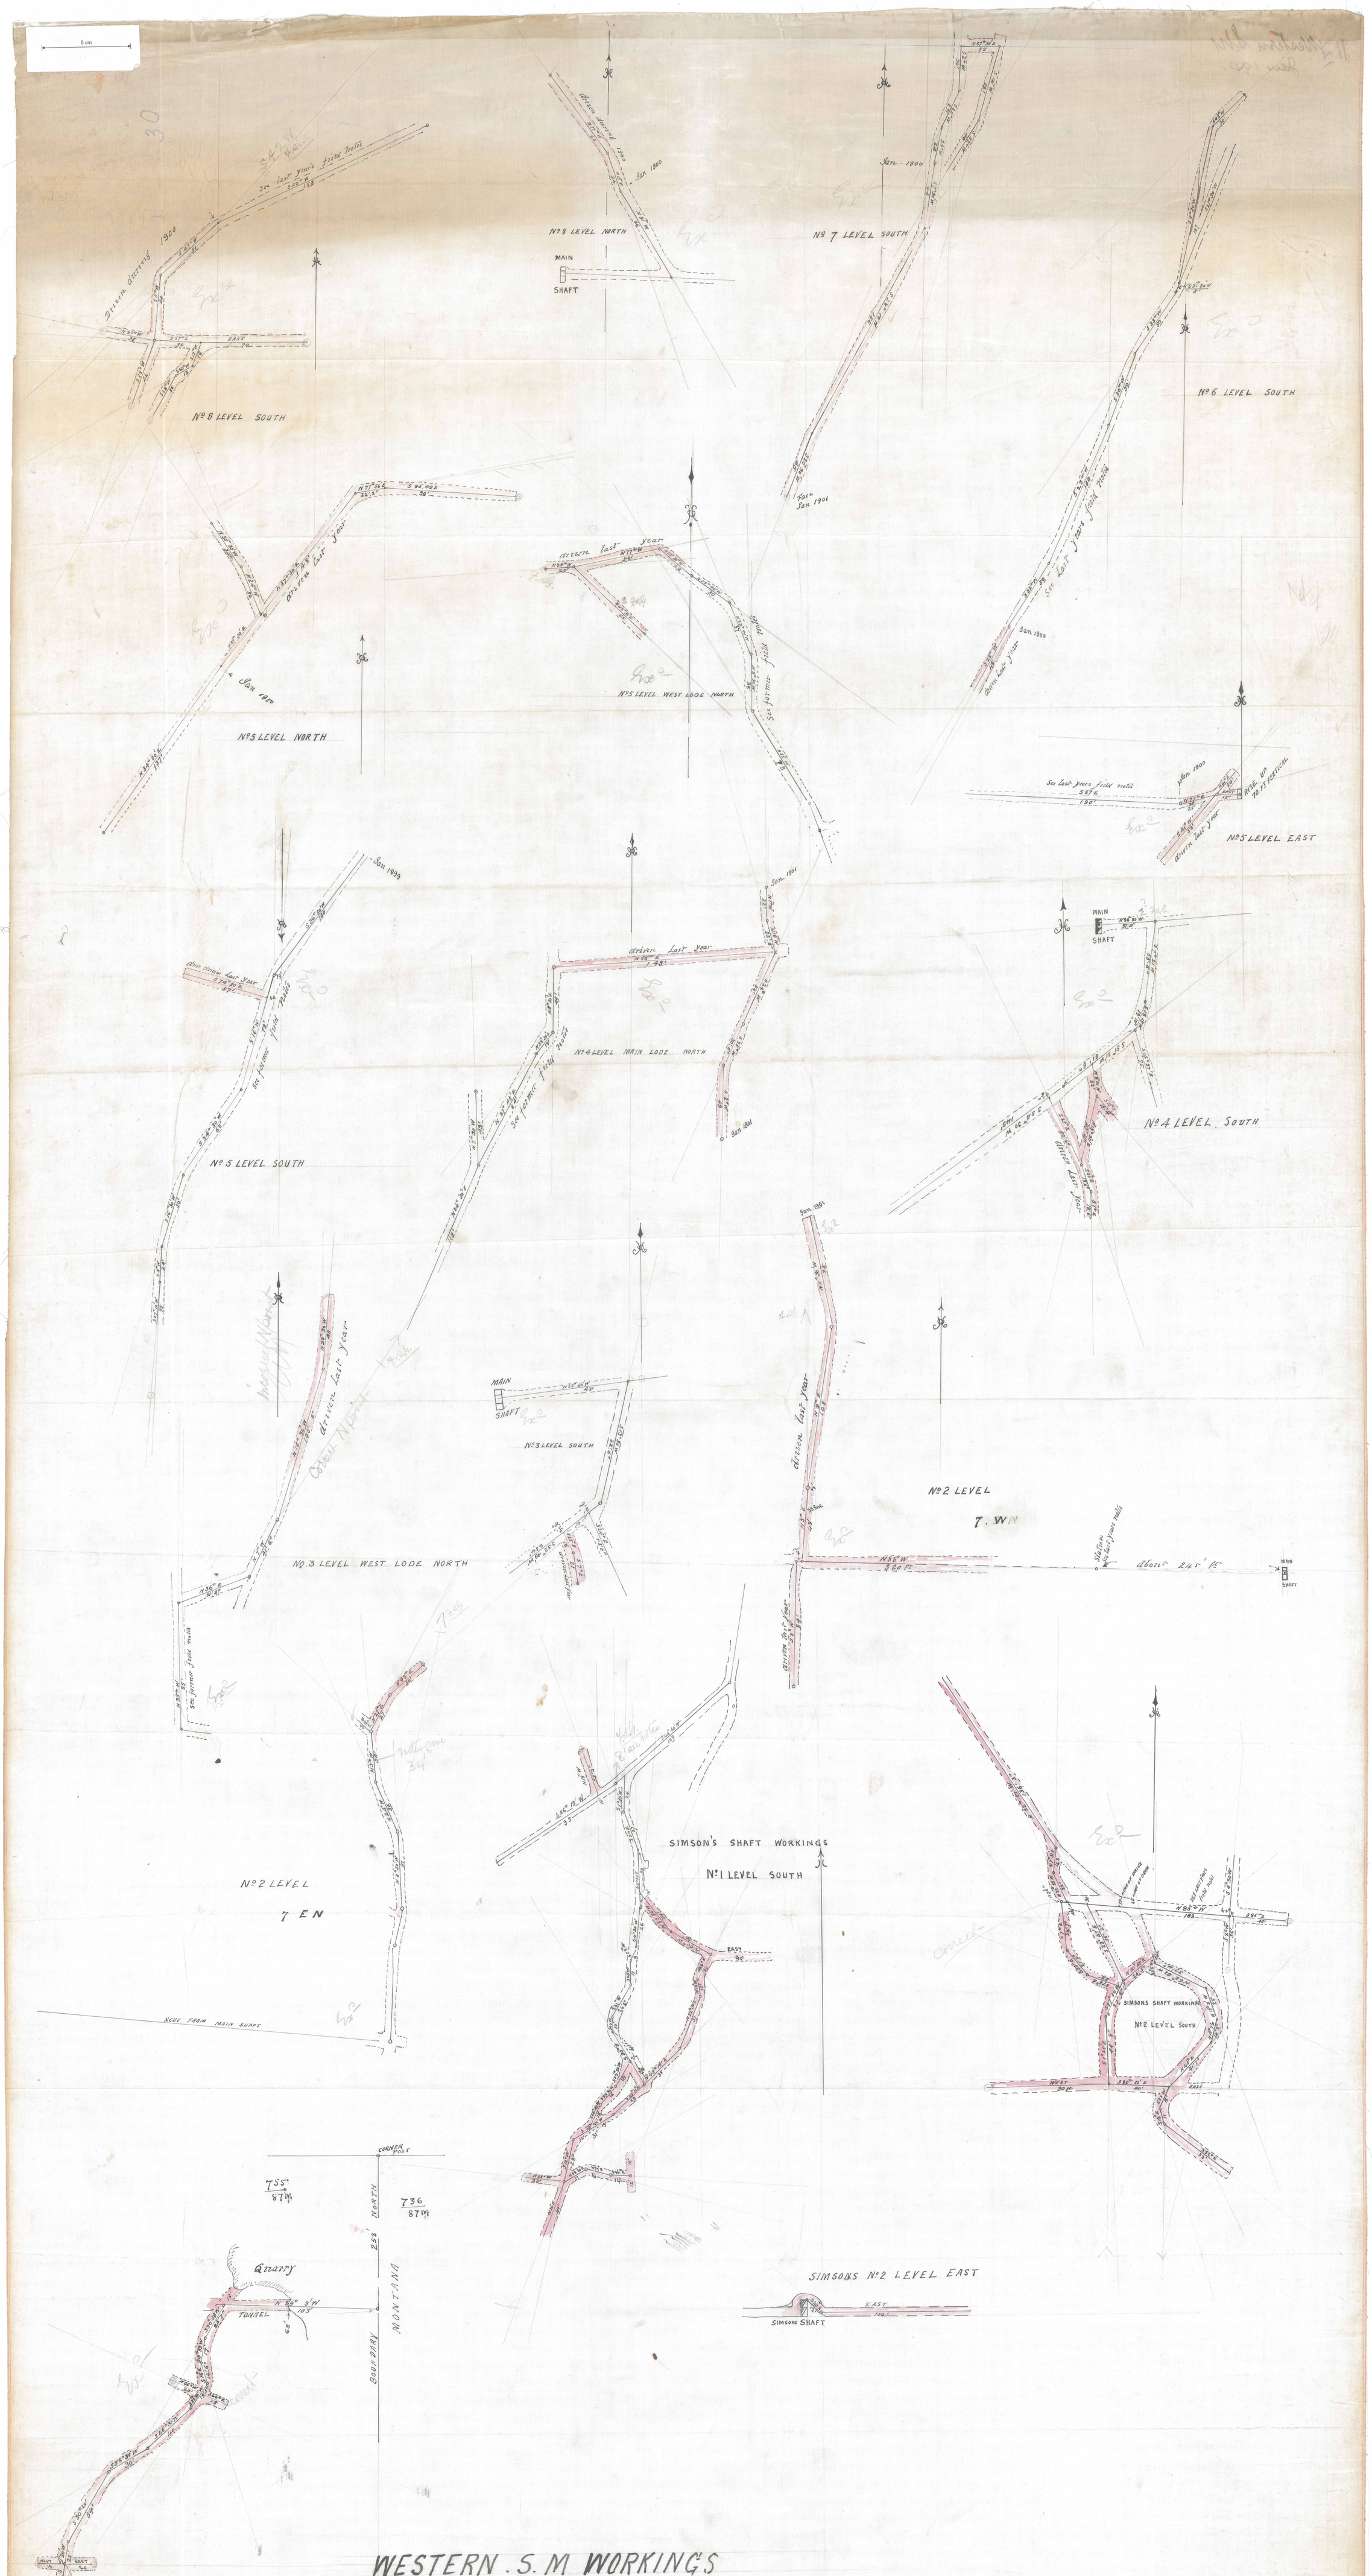

WESTERN. S. M WORKINGS

Year ending Jan 1901

Scale 30 feet to an Inch

W. R. Sale

Authorised Surveyor