


5 cm

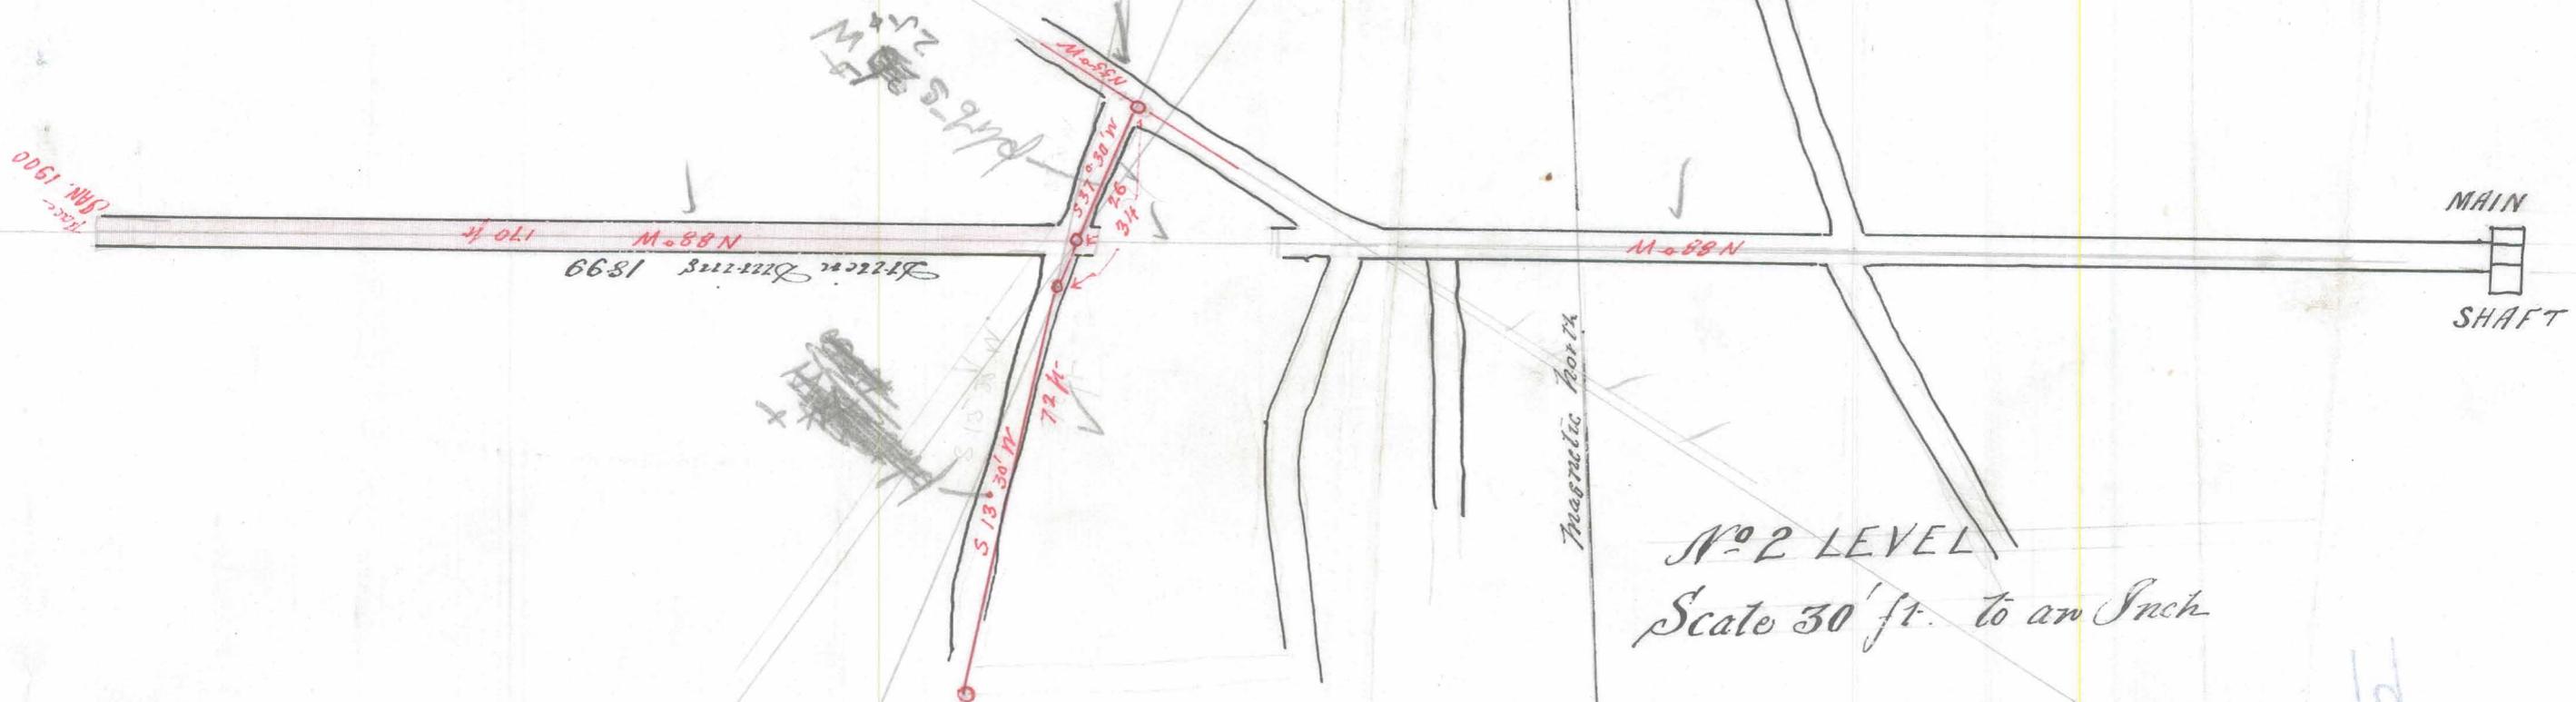

No. 2 LEVEL
Scale 30' ft. to an Inch

10