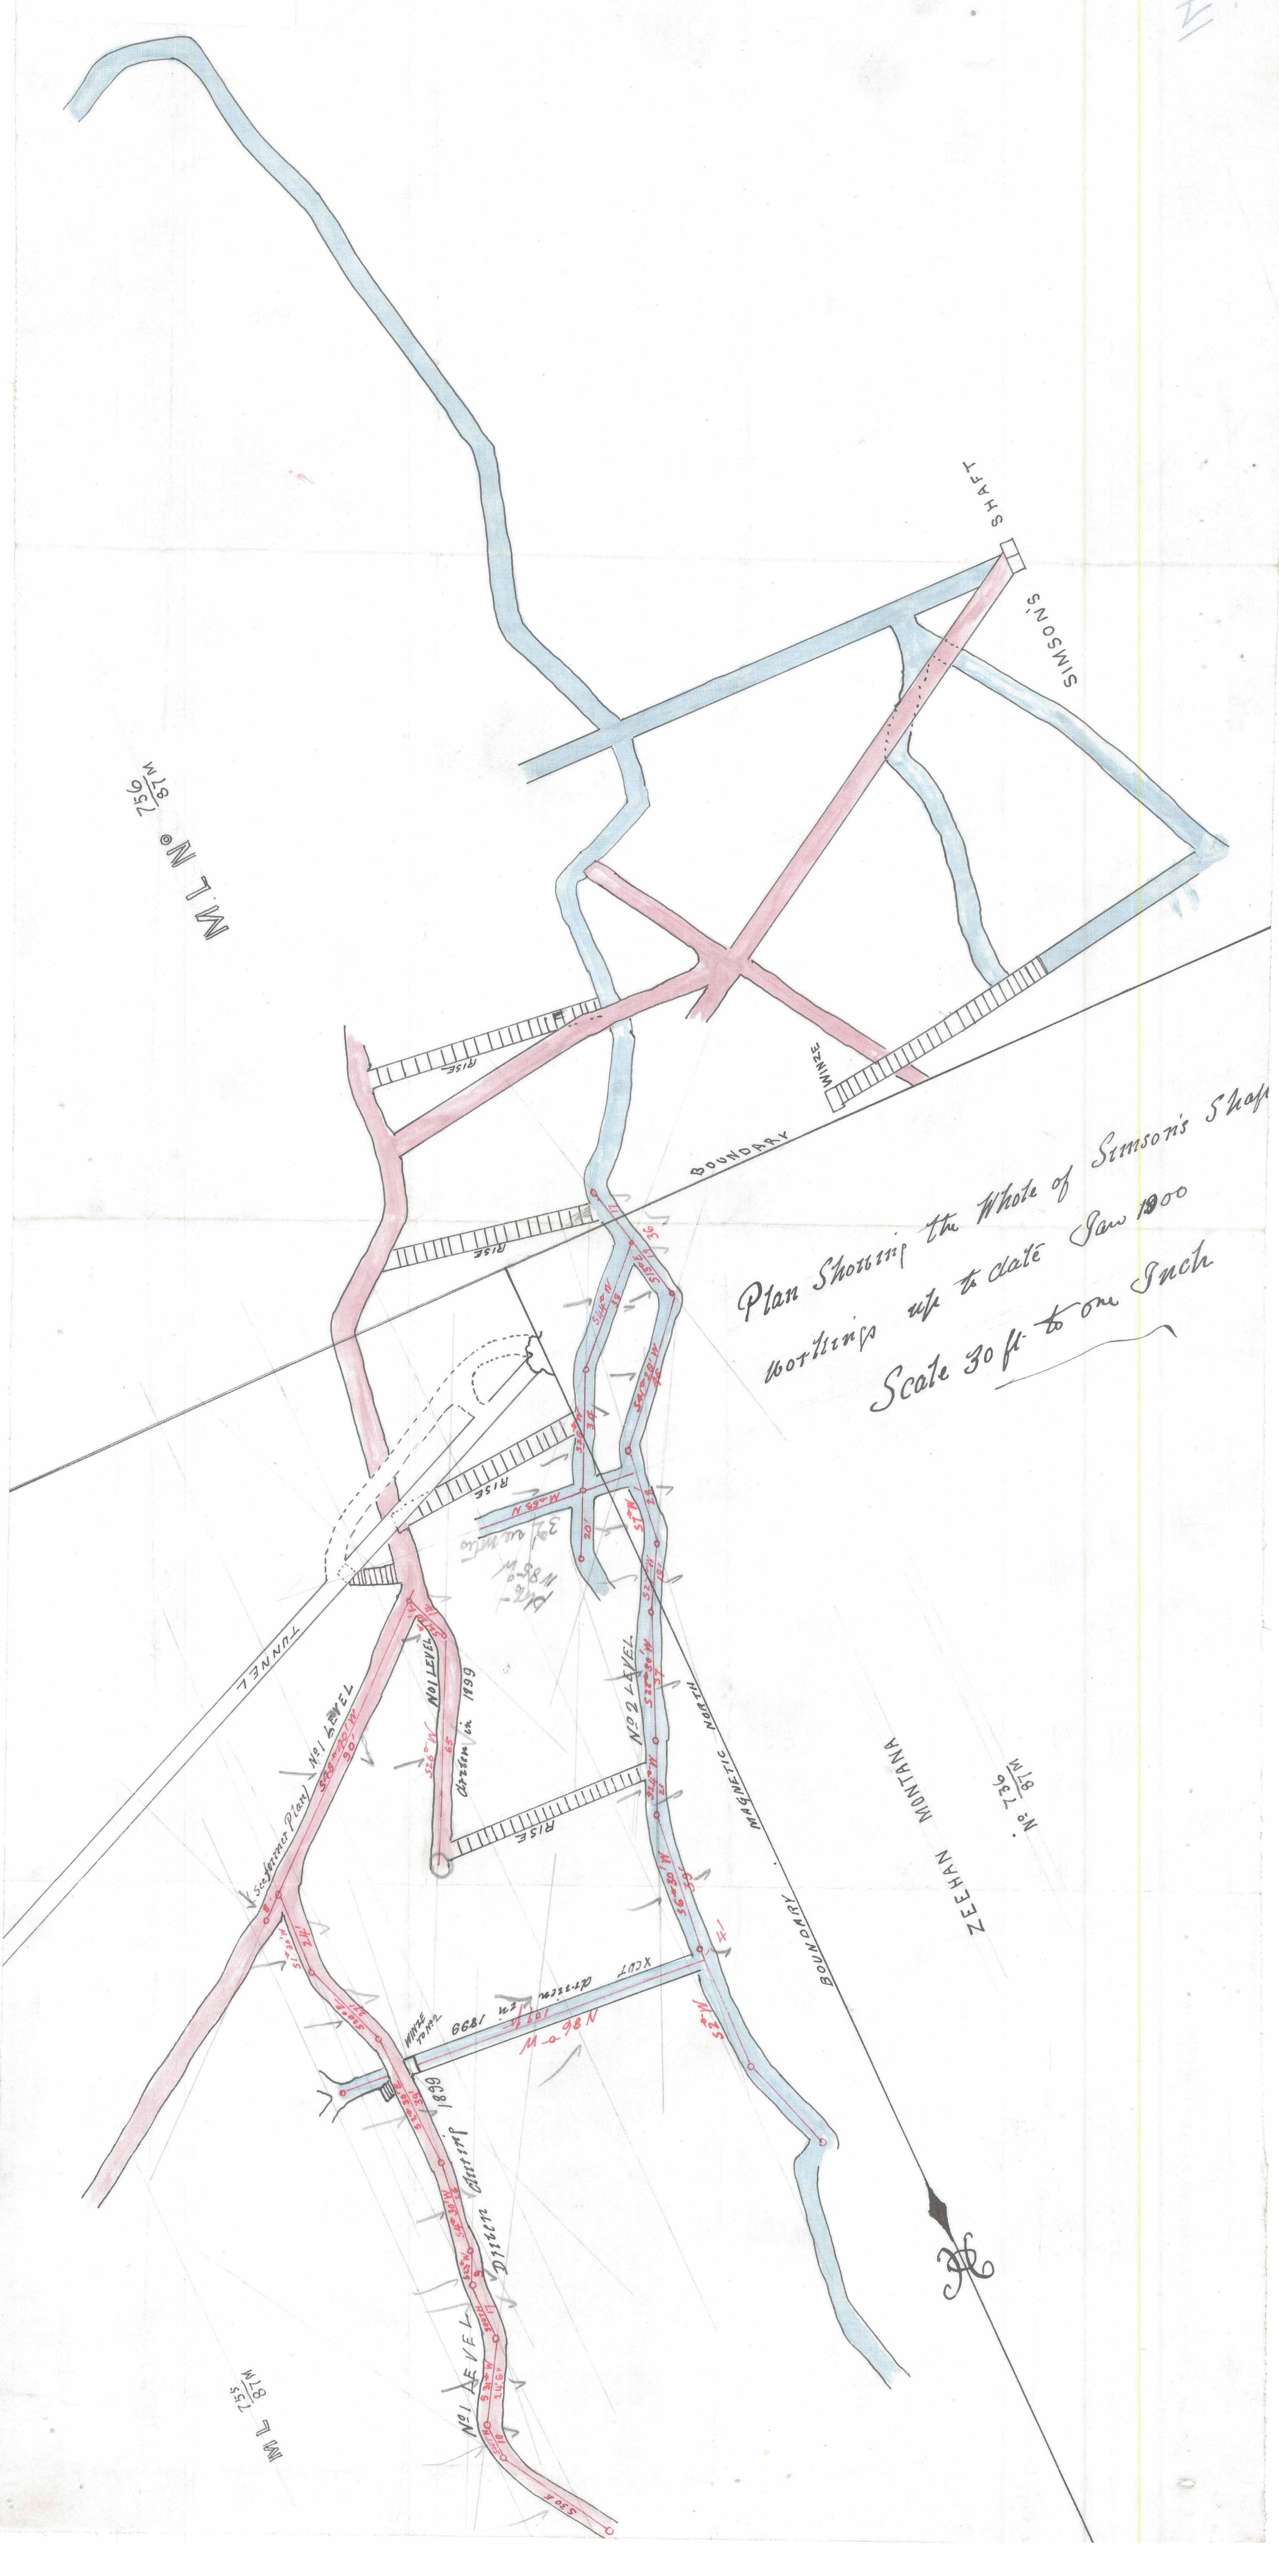
Plan Showing the Whole of Simson's Shaft
workings up to date Jan 1900
Scale 30 ft to one Inch
SIMSON'S SHAFT
WINZE
BOUNDARY
RISE
RISE
RISE
RISE
TUNNEL
No1 LEVEL
No1 LEVEL
No1 LEVEL
No2 LEVEL
Driven in 1899
XCUT
WINZE TO No2
MAGNETIC NORTH
BOUNDARY
ZEEHAN MONTANA
No 736/87M
ML No 756/87M
ML 755/87M