1893

— PLAN —

OF

— UNDERGROUND WORKS —

— WESTERN SILVER MINING COMPANY NO LIABY. —

Scale. 30 feet to 1 inch.

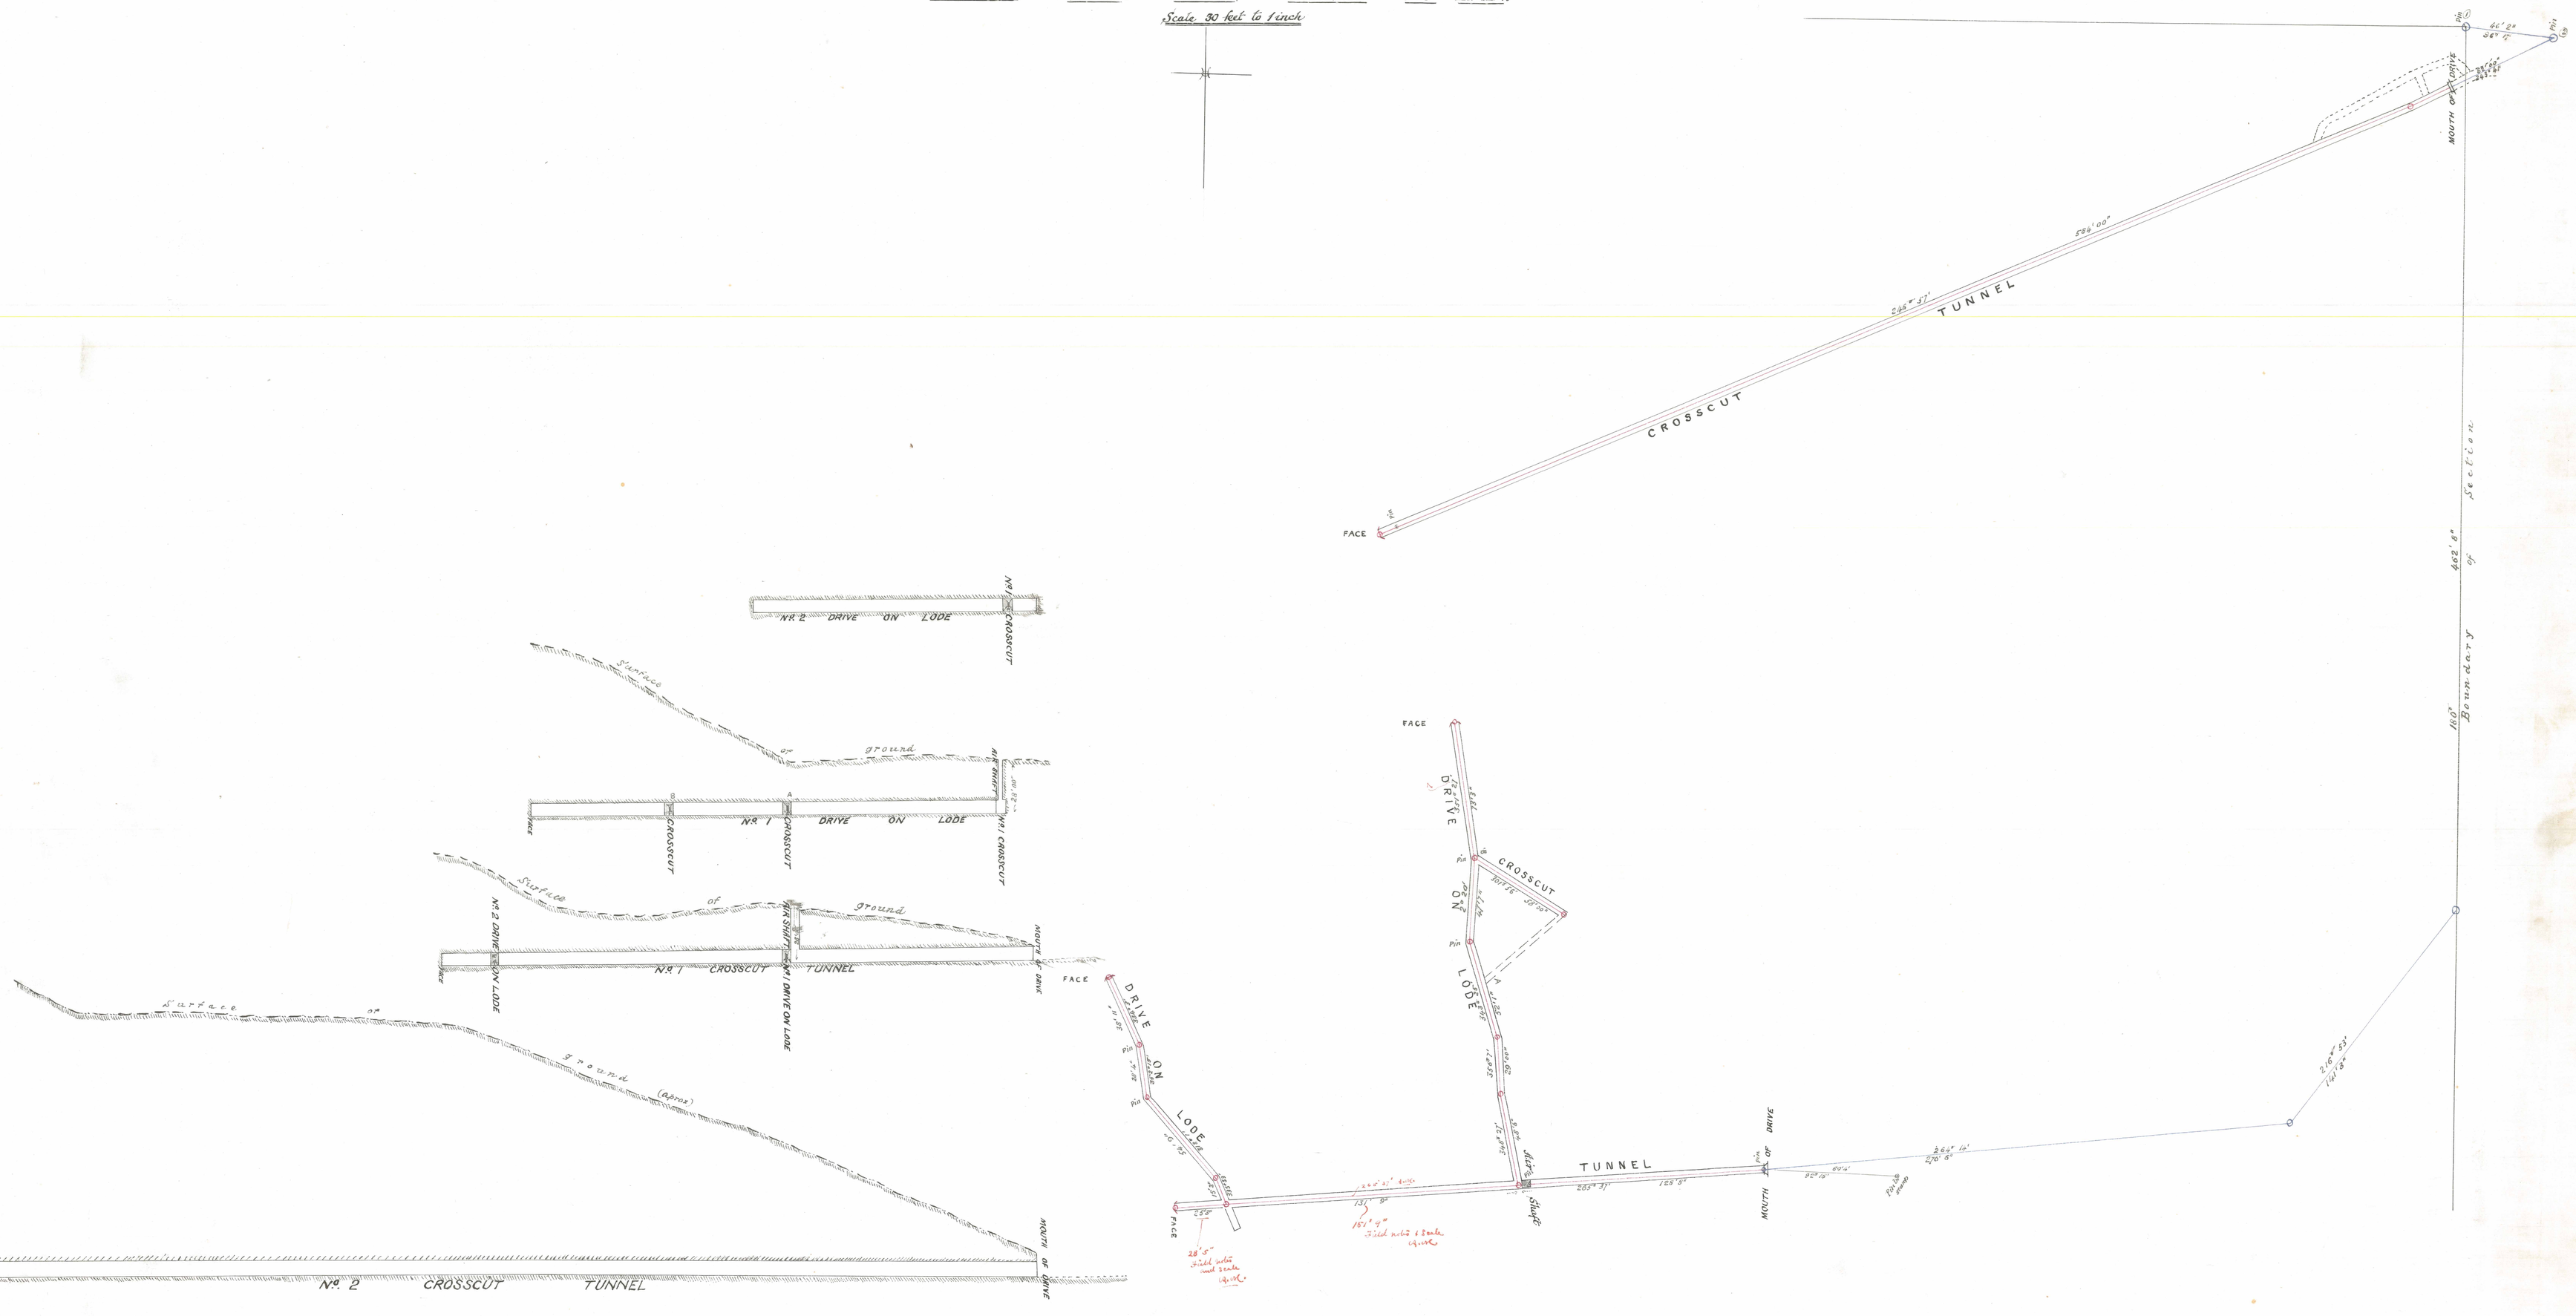

Chas Lowe
Auto Surveyor
Mt Leckan
January

1893