



5 cm

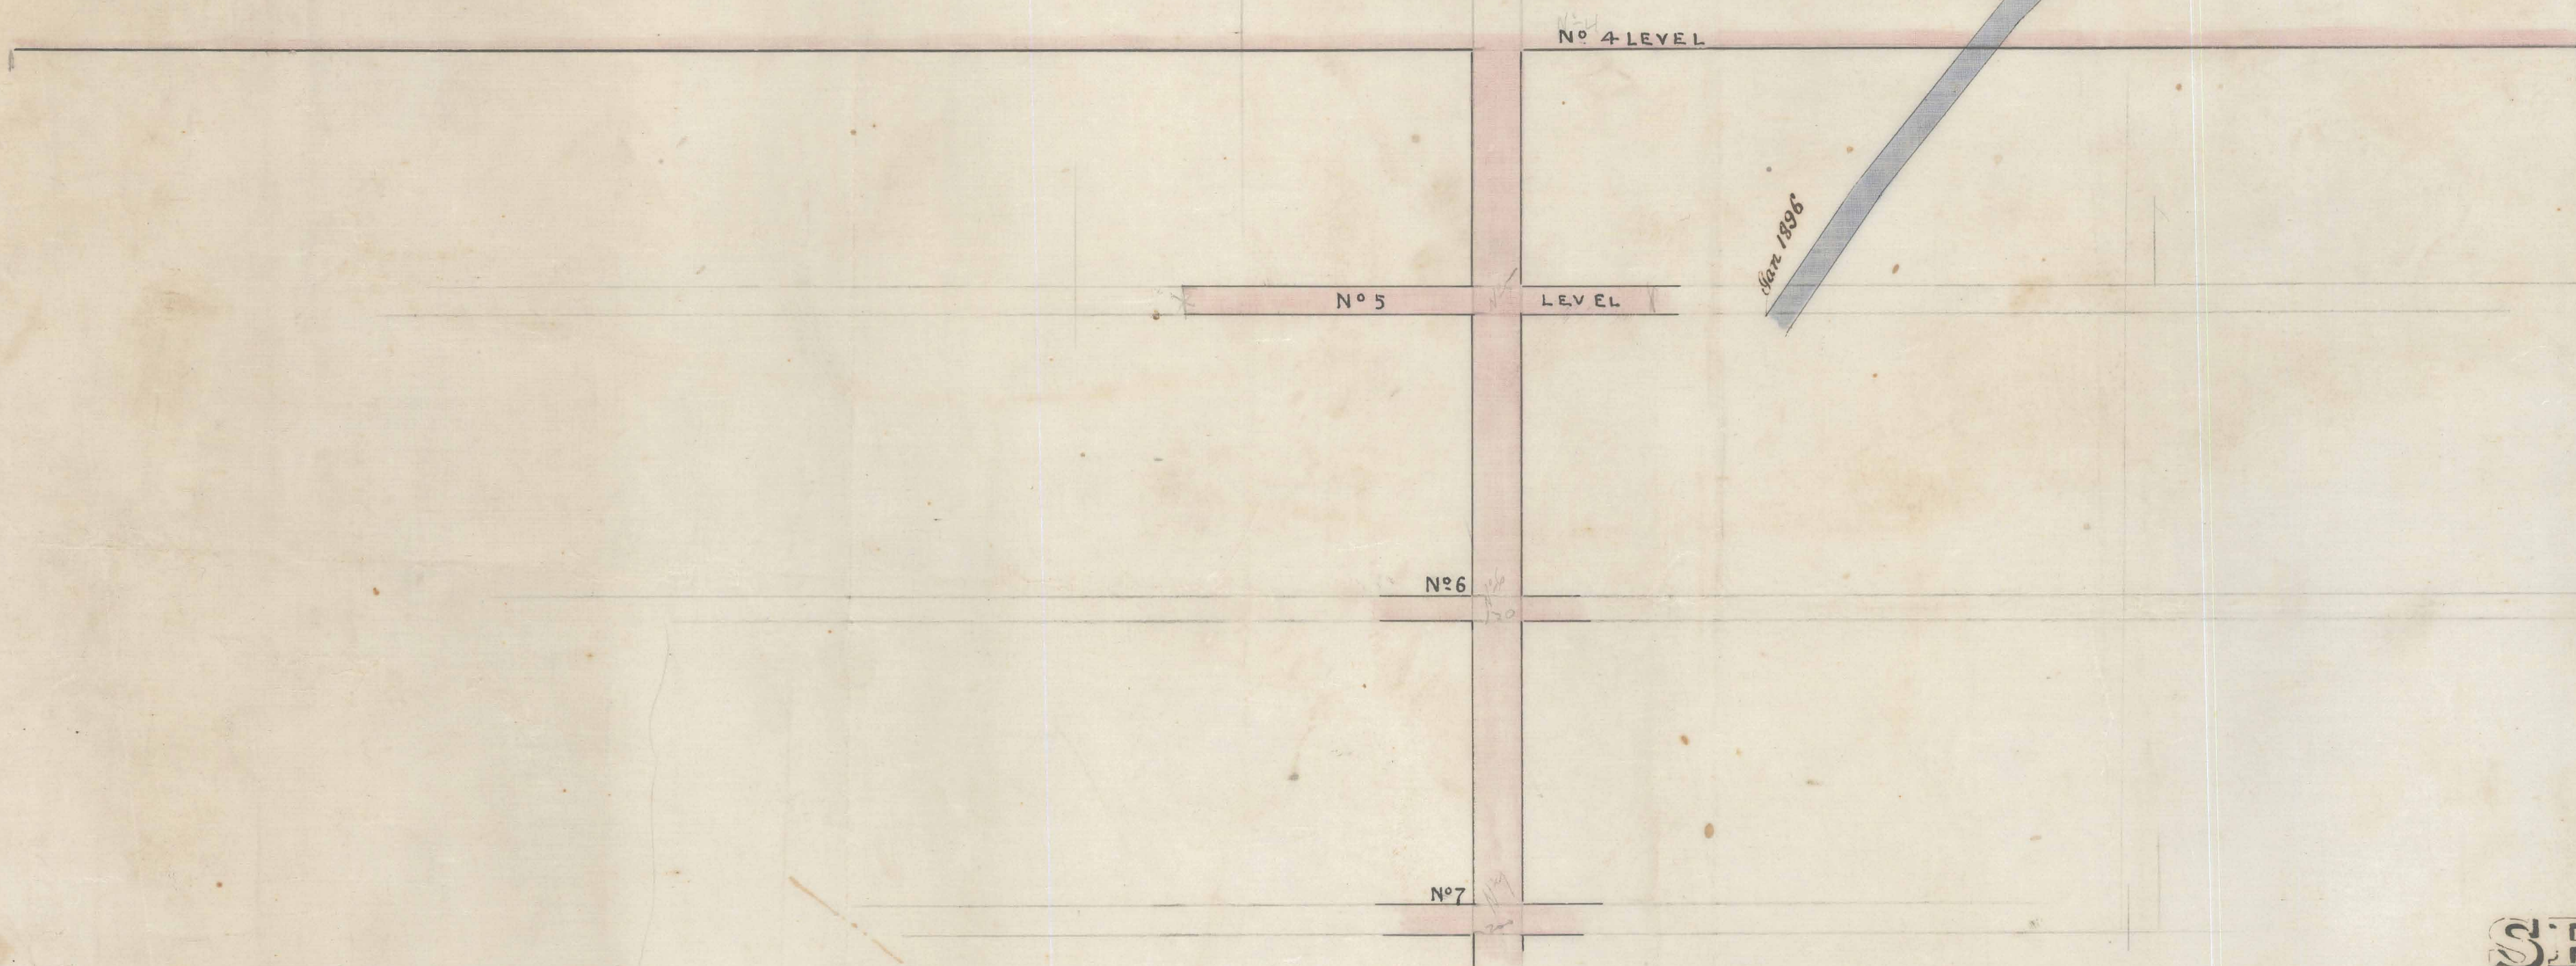

SECTION

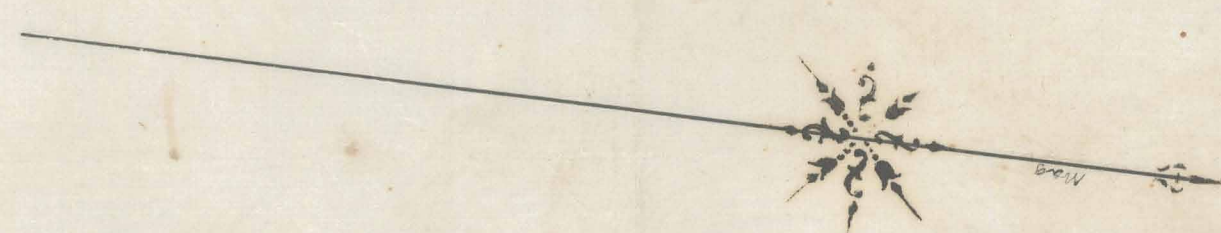