


5 cm

5

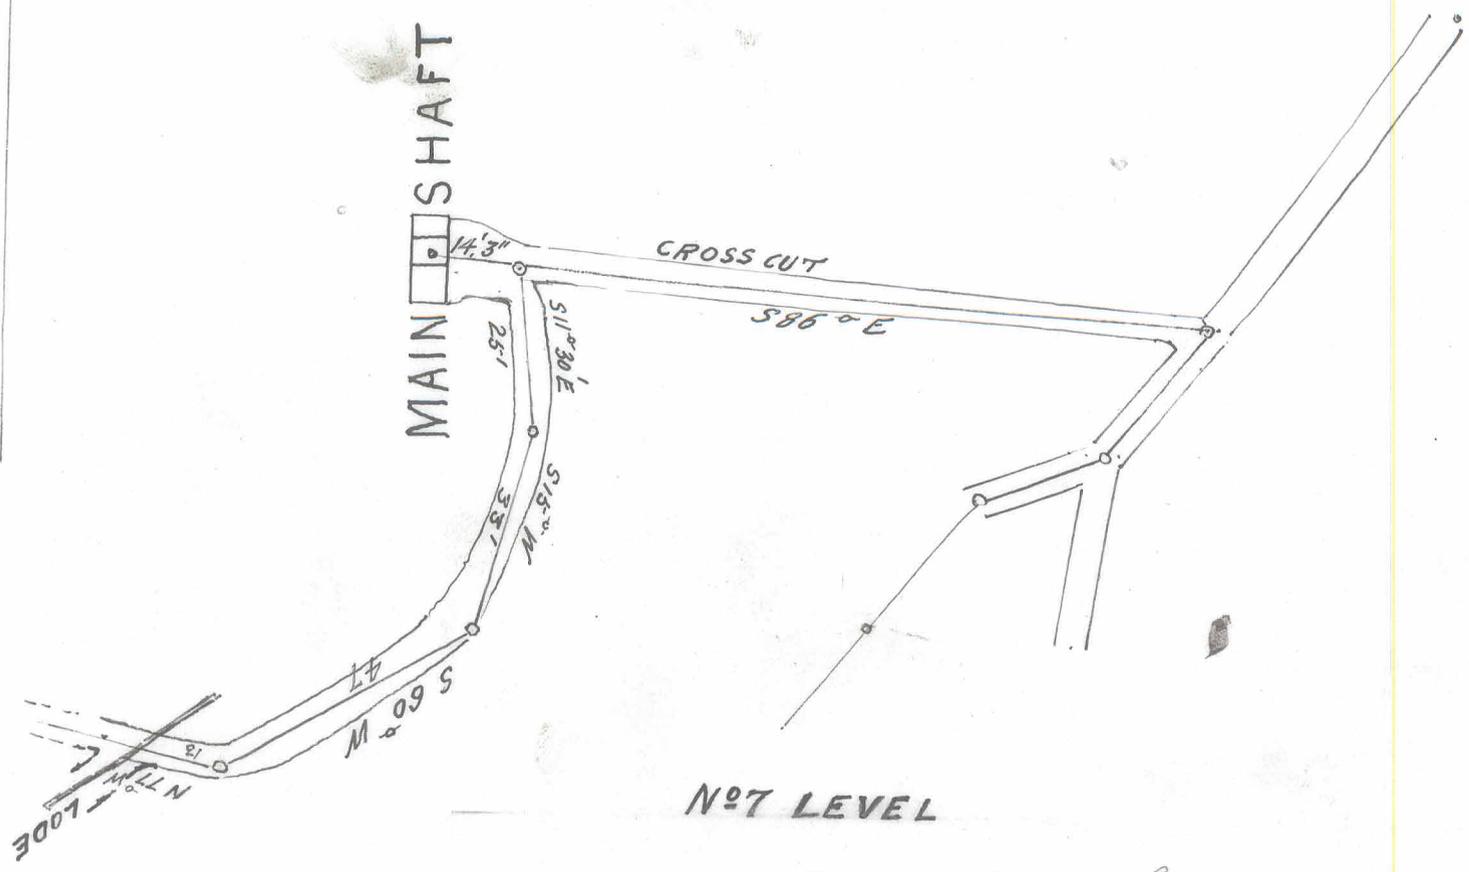


Scale 30 FT to an Inch