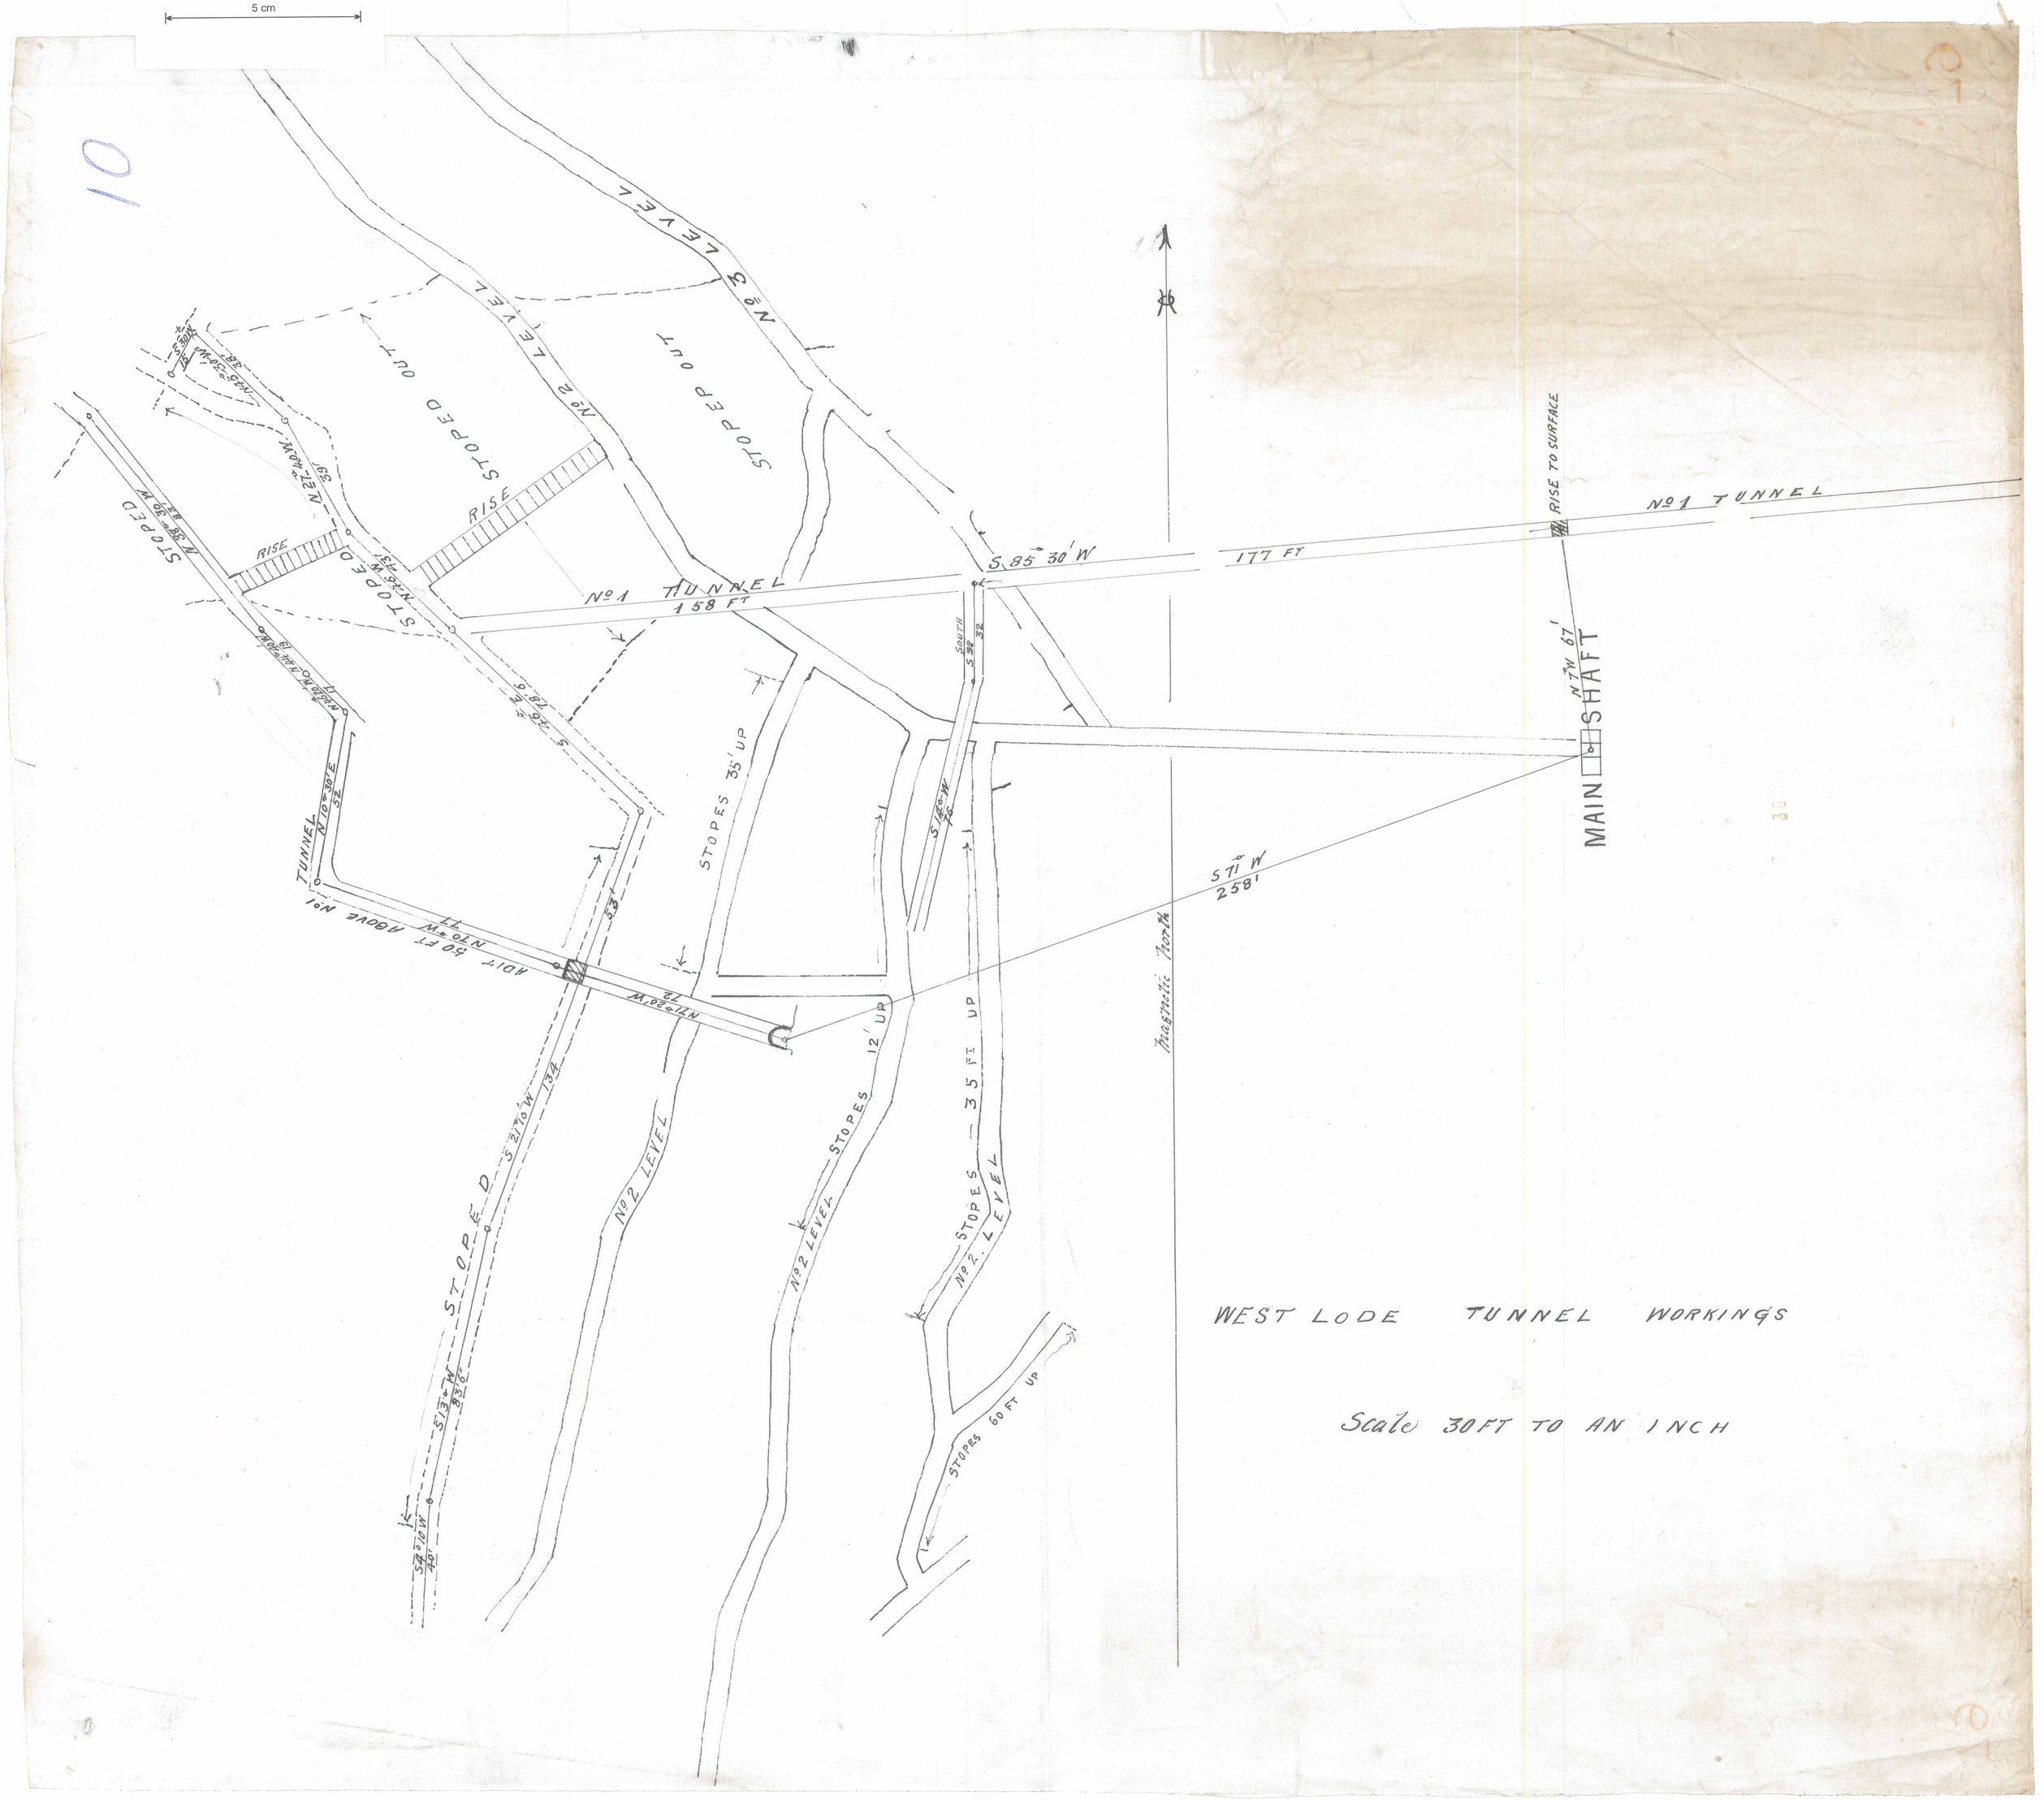
WEST LODE TUNNEL WORKINGS
Scale 30FT TO AN INCH
Magnetic North
MAIN SHAFT
N 7° W 67'
RISE TO SURFACE
No 1 TUNNEL
S 85° 30' W
177 FT
No 1 TUNNEL
158 FT
No 3 LEVEL
No 2 LEVEL
STOPED OUT
STOPED OUT
RISE
RISE
STOPED
STOPED
S 76° E 79'
STOPES 35' UP
SOUTH
S 38° W
32
S 16° W
16
S 71° W
258'
STOPES 12' UP
STOPES — 35 FT UP
No 2 LEVEL
No 2 LEVEL
STOPES
No 2. LEVEL
STOPES 60 FT UP
STOPED
S 27° 10' W 134
S 13° W
95'
S 27° 10' W
40'
TUNNEL
N 10° 30' E
52
N 10° W
11
N 17° 50' W
12
ADIT 50 FT ABOVE No 1
53
N 21° 40' W
39'
N 36° 30' W
44'
N 45° 30' W
38'
N 36° W 45'
