LONGITUDINAL SECTION

No 2 LODE
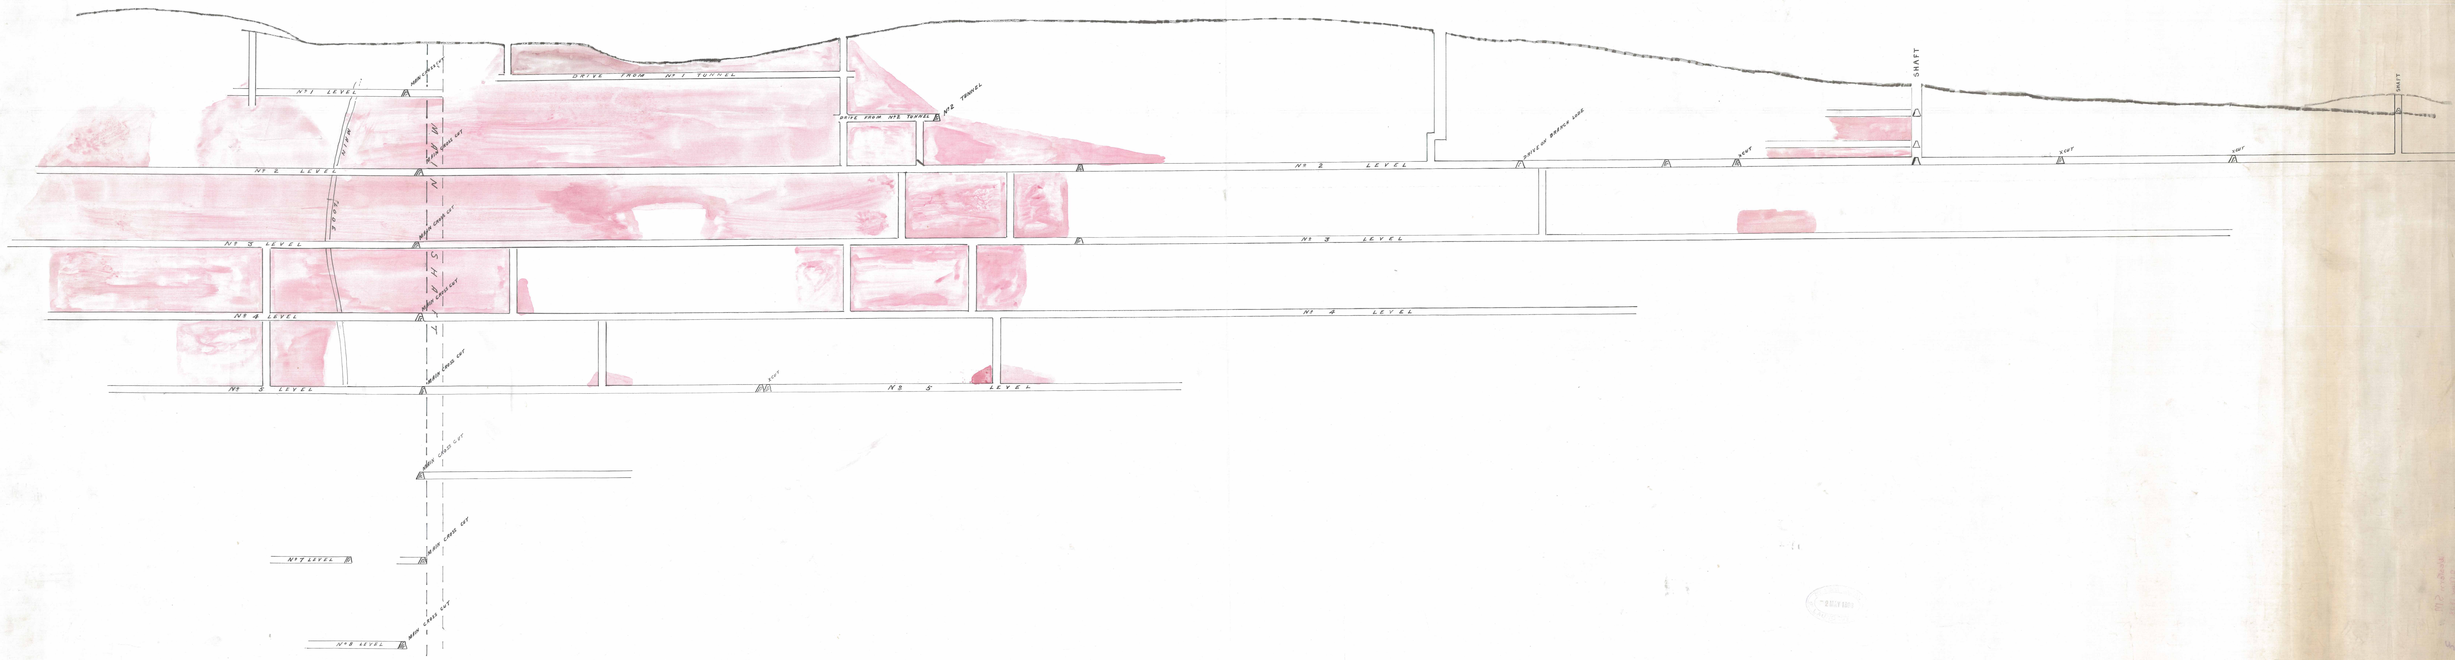
SCALE 30 FEET TO AN INCH