WESTERN EXTD MINE

Scale 30 feet to an inch

Department of Mines Tasmania
20th April 1896
Launceston

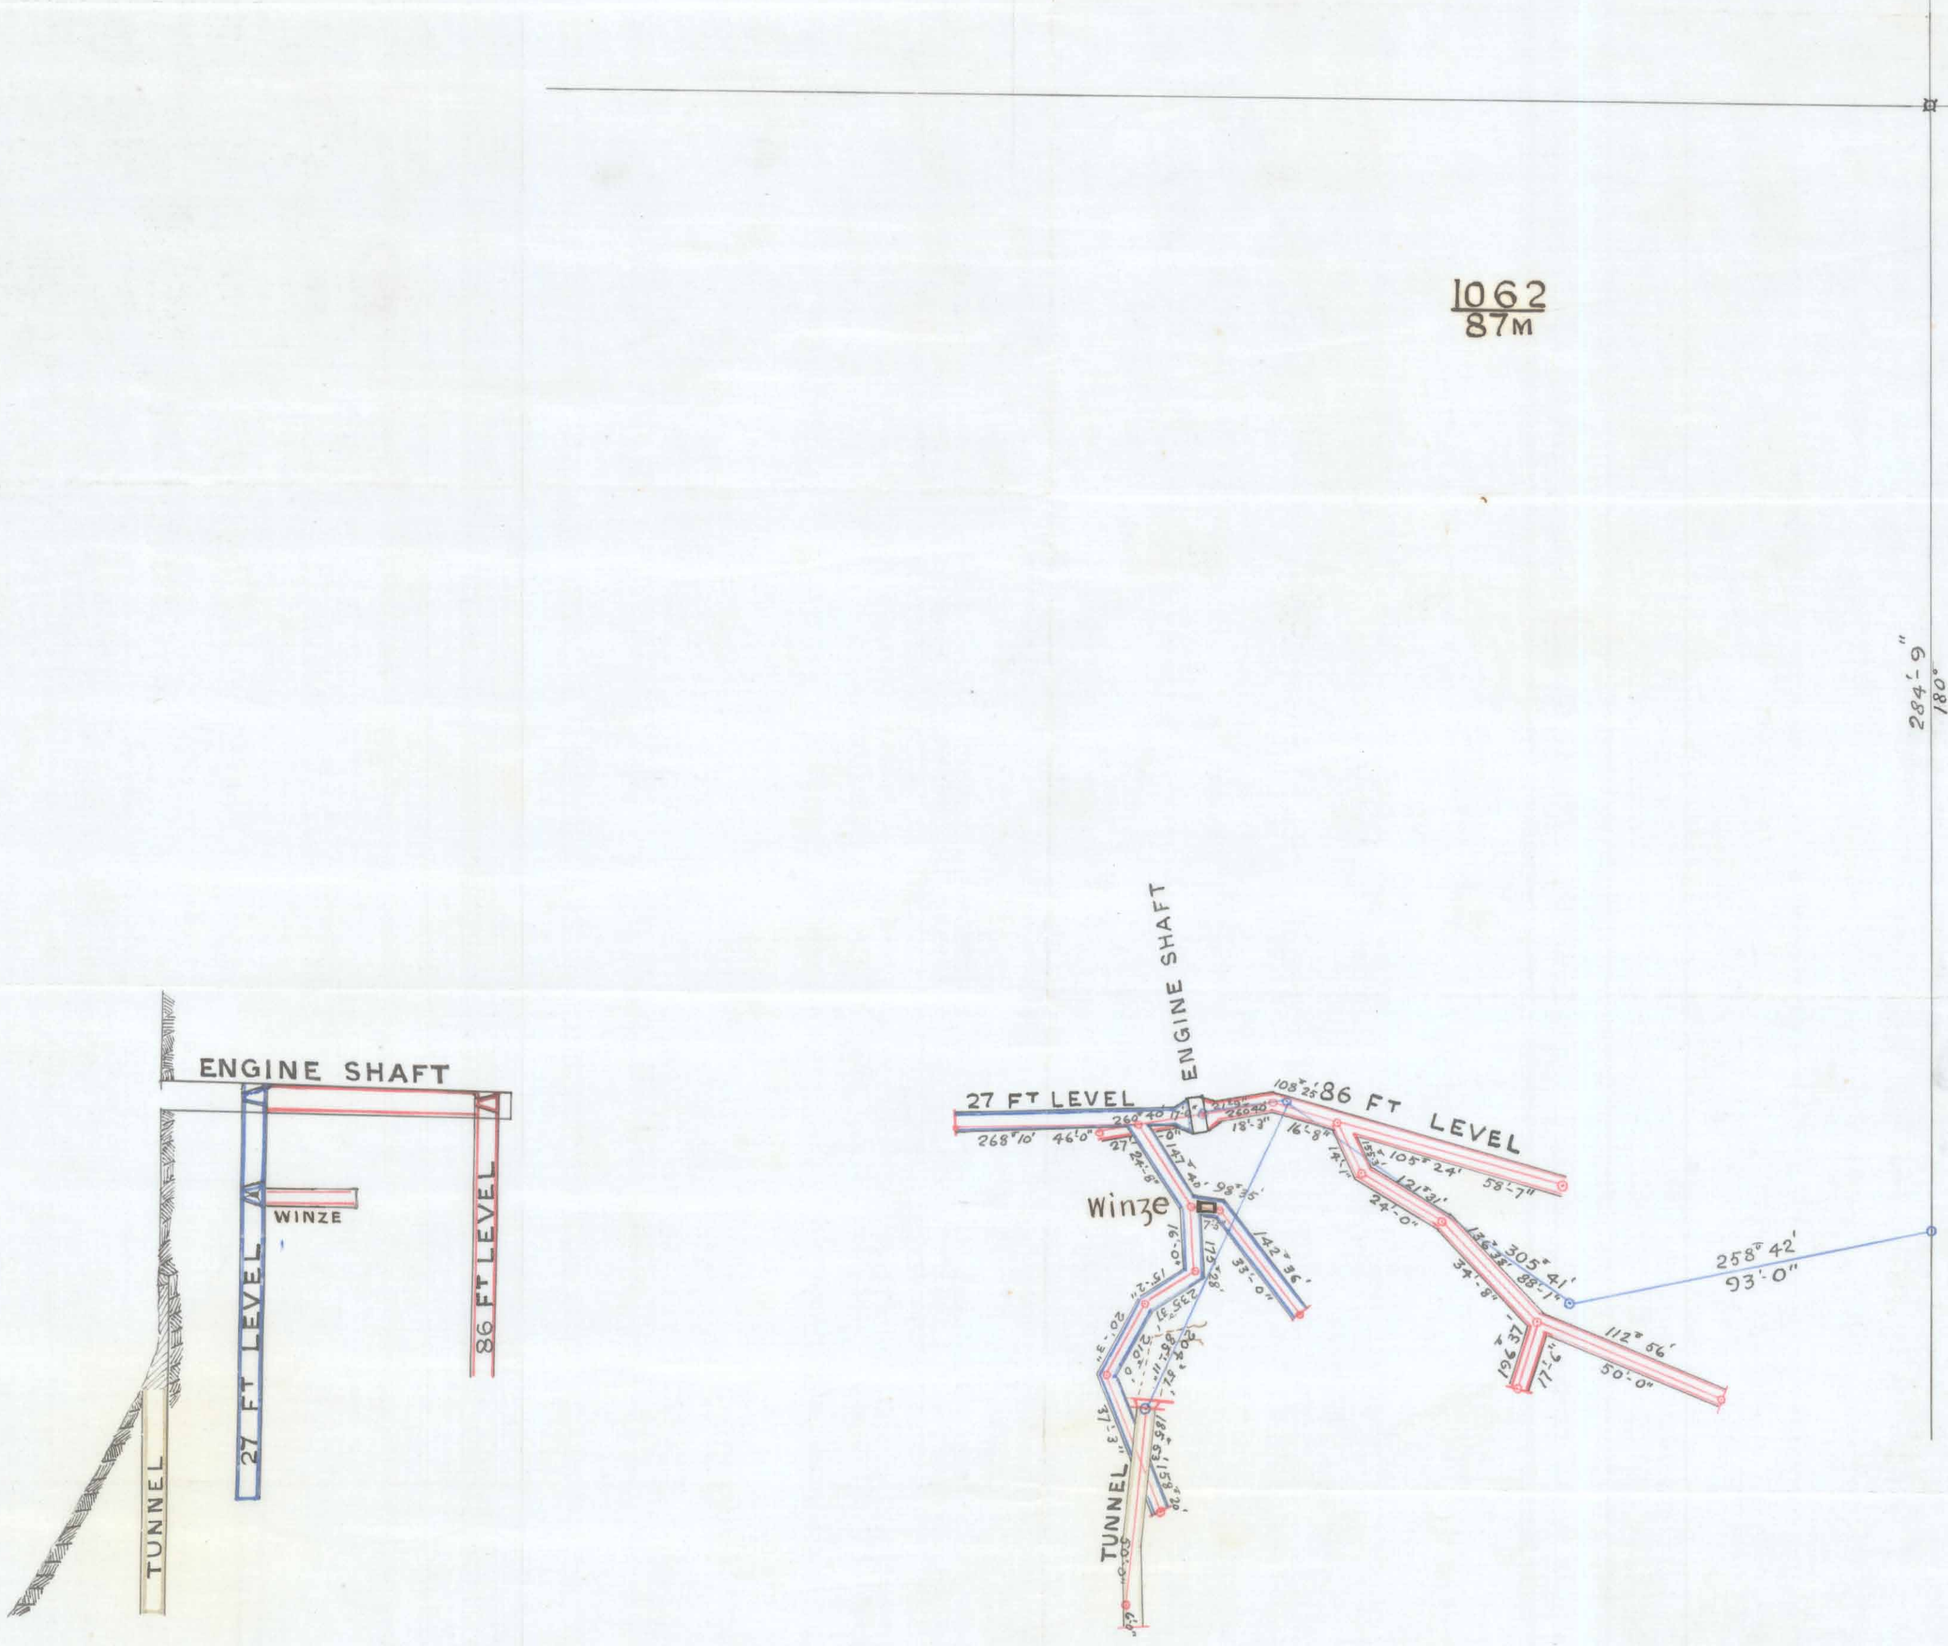

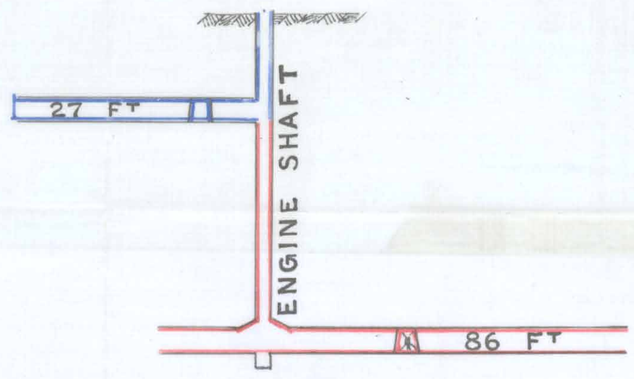

CROSS-CUTS

C.W. Glover
Asst Surveyor
Zeehan Jan '96