
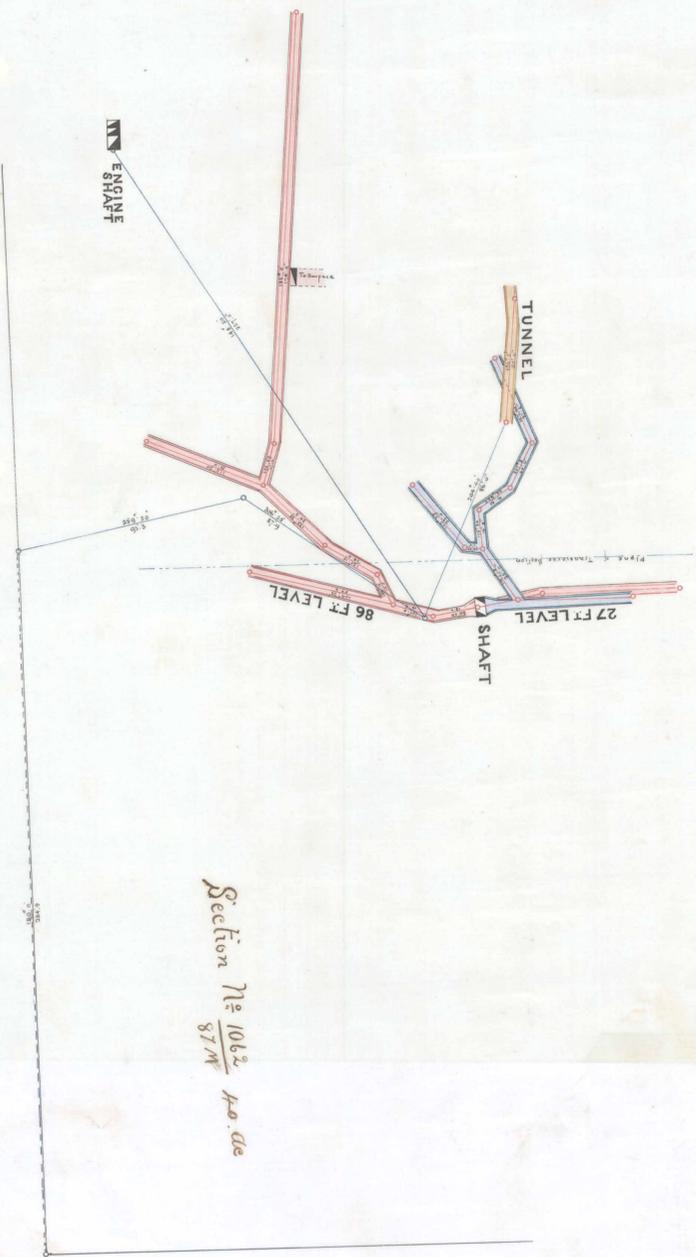


5 cm

03

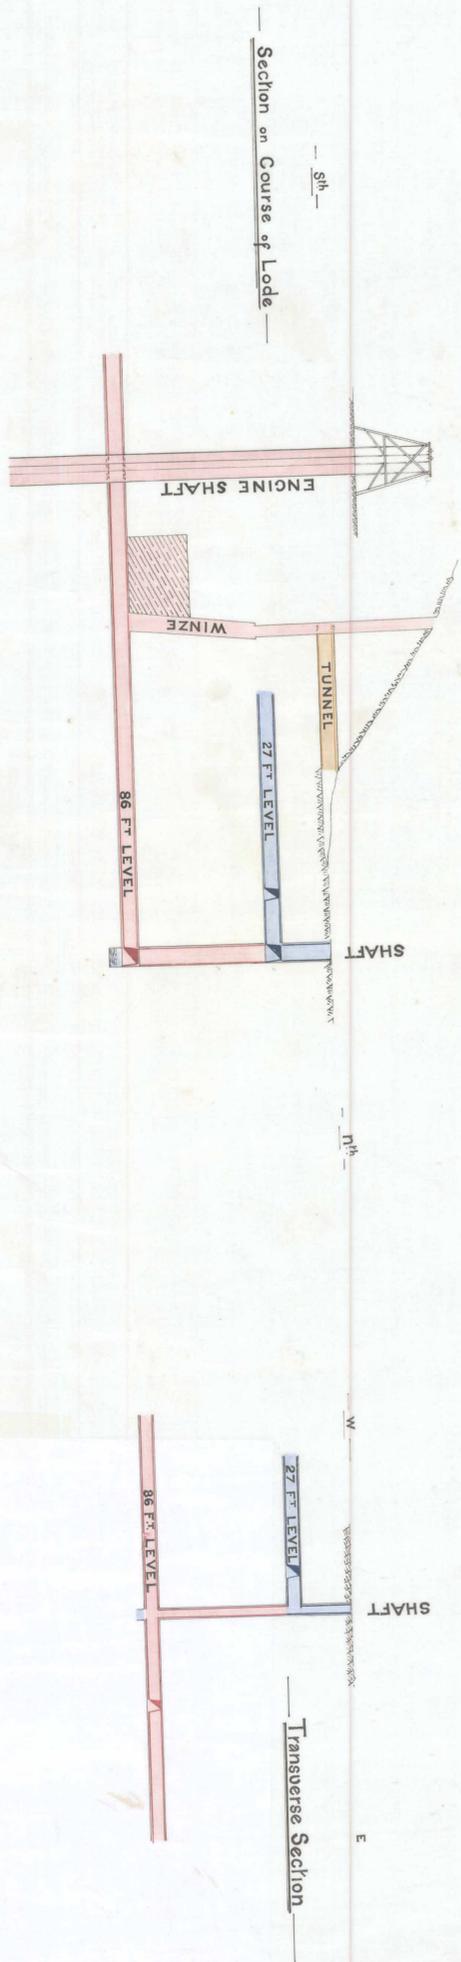

WESTERN EX. & S.M. CO.

Scale 30 ft to 1 inch



1062