


THE ZEEHAN-WE

PROJECTION ON E & W
SCALE  1" = 30'

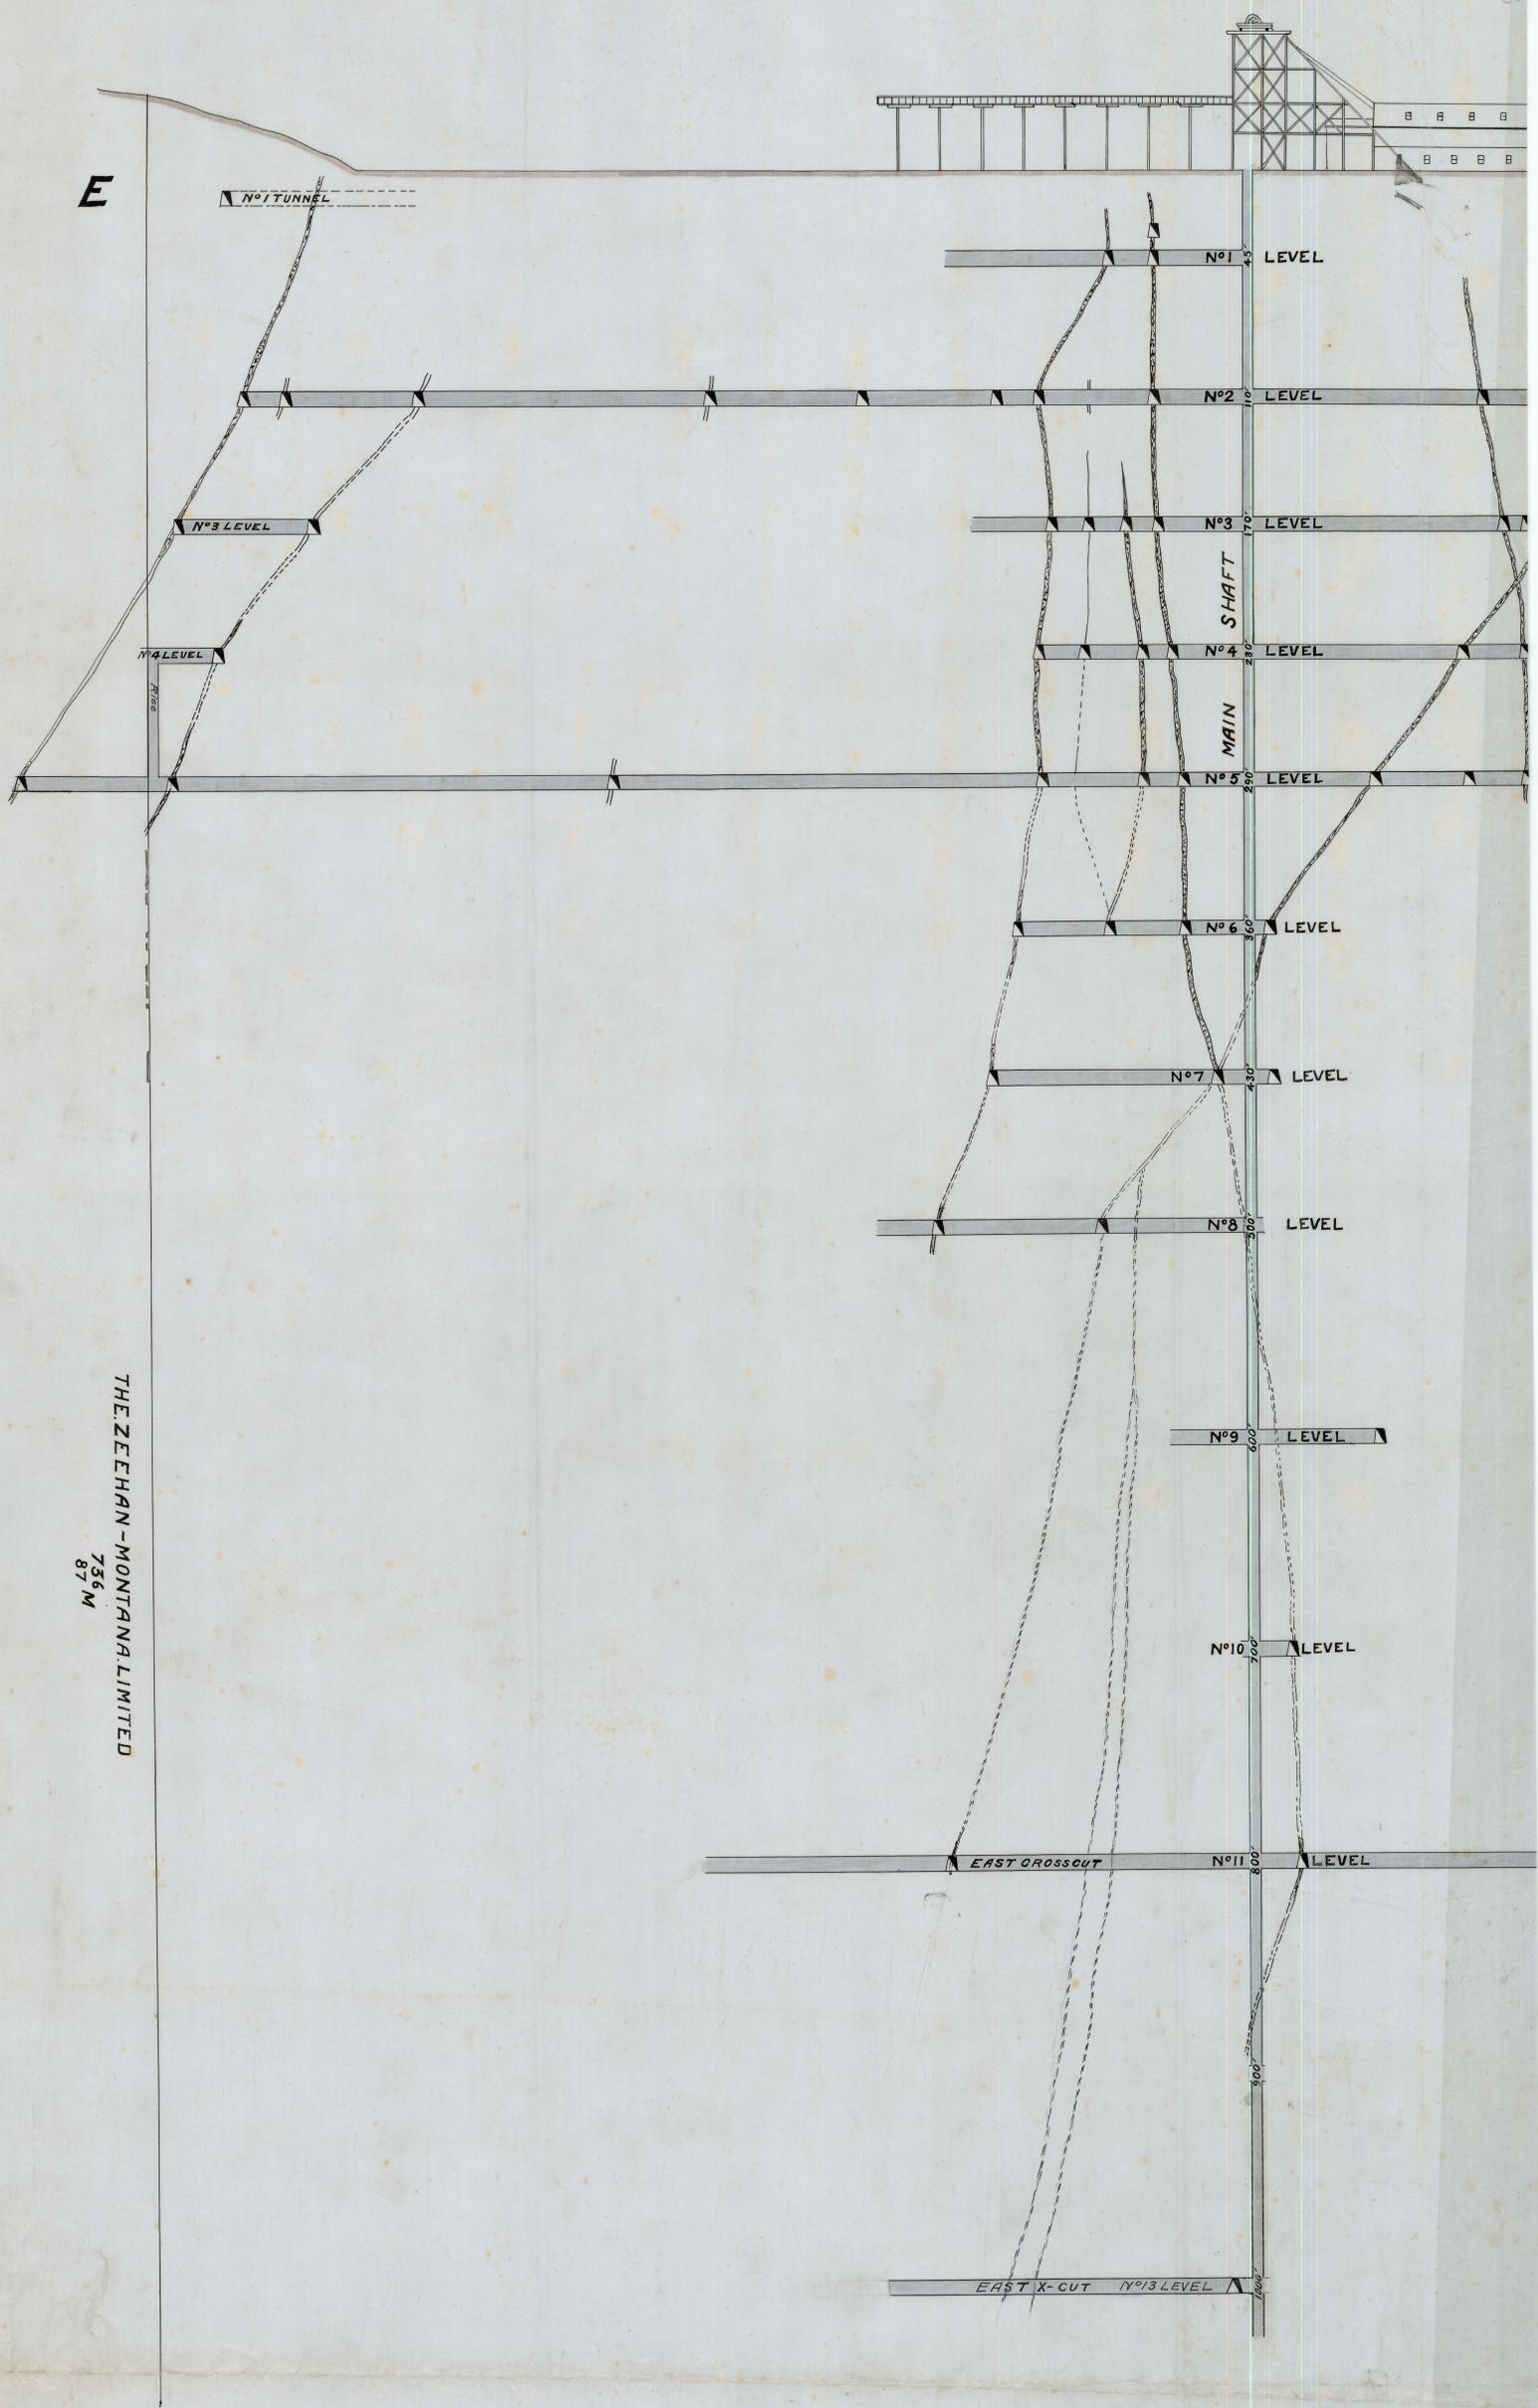

THE ZEEHAN-MONTANA LIMITED
756 M
87 M