THE ZEEHAN-WESTERN LIMITED

VERTICAL SECTION

SCALE 30ft = 1 INCH

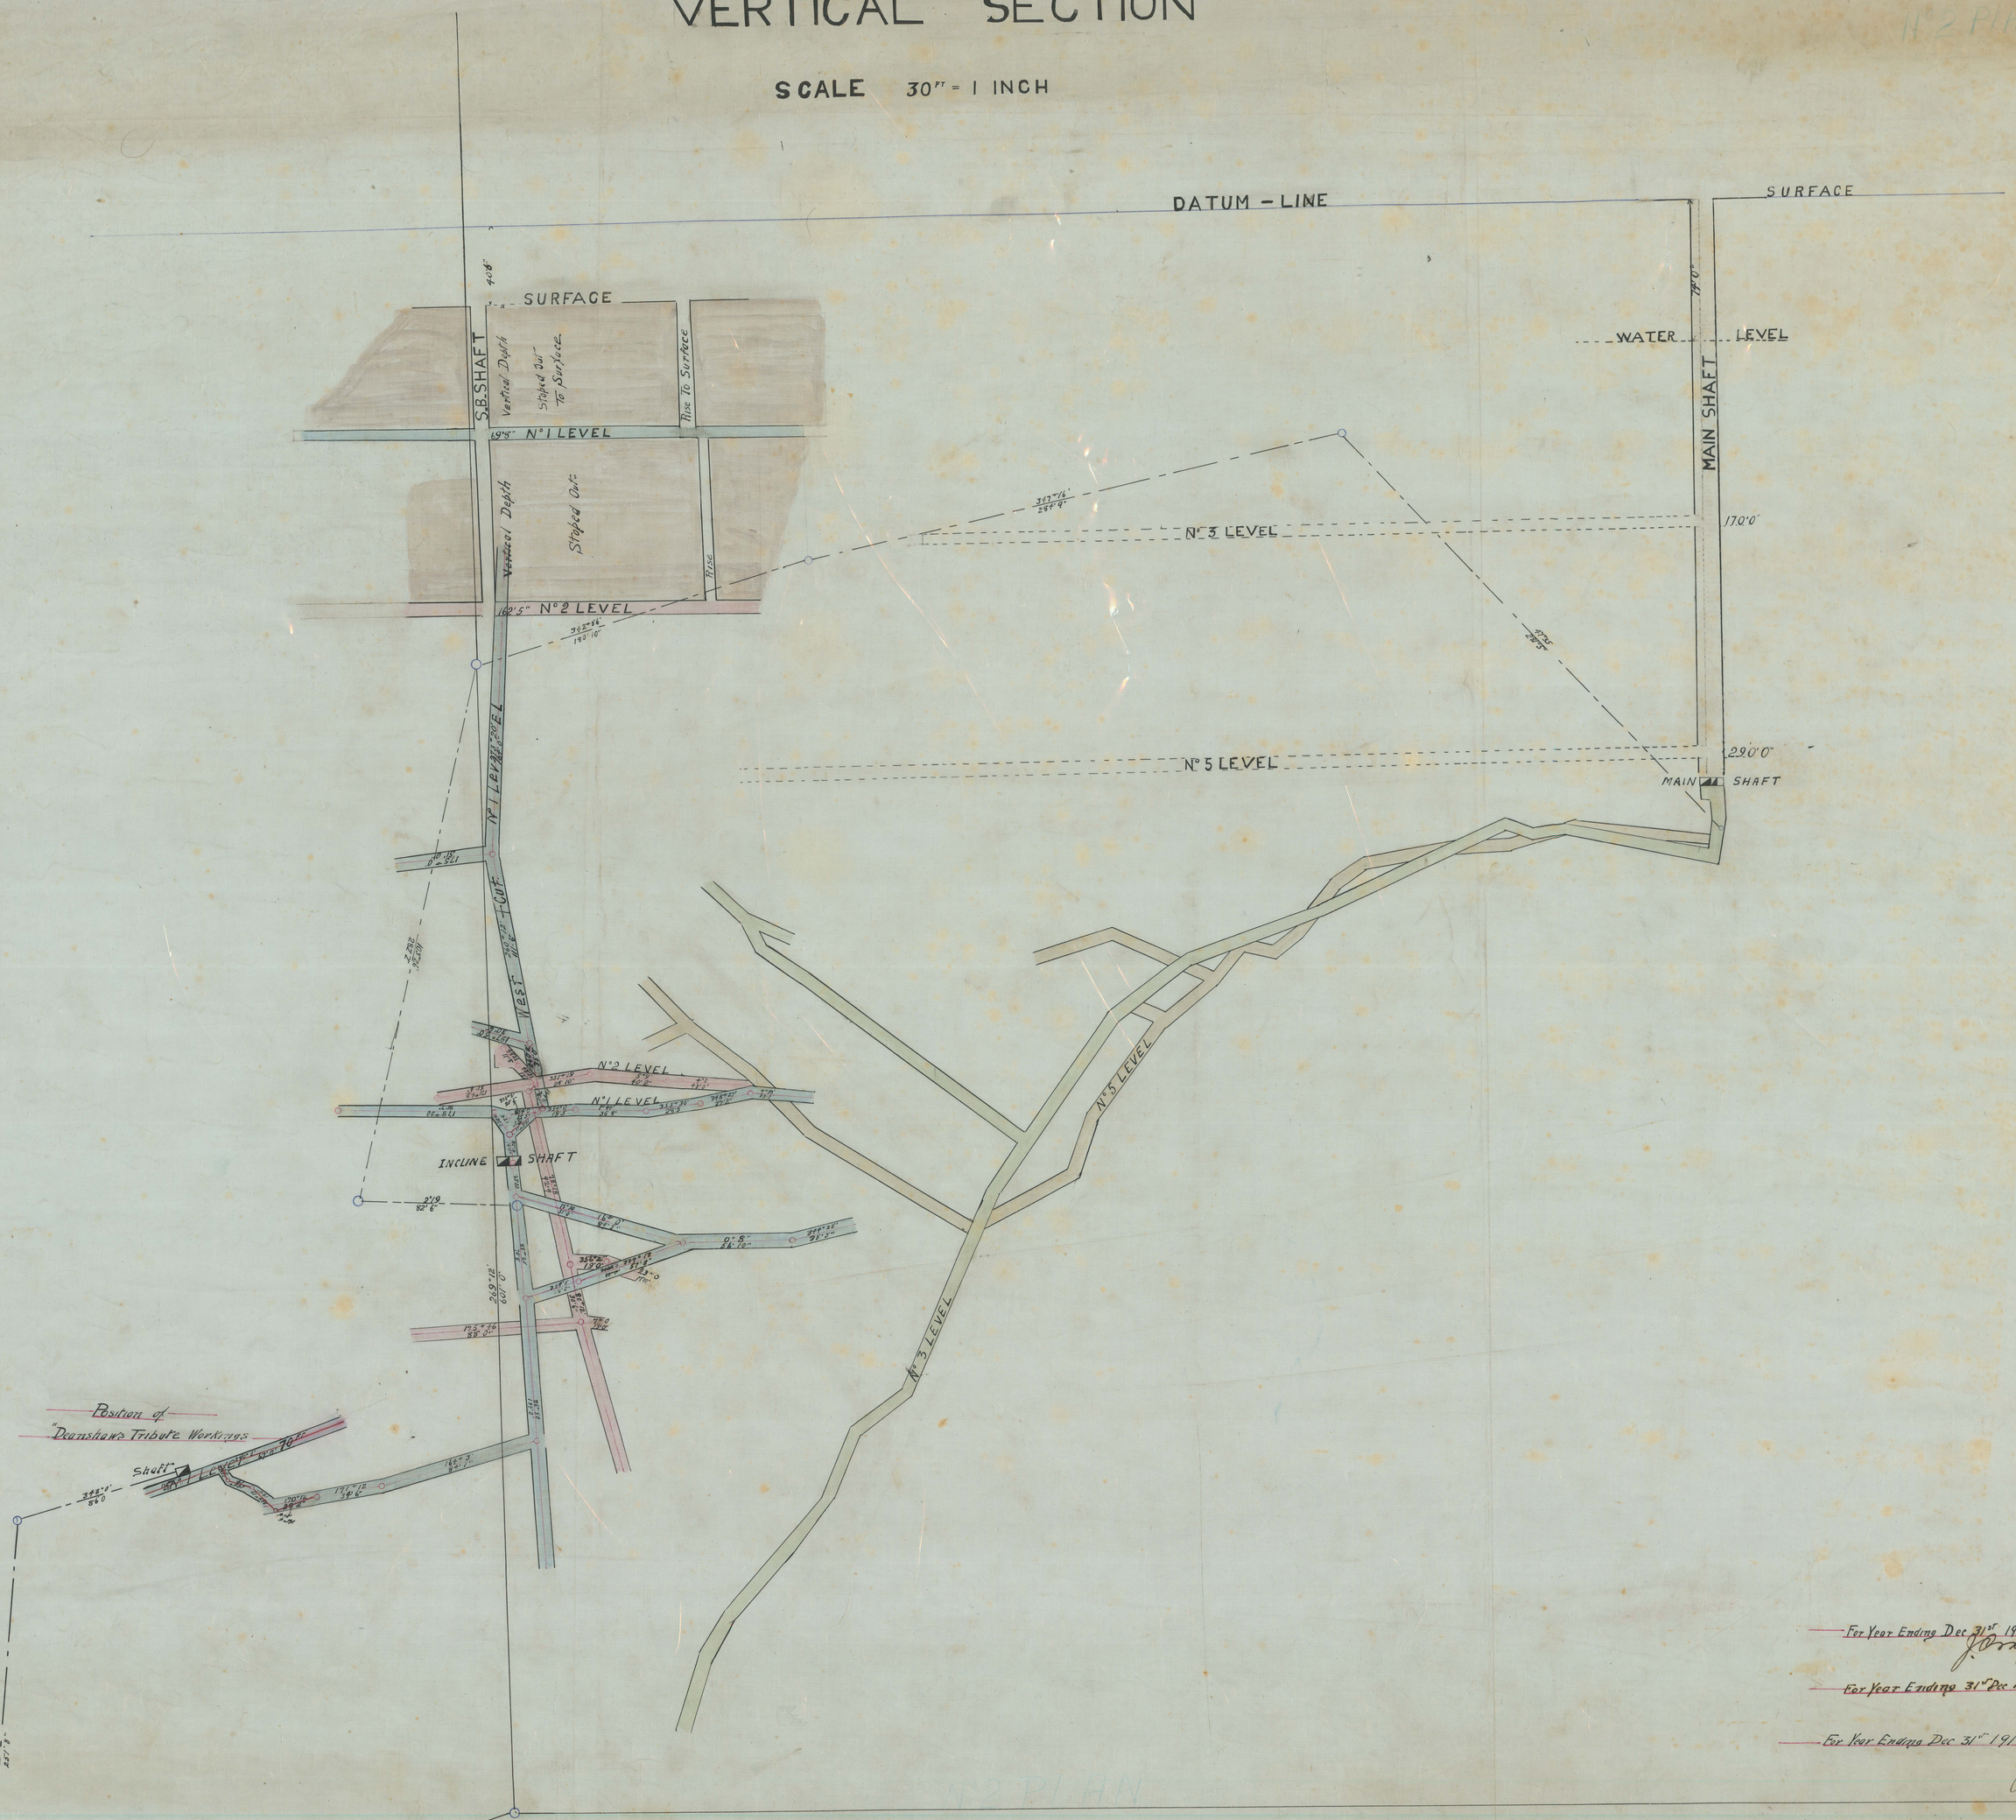

For Year Ending Dec 31st 1911
J. Orge Manager

For Year Ending 31st Dec 1912
J. Orge Manager

For Year Ending Dec 31st 1913
J. Orge Manager