336
09

Mount Lyell Mining & Railway Co Ltd.

Mine Department.

SHEET Nº2.

Field Notes of Underground Workings up to Dec 31st 1927.

Instrument used 5" Theodolite.

General Manager
Mine Superintendent

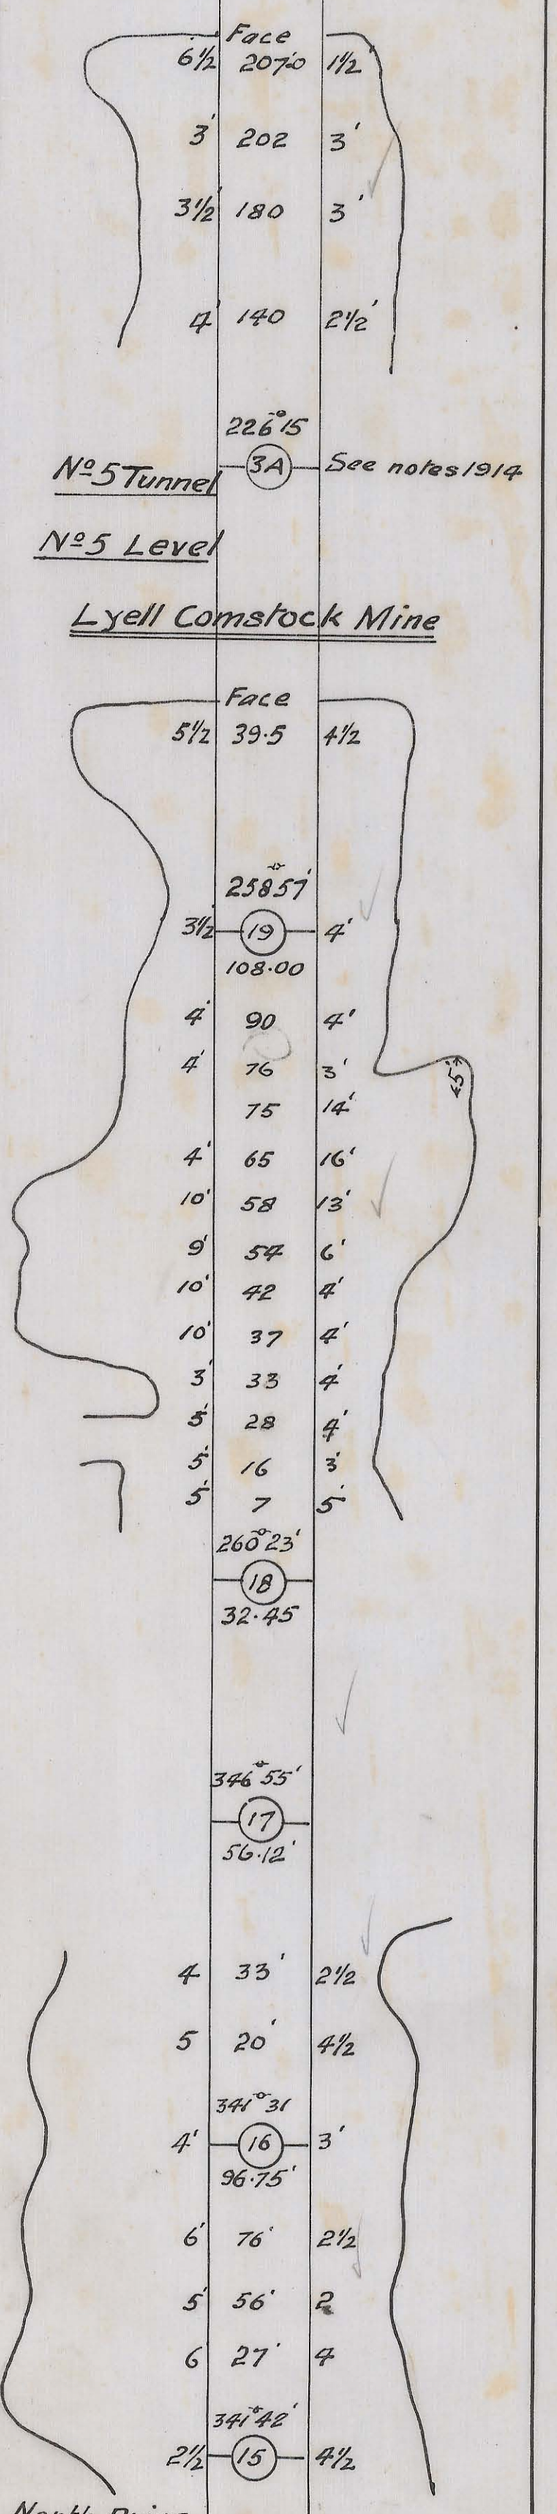

Continued from sheet Nº1

Xd 13/6/28