


5 cm

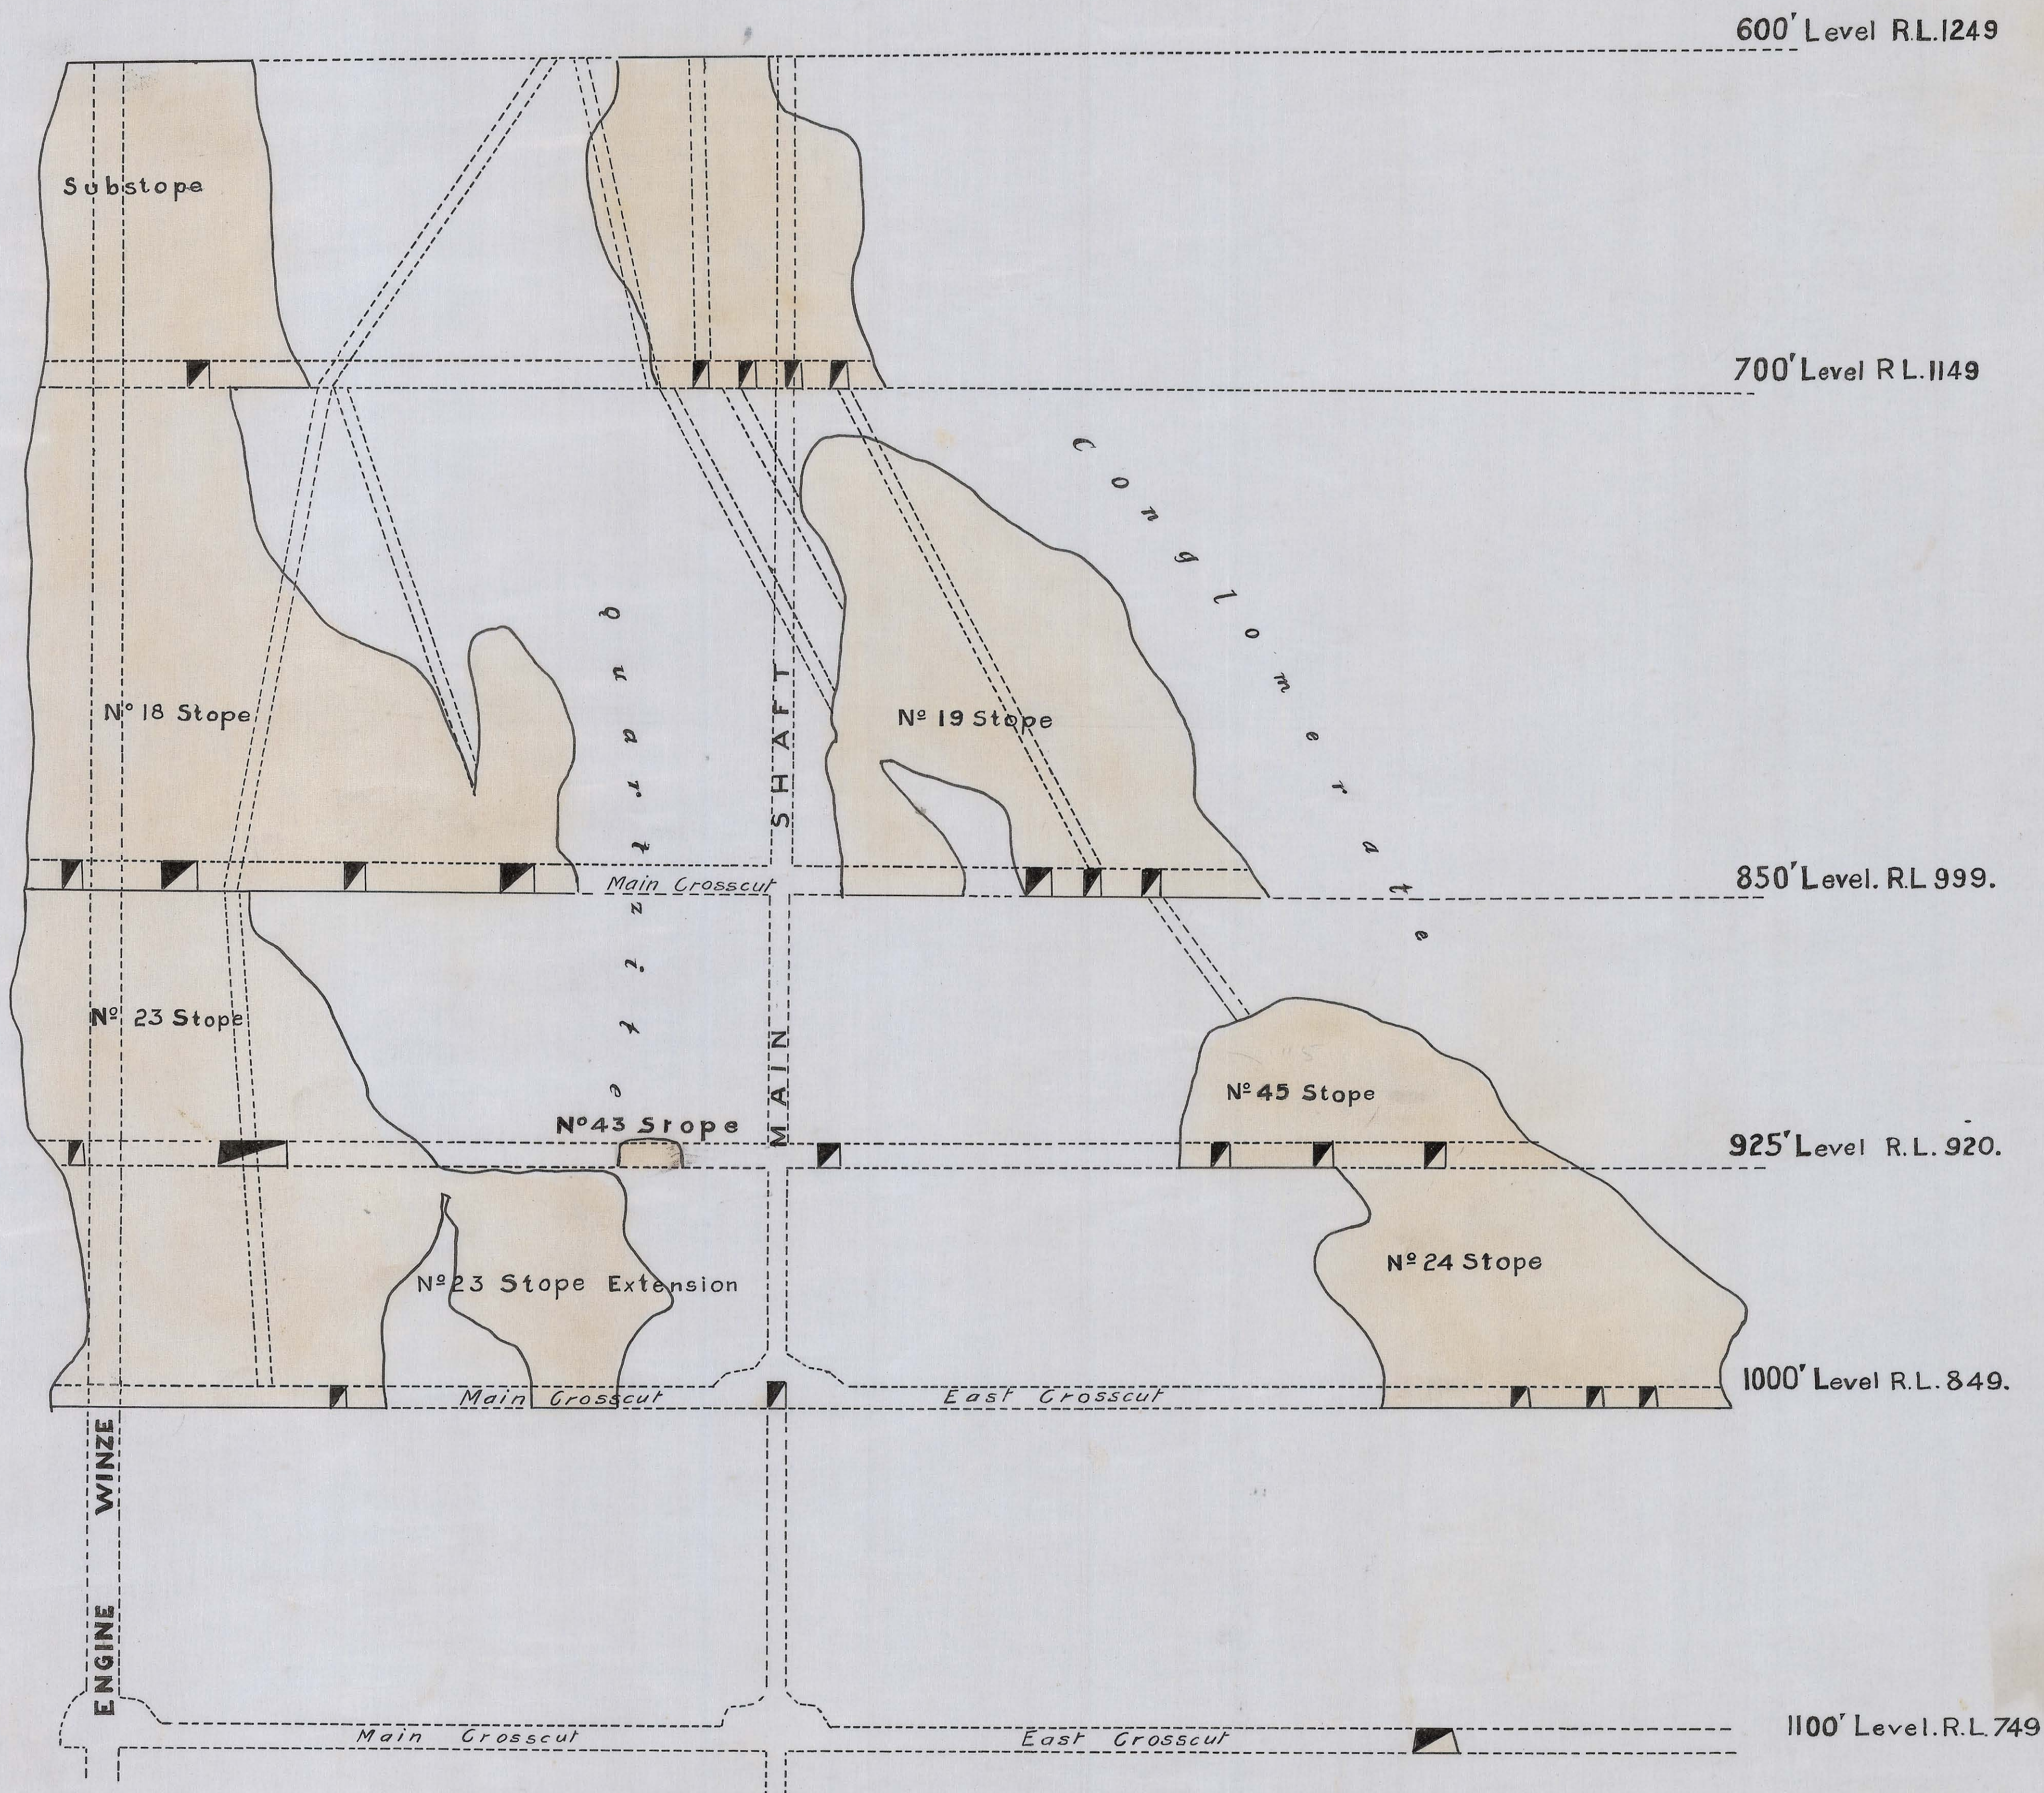

The Mount Lyell Mining & Railway Co., Ltd.

Mine Department

NORTH LYELL MINE

Section on Line BB looking North.

Brought up to Dec 31st 1922

Scale 1" = 30'

R. H. Murray General Manager
E. H. Jones Mine Superintendent