336 - 74

The Mount Lyell Mining & Railway Co., Ltd.

Mine Department.

SHEET Nº3

FIELD NOTES OF UNDERGROUND WORKINGS UP TO **31-12-29**

R. L. Sprent ... General Manager
... Mine Superintendent
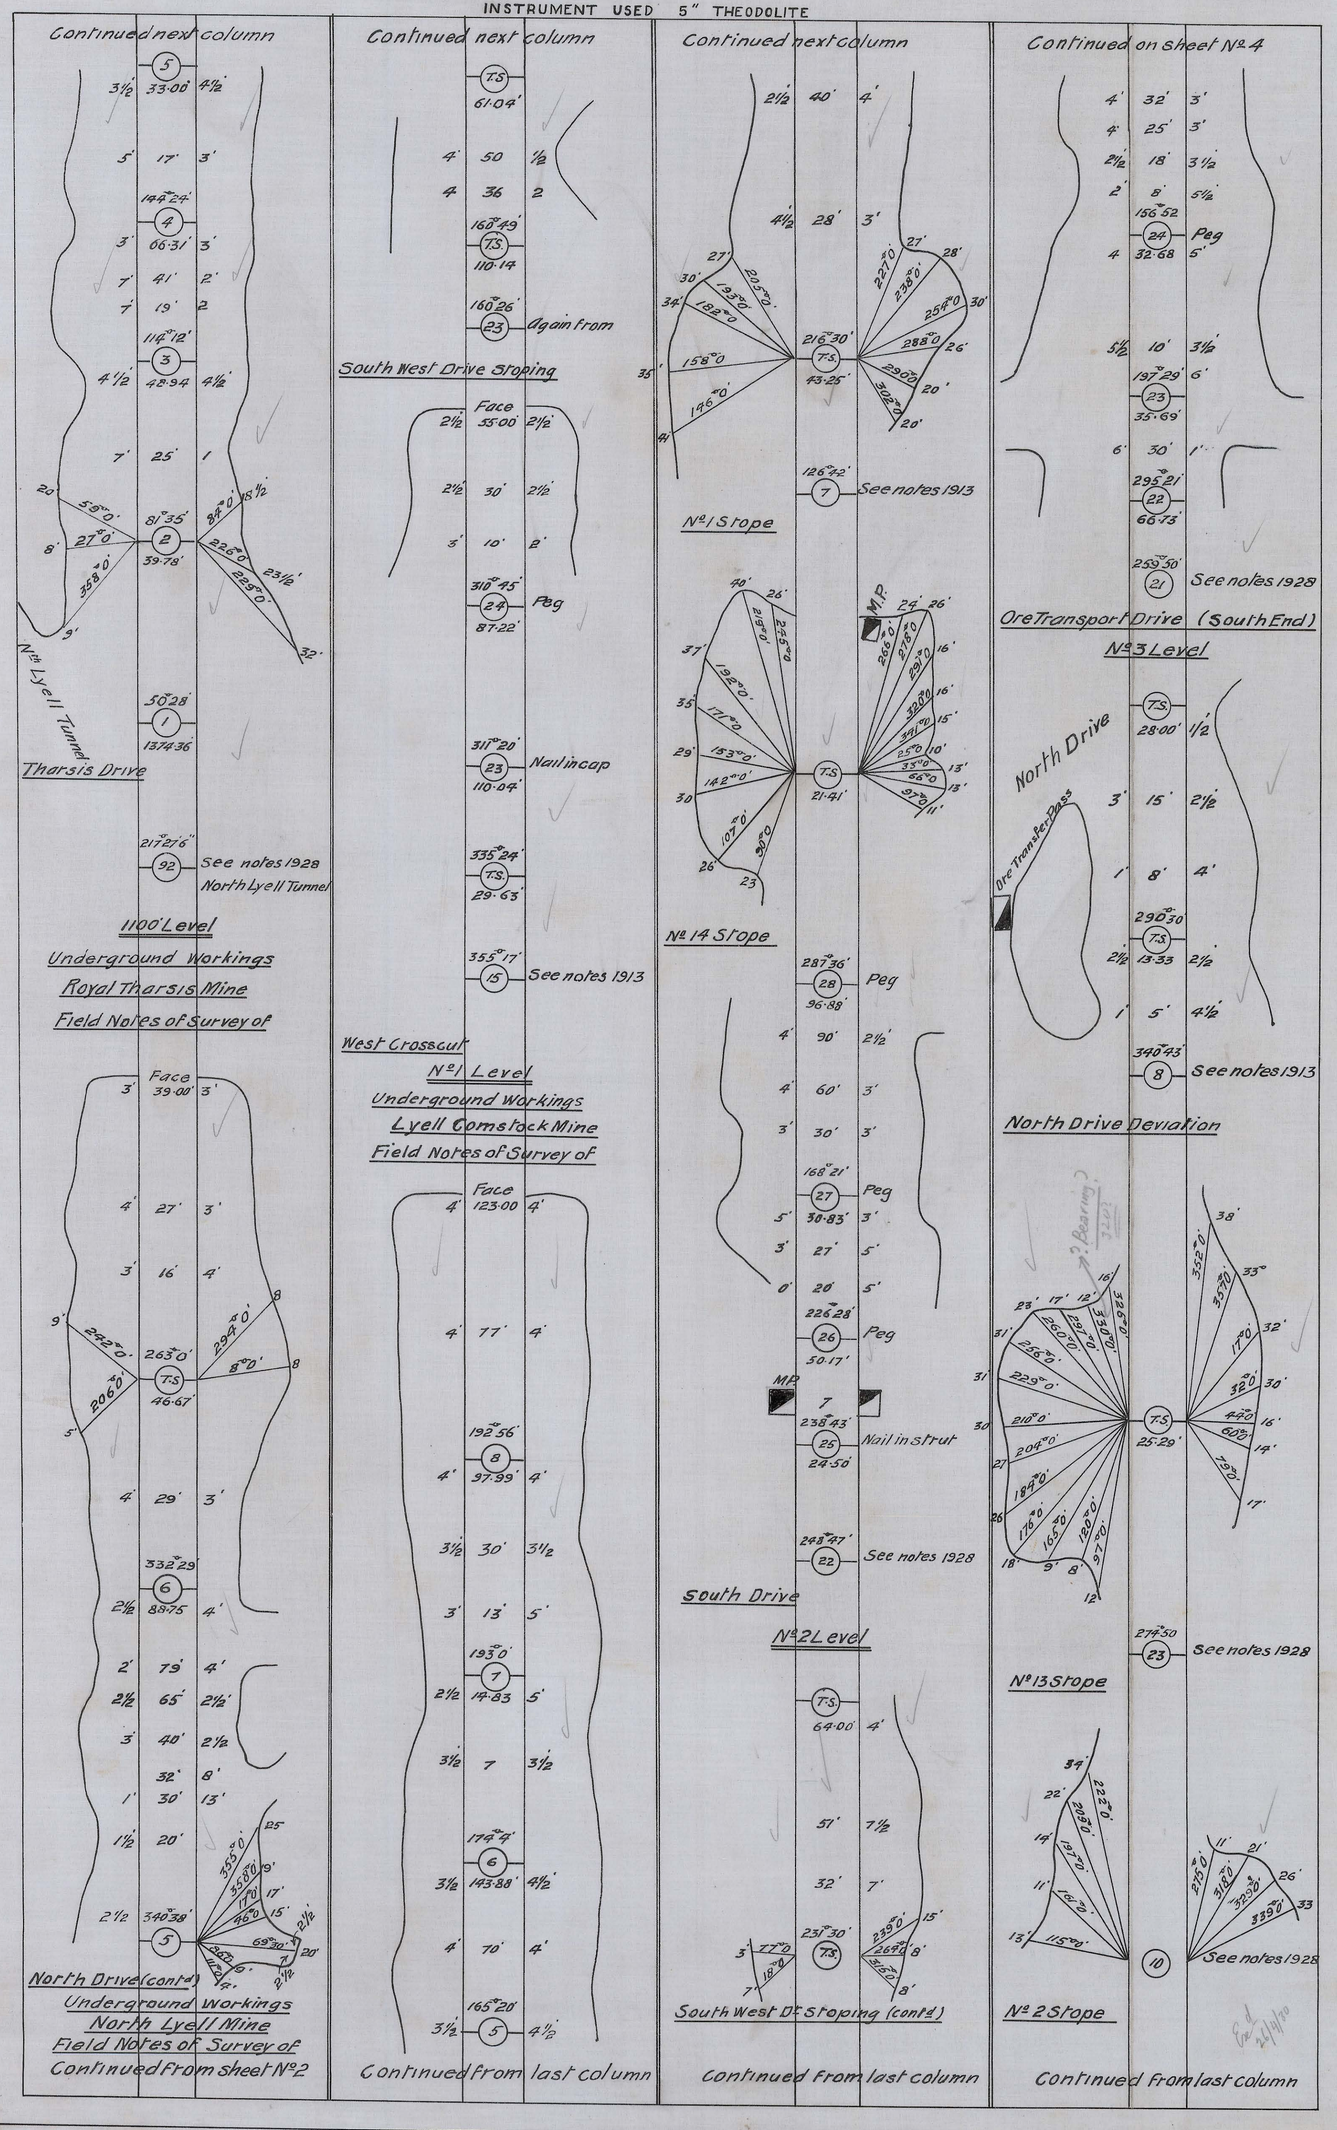
INSTRUMENT USED 5" THEODOLITE