The Mount Lyell Mining & Railway Co., Ltd.

Mine Department.

FIELD NOTES OF UNDERGROUND WORKINGS UP TO **31-12-29**

SHEET Nº2

General Manager
Mine Superintendent
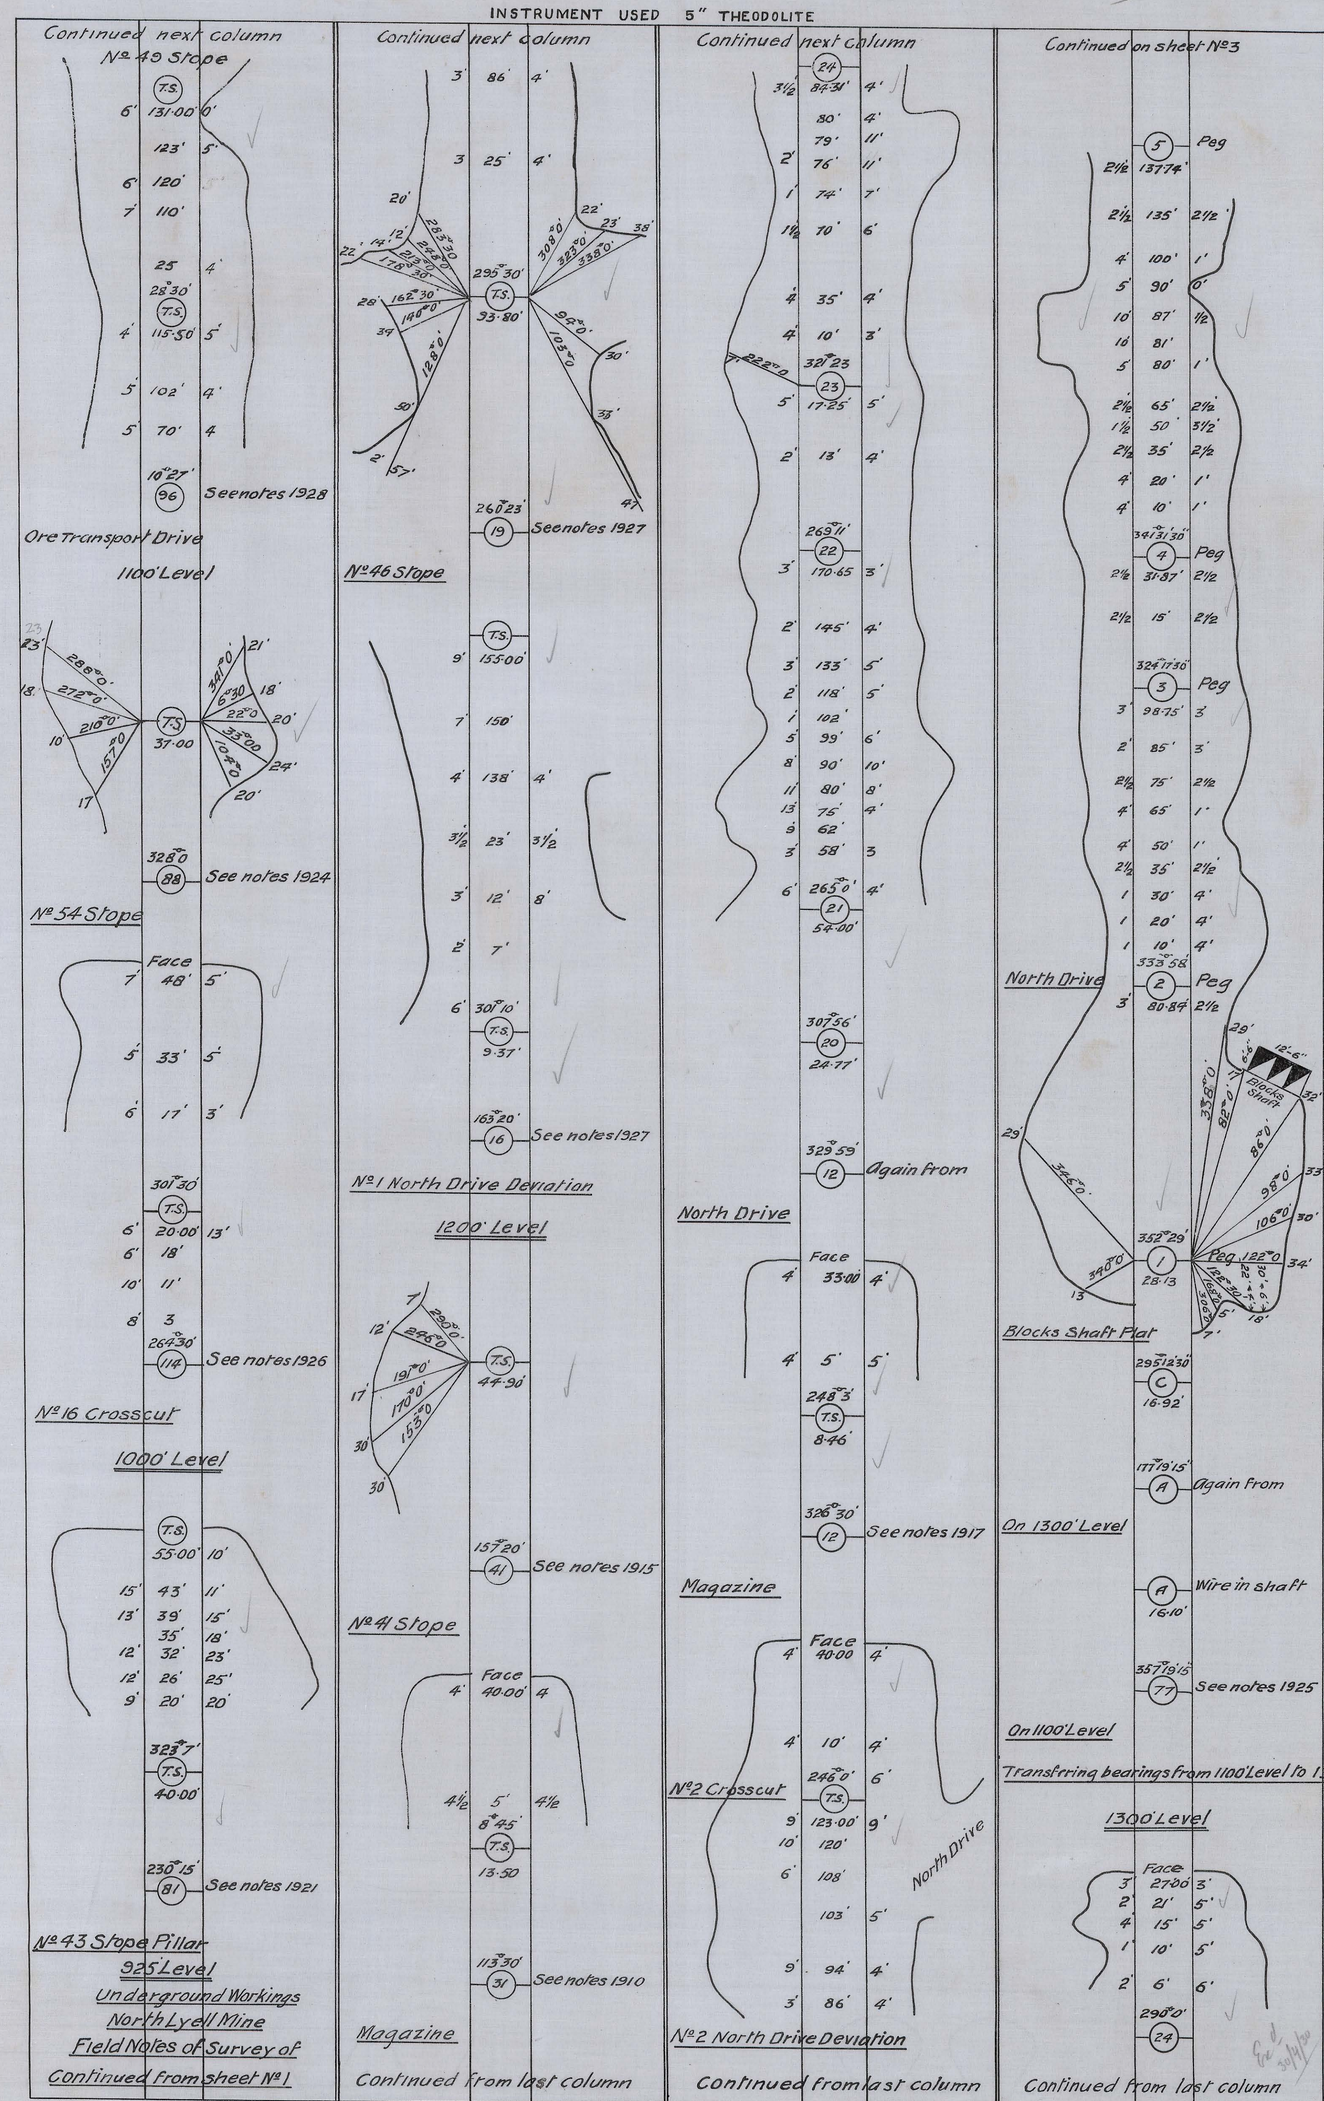
INSTRUMENT USED 5" THEODOLITE