


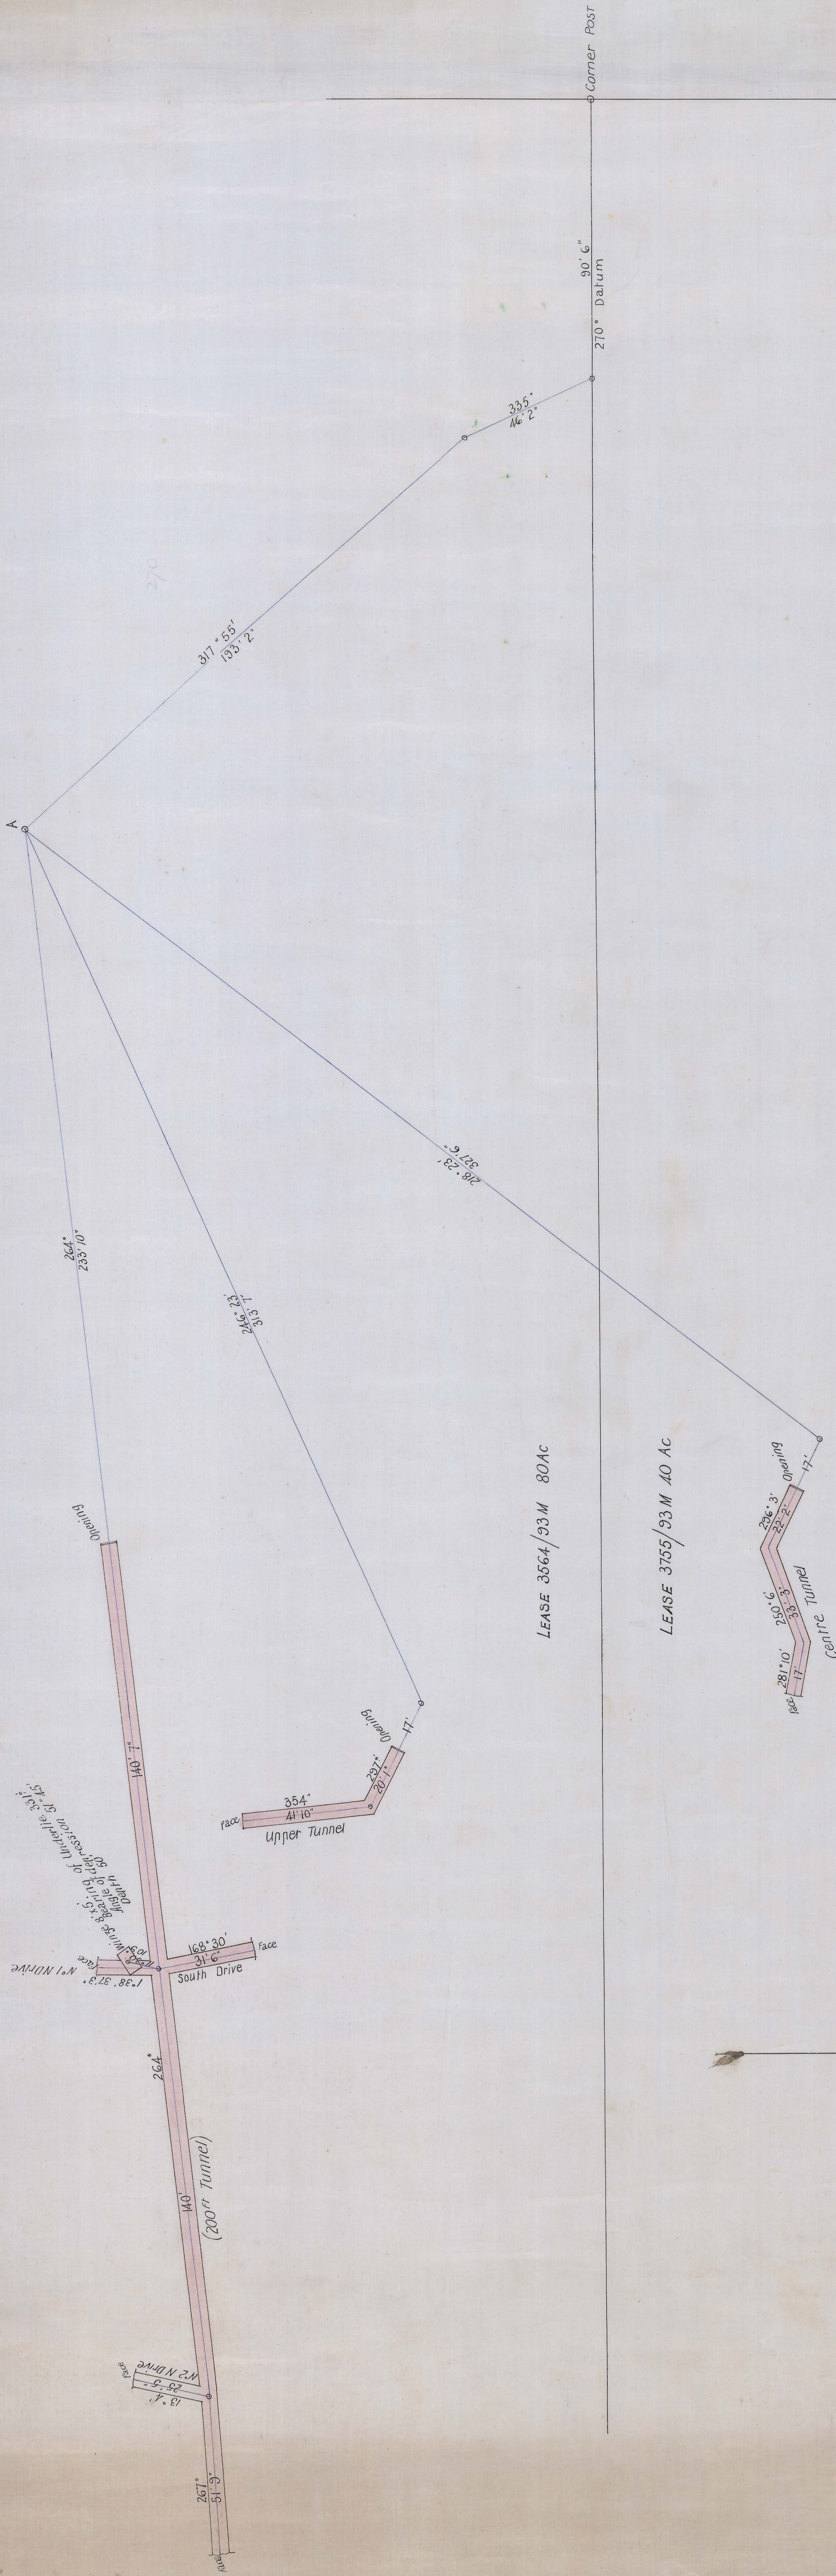

# Lake Jukes Copper Cor

Scale 20 Feet to an Inch

Instrument used Sine Transit Theodolite

*J. J. Allen*  
 Authorised Surveyor



NORTH

