342
01

BURNIE COPPER MINES N.L.

5 cm

PLAN

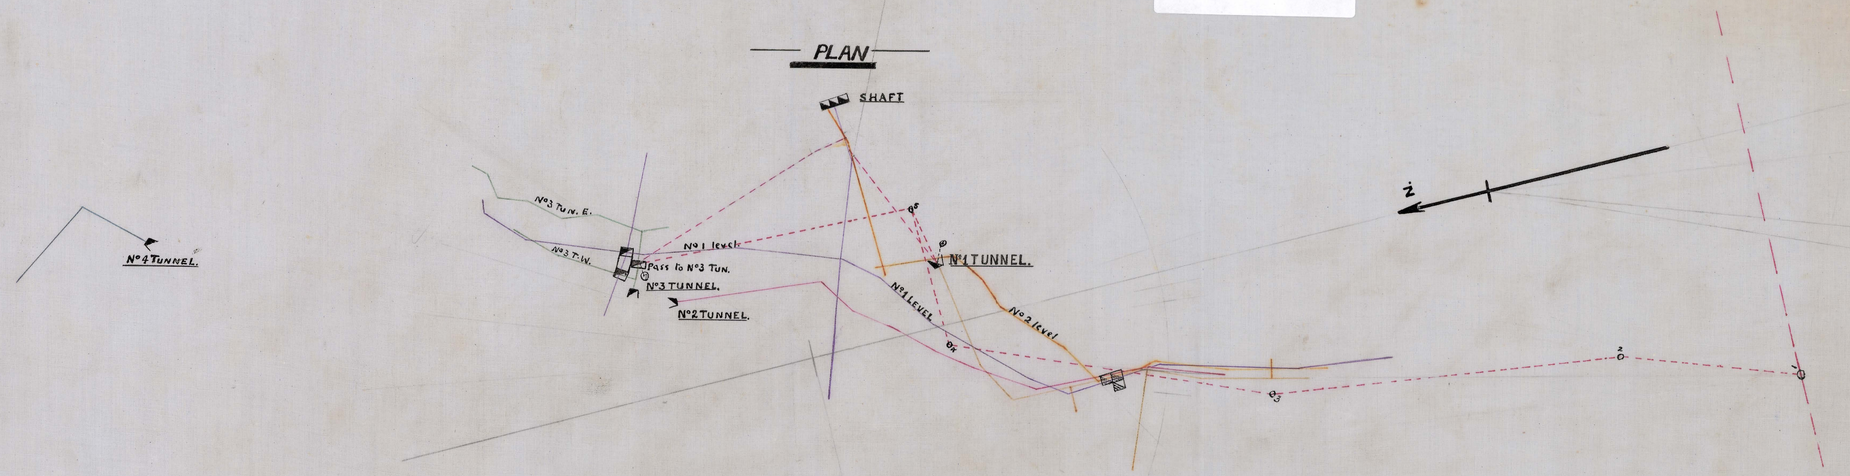

SECTION

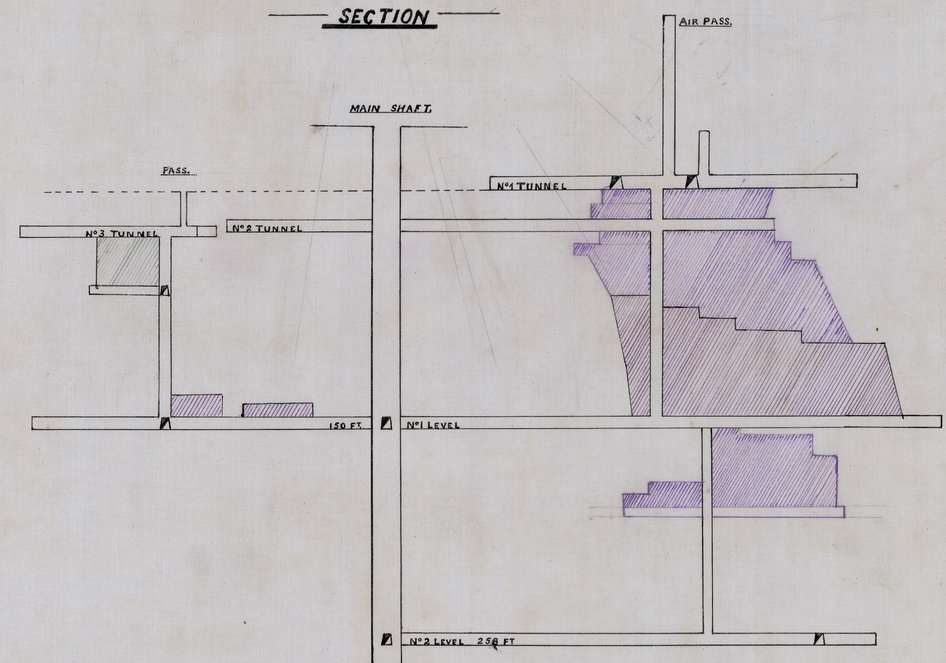

610 feet from Section Peg
South Boundary.

Scale 40 feet to 1 inch

Correct 10/8/23. 30/9/08.
Surveyed with Theodolite.

Leigh D. Moncrieff

GOVERNMENT GEOLOGIST
OCT 5 1908
LAUNCESTON.