GOLDEN POINT & CROWN G. M. Co.

Longitudinal Section

Lefroy

Scale 25 feet to an inch

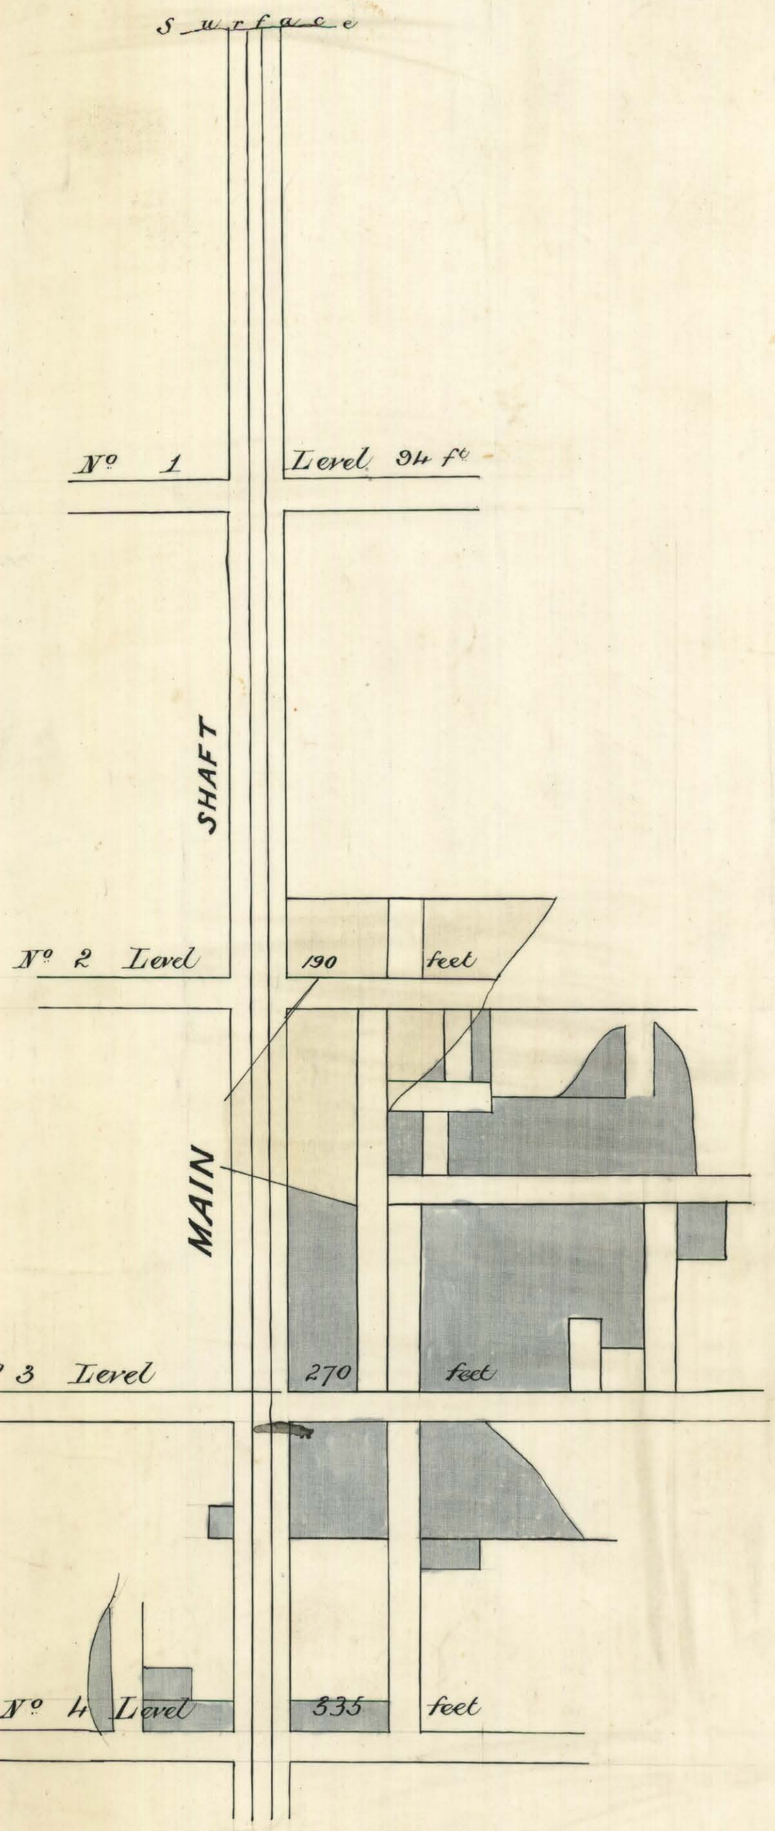

Ground Plan

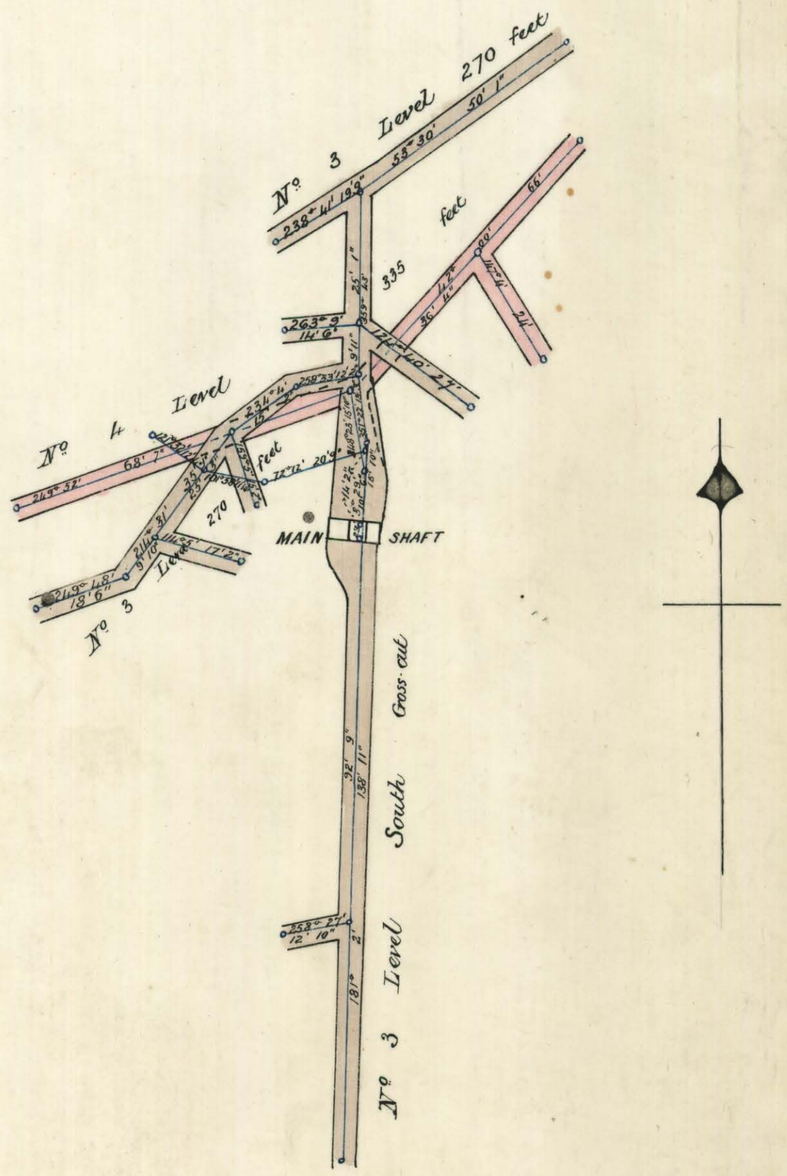

INSPECTOR OF MINES OFFICE
3/2/97
LAUNCESTON

H. F. Miles
Authorised Surveyor
Inveresk

Jany 97.

Golden Point & Crown
Jan 1897