344
-02

31

The Tasmania G.M. and Q.C.C.co

Scale - 25 ft to an inch

Sheet No 2

Geo. Lister
Mining Surveyor
15/5/99
Entered up to April 1902
Geo. Lister
23/1/02

Note. In Levels 3-4 denotes where stone was followed
It is from information and may not be quite complete.

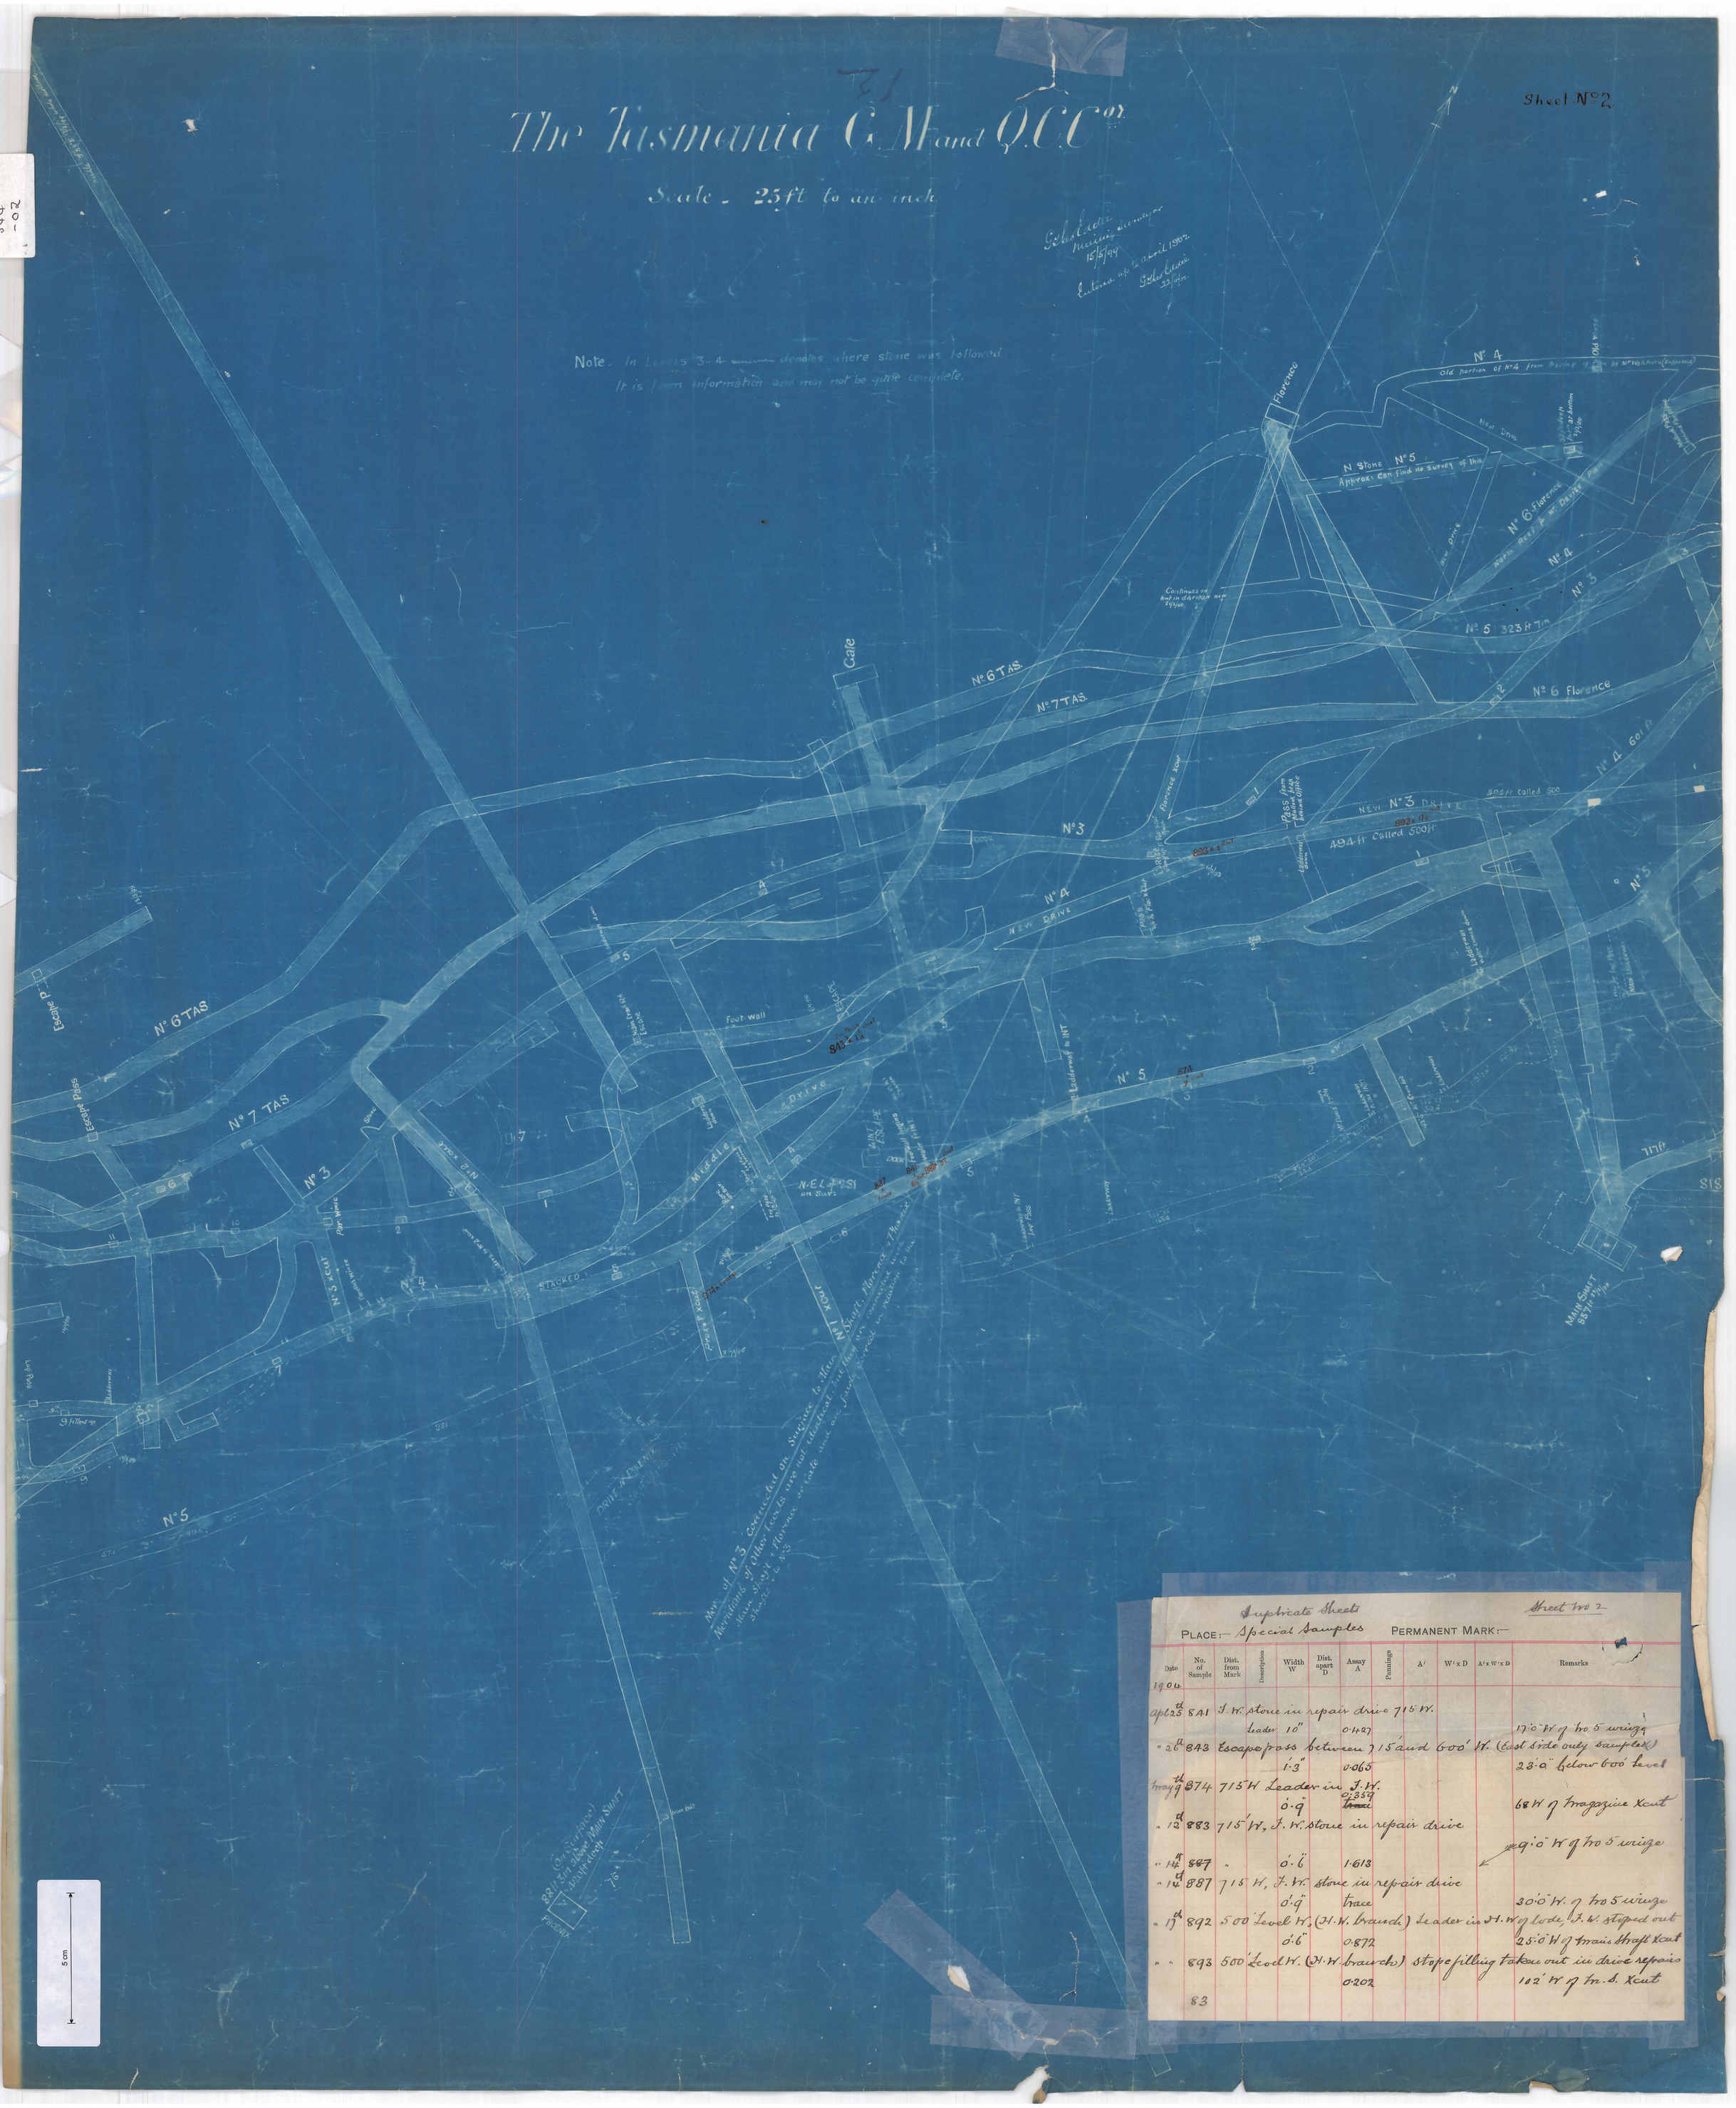

Duplicate Sheets — Sheet No 2

PLACE:— Special Samples — PERMANENT MARK:—

Date	No. of Sample	Dist. from Mark	Description	Width W	Dist. apart D	Assay A	Pummings	A'	W' x D	A' x W' x D	Remarks
1900.											
apl 25th	841	715 W.	J. W. stone in repair drive								
			Leader	10"		0.427					17.0" W of tro 5 winze
" 26th	843		Escape pass between 715 and 600' W. (East Side only sampled)								
				1.3"		0.065					23.0" below 600' level
May 9th	874	715 W	Leader in J. W.			0.359					
				0.9"		~~trace~~					68 W of Magazine Xcut
" 12th	883	715' W, J. W. stone in repair drive									
											9.0" W of tro 5 winze
" 14th	887	"		0.6"		1.613					
" 14th	887	715 W, J. W. stone in repair drive									
				0.9"		trace					30.0" W. of tro 5 winze
" 17th	892	500' Level W, (H. W. branch) leader in H. W of lode, J. W. stoped out									
				0.6"		0.872					25.0" W of main Shaft Xcut
" "	893	500' Level W. (H. W. branch) stope filling taken out in drive repairs									
						0.202					102' W of tr. S. Xcut
	83										