


THE TASMANIA GOLD MINING Co., Ltd.

Showing Progress for each Financial Year from Commencement 4th June 1903

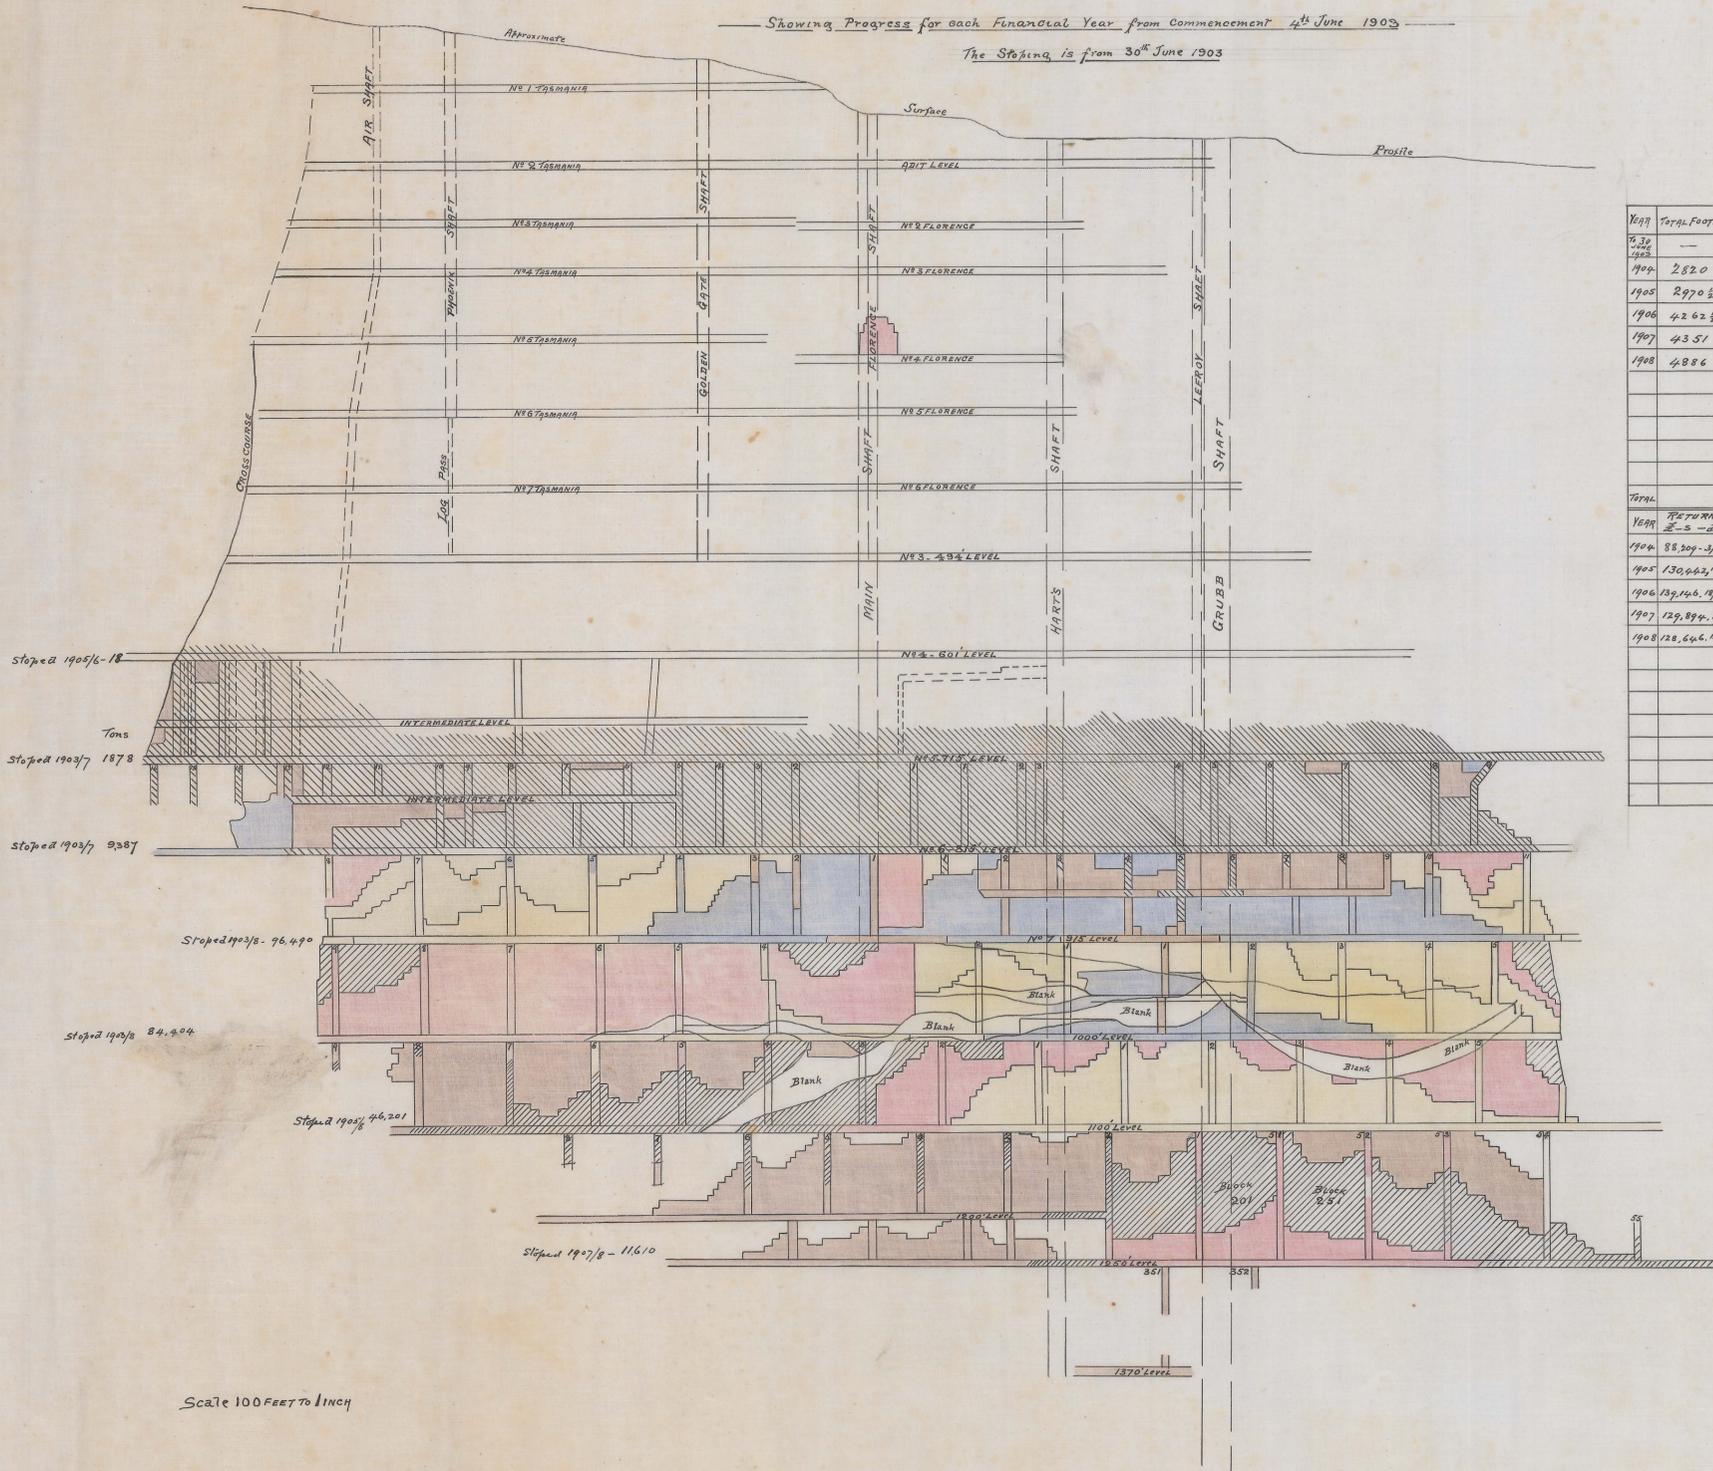

Year	Total Feet	Main Shafts	Main Drives	Tons Ore	Output		
					Amalgam	Superfines	Large Mesh
1908							
Total							
Year	RETURNED	MILLER	VALUE	DEVELOPER	RESERVES		
1904	88,204-57	26,193	67-4	36,098	9905		
1905	130,442-92	43,742	59-7	56,192	22,365		
1907	129,894-92	38,339	44-6	69,821	40,852		
1908	128,646-94	70,272	36-7	63,045	33,625		

Out-put Tons
N. Sections Stopped 1907/8 16
Florence Nos. Stopped 1907/8 516
The 494' Stopped 1905/6 162



344
-05

344
-05