


344  
-06

— THE TASMANIA GOLD MINING CO. LTD. —

Showing Progress for each Financial Year from commencement 4<sup>th</sup> June 1903

The Striping is from 30<sup>th</sup> June 1903

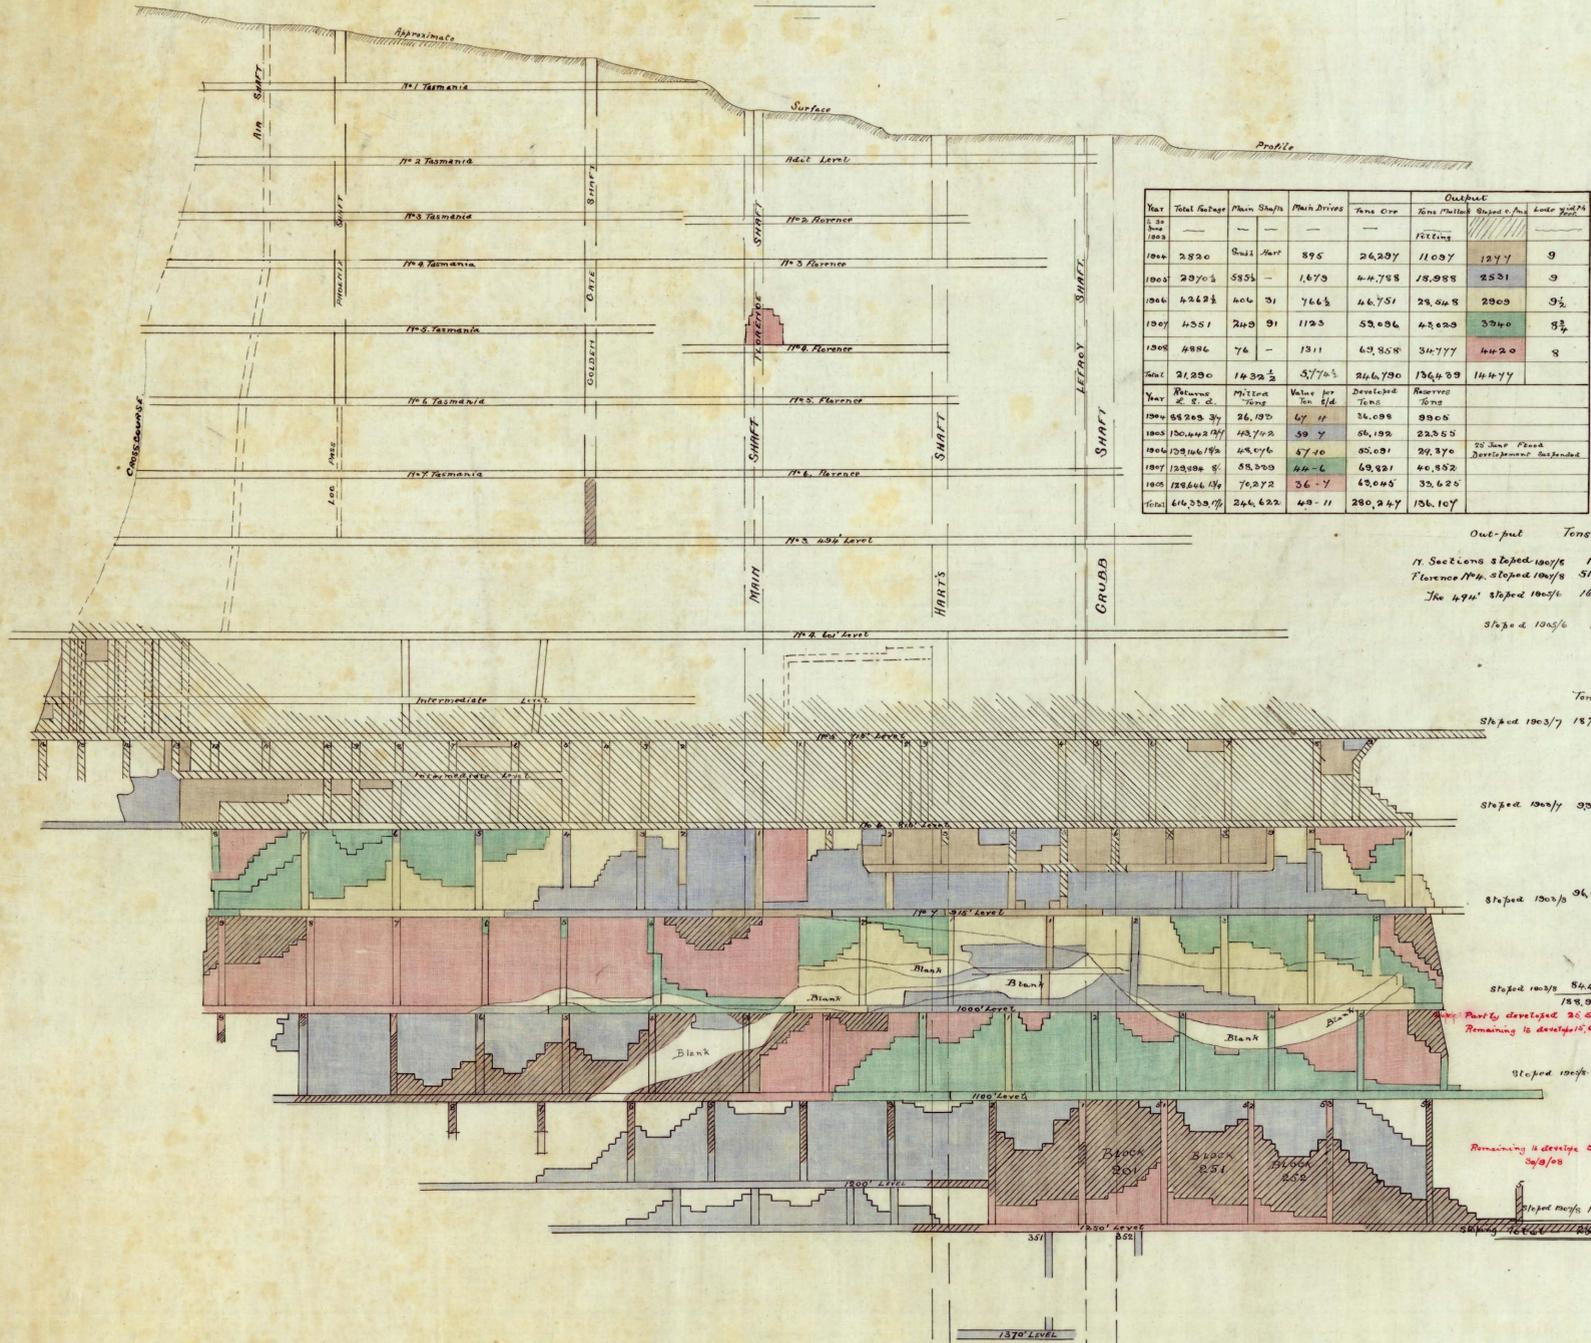

Year	Total Output	Main Shafts	Main Drives	Tons Ore	Output	
					Tons Mined	Subject to
Year	Revenue £ s. d.	Mining Tons	Value per Ton £/d	Developed Tons	Reserves Tons	
1904	55205 3/4	26,195	67 11	36,098	9905	
1905	130,442 7/8	42,742	59 7	64,192	22,555	

Out-pit Tons  
 17 Sections stopped 1907/8 16  
 Florence Main stopped 1907/8 516  
 The 4911' stopped 1907/8 163  
 3130 & 1905/6 18

Tons  
 Stopped 1903/7 1878  
 Stopped 1907/8 3387  
 Stopped 1903/8 36,490  
 Stopped 1907/8 56,604  
 Stopped 1907/8 46,201  
 Remaining to develop 56,000  
 29,800  
 Stopped 1907/8 11,600

in stock 168 tons  
 32,487 - Mine  
 33,625 - fully developed  
 = 66,112  
 150,126 over the 1250

Brought up to December (interim report) 1908  
 Projected work for year ending 30 Sept 1909 in further lines.

