




Note: Modified West of Queensland system

The Tasmania G.M. and G.C. Reg.

Longitudinal Section
Scale 100 Feet to an Inch

Showing relation of West Tasmania workings, and
East Tasmania Blocks.

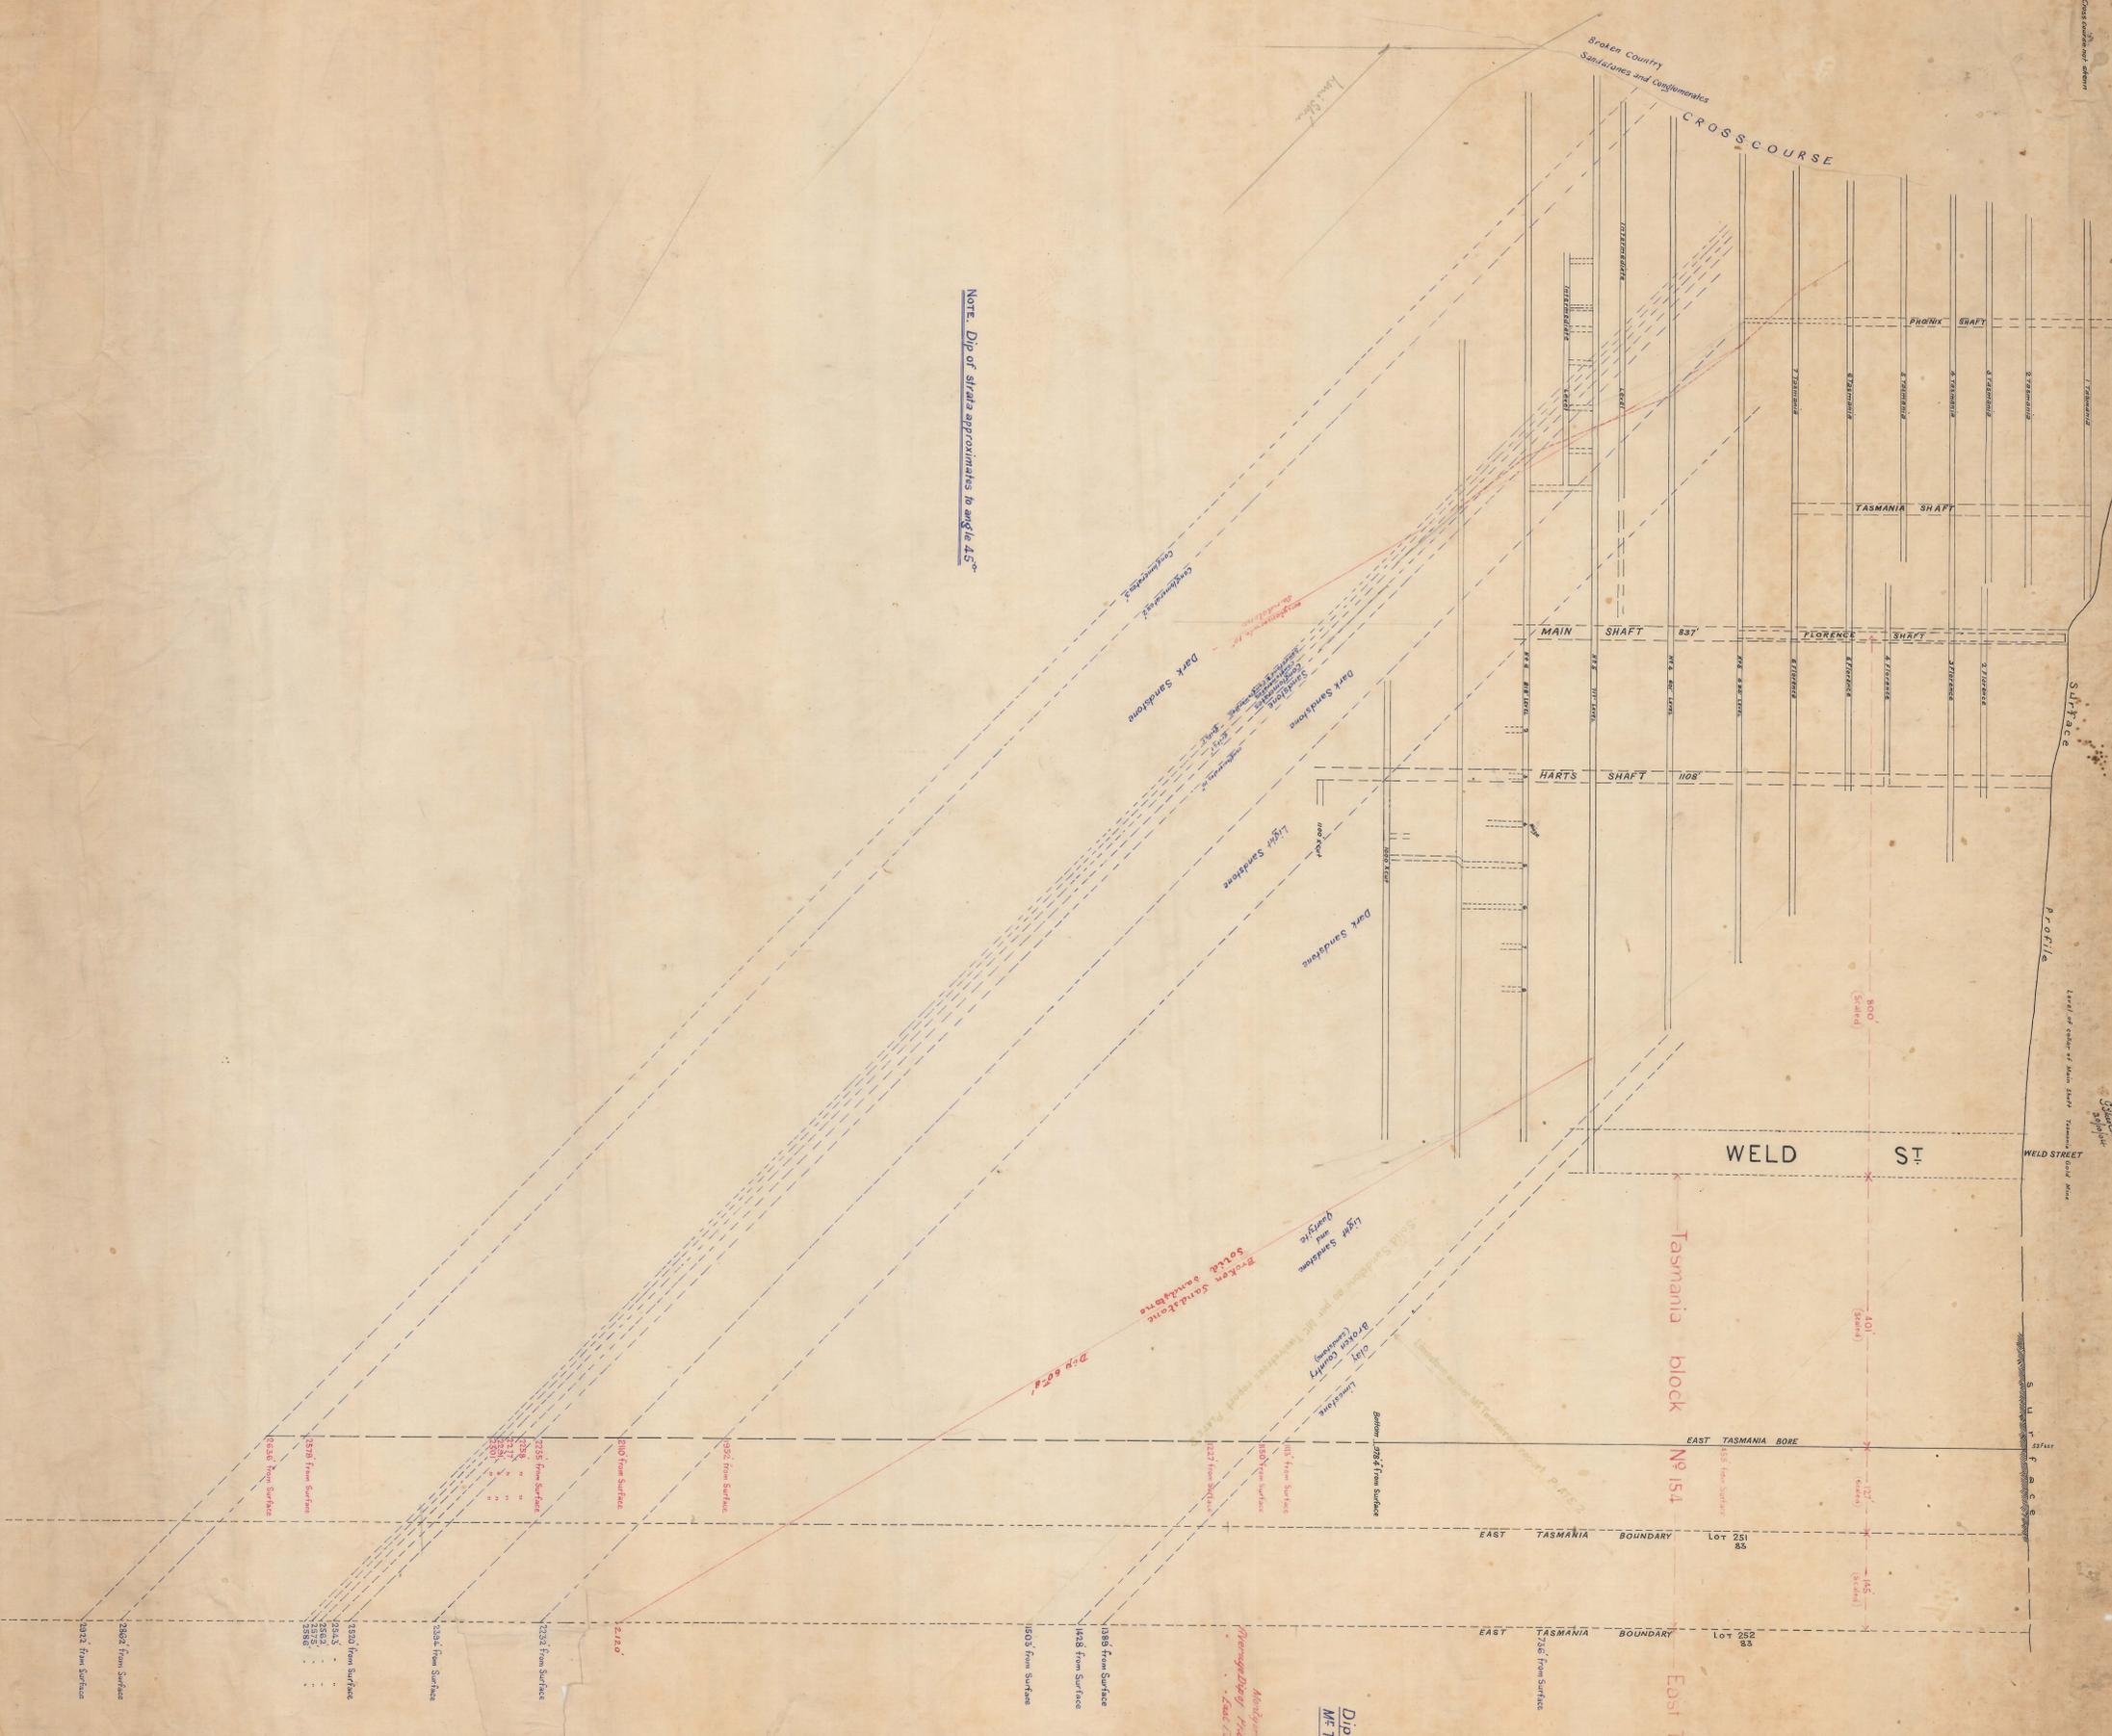

Note: Dip of strata approximates to angle 45°

NOTE —
Dip of strata taken at an angle of 45°
Mt Twelvrees plan shows a steeper dip.

Modified West of Queensland system
Average Dip of strata shown 70° to 75°
East Tasmania = 75° to 80°

