344-15

THE TASMANIA GOLD MINING Co., LTD.

Scale 100' = 1"

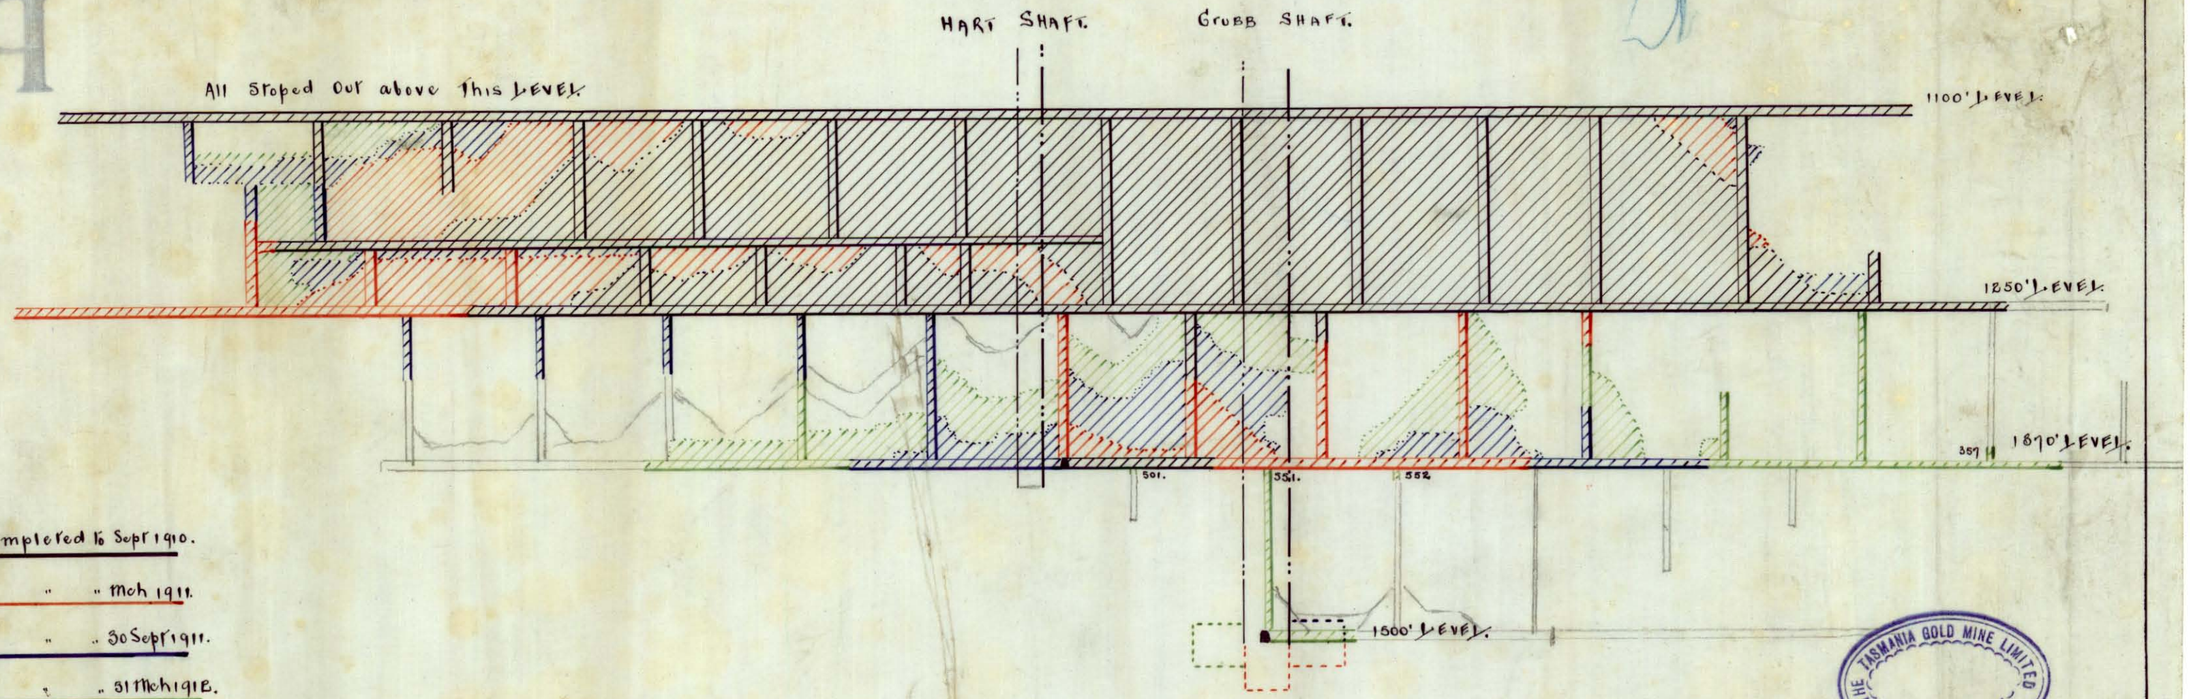

Work Completed to Sept 1910.

" " " Mch 1911.

" " " 30 Sept 1911.

" " " 31 Mch 1912.

THE TASMANIA GOLD MINE LIMITED
BEACONSFIELD

344
-15