


SECTION

Showing Tonnage from Each Block

SEPT 30th 1913

Scale 50' to 1 inch

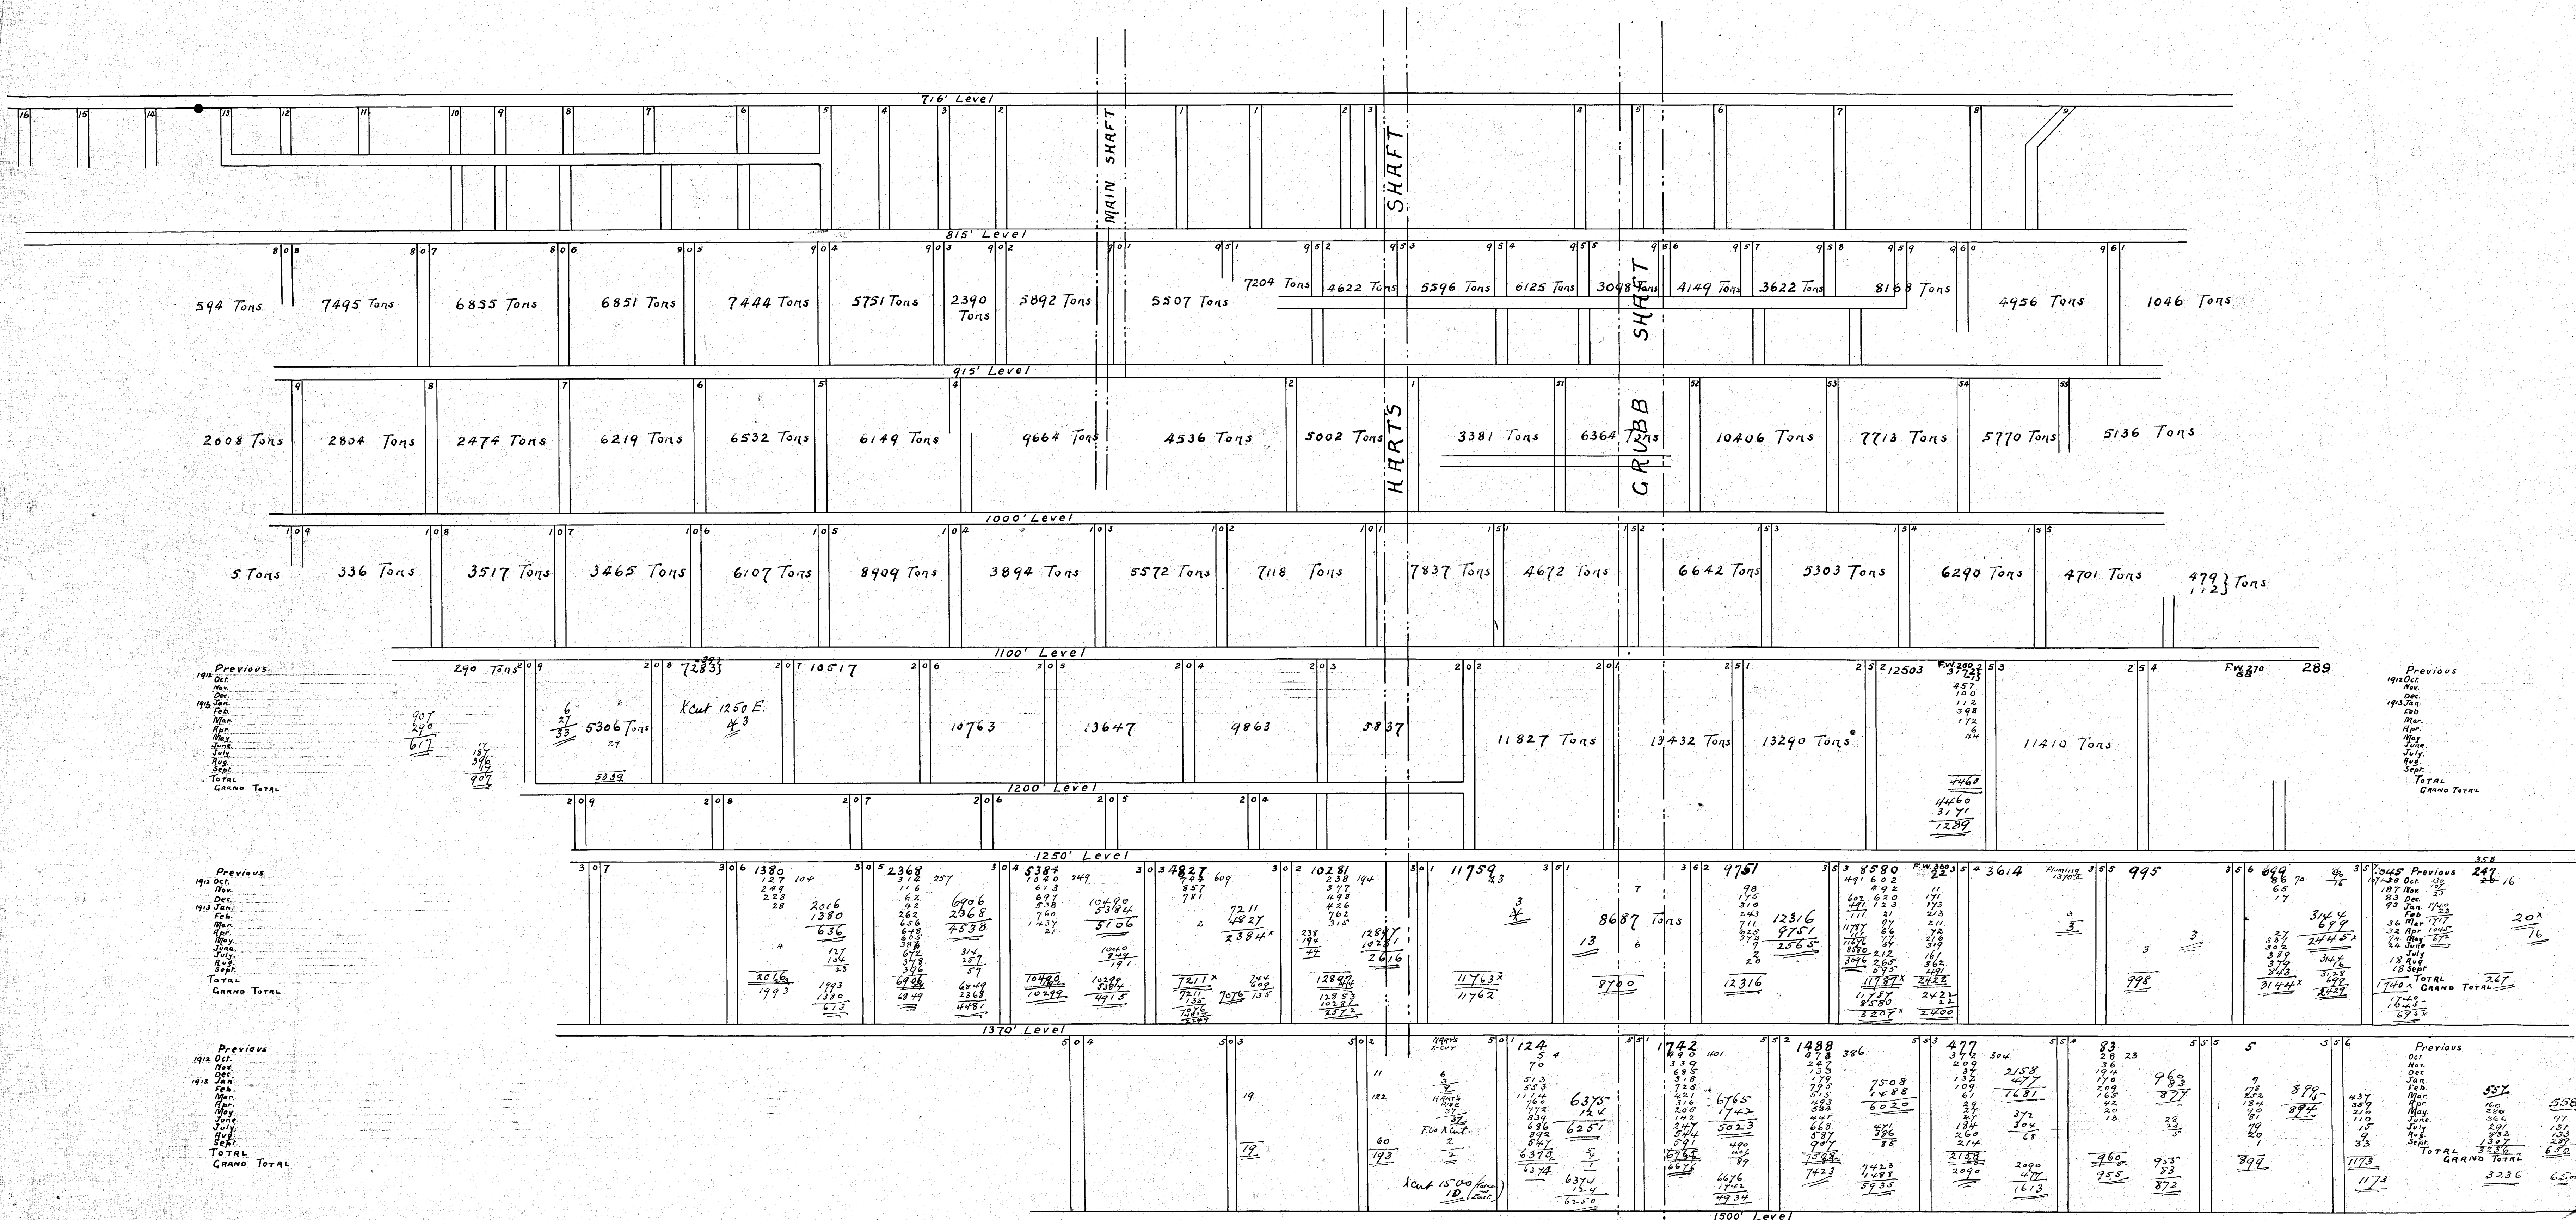

P121

344
-20

344
-20