


309
-20

5cm

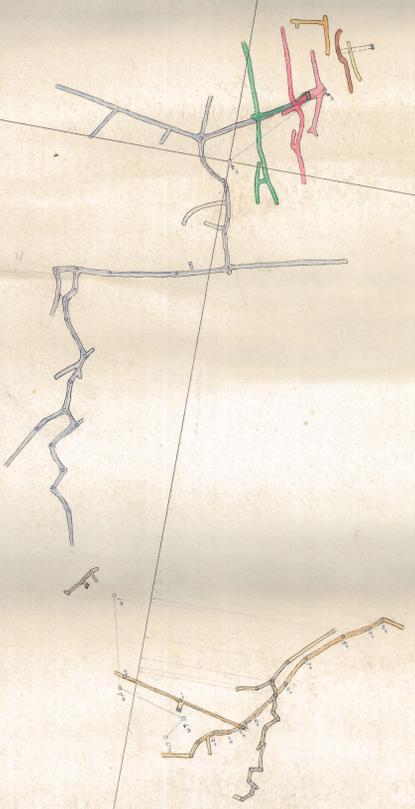

P 33