344-54

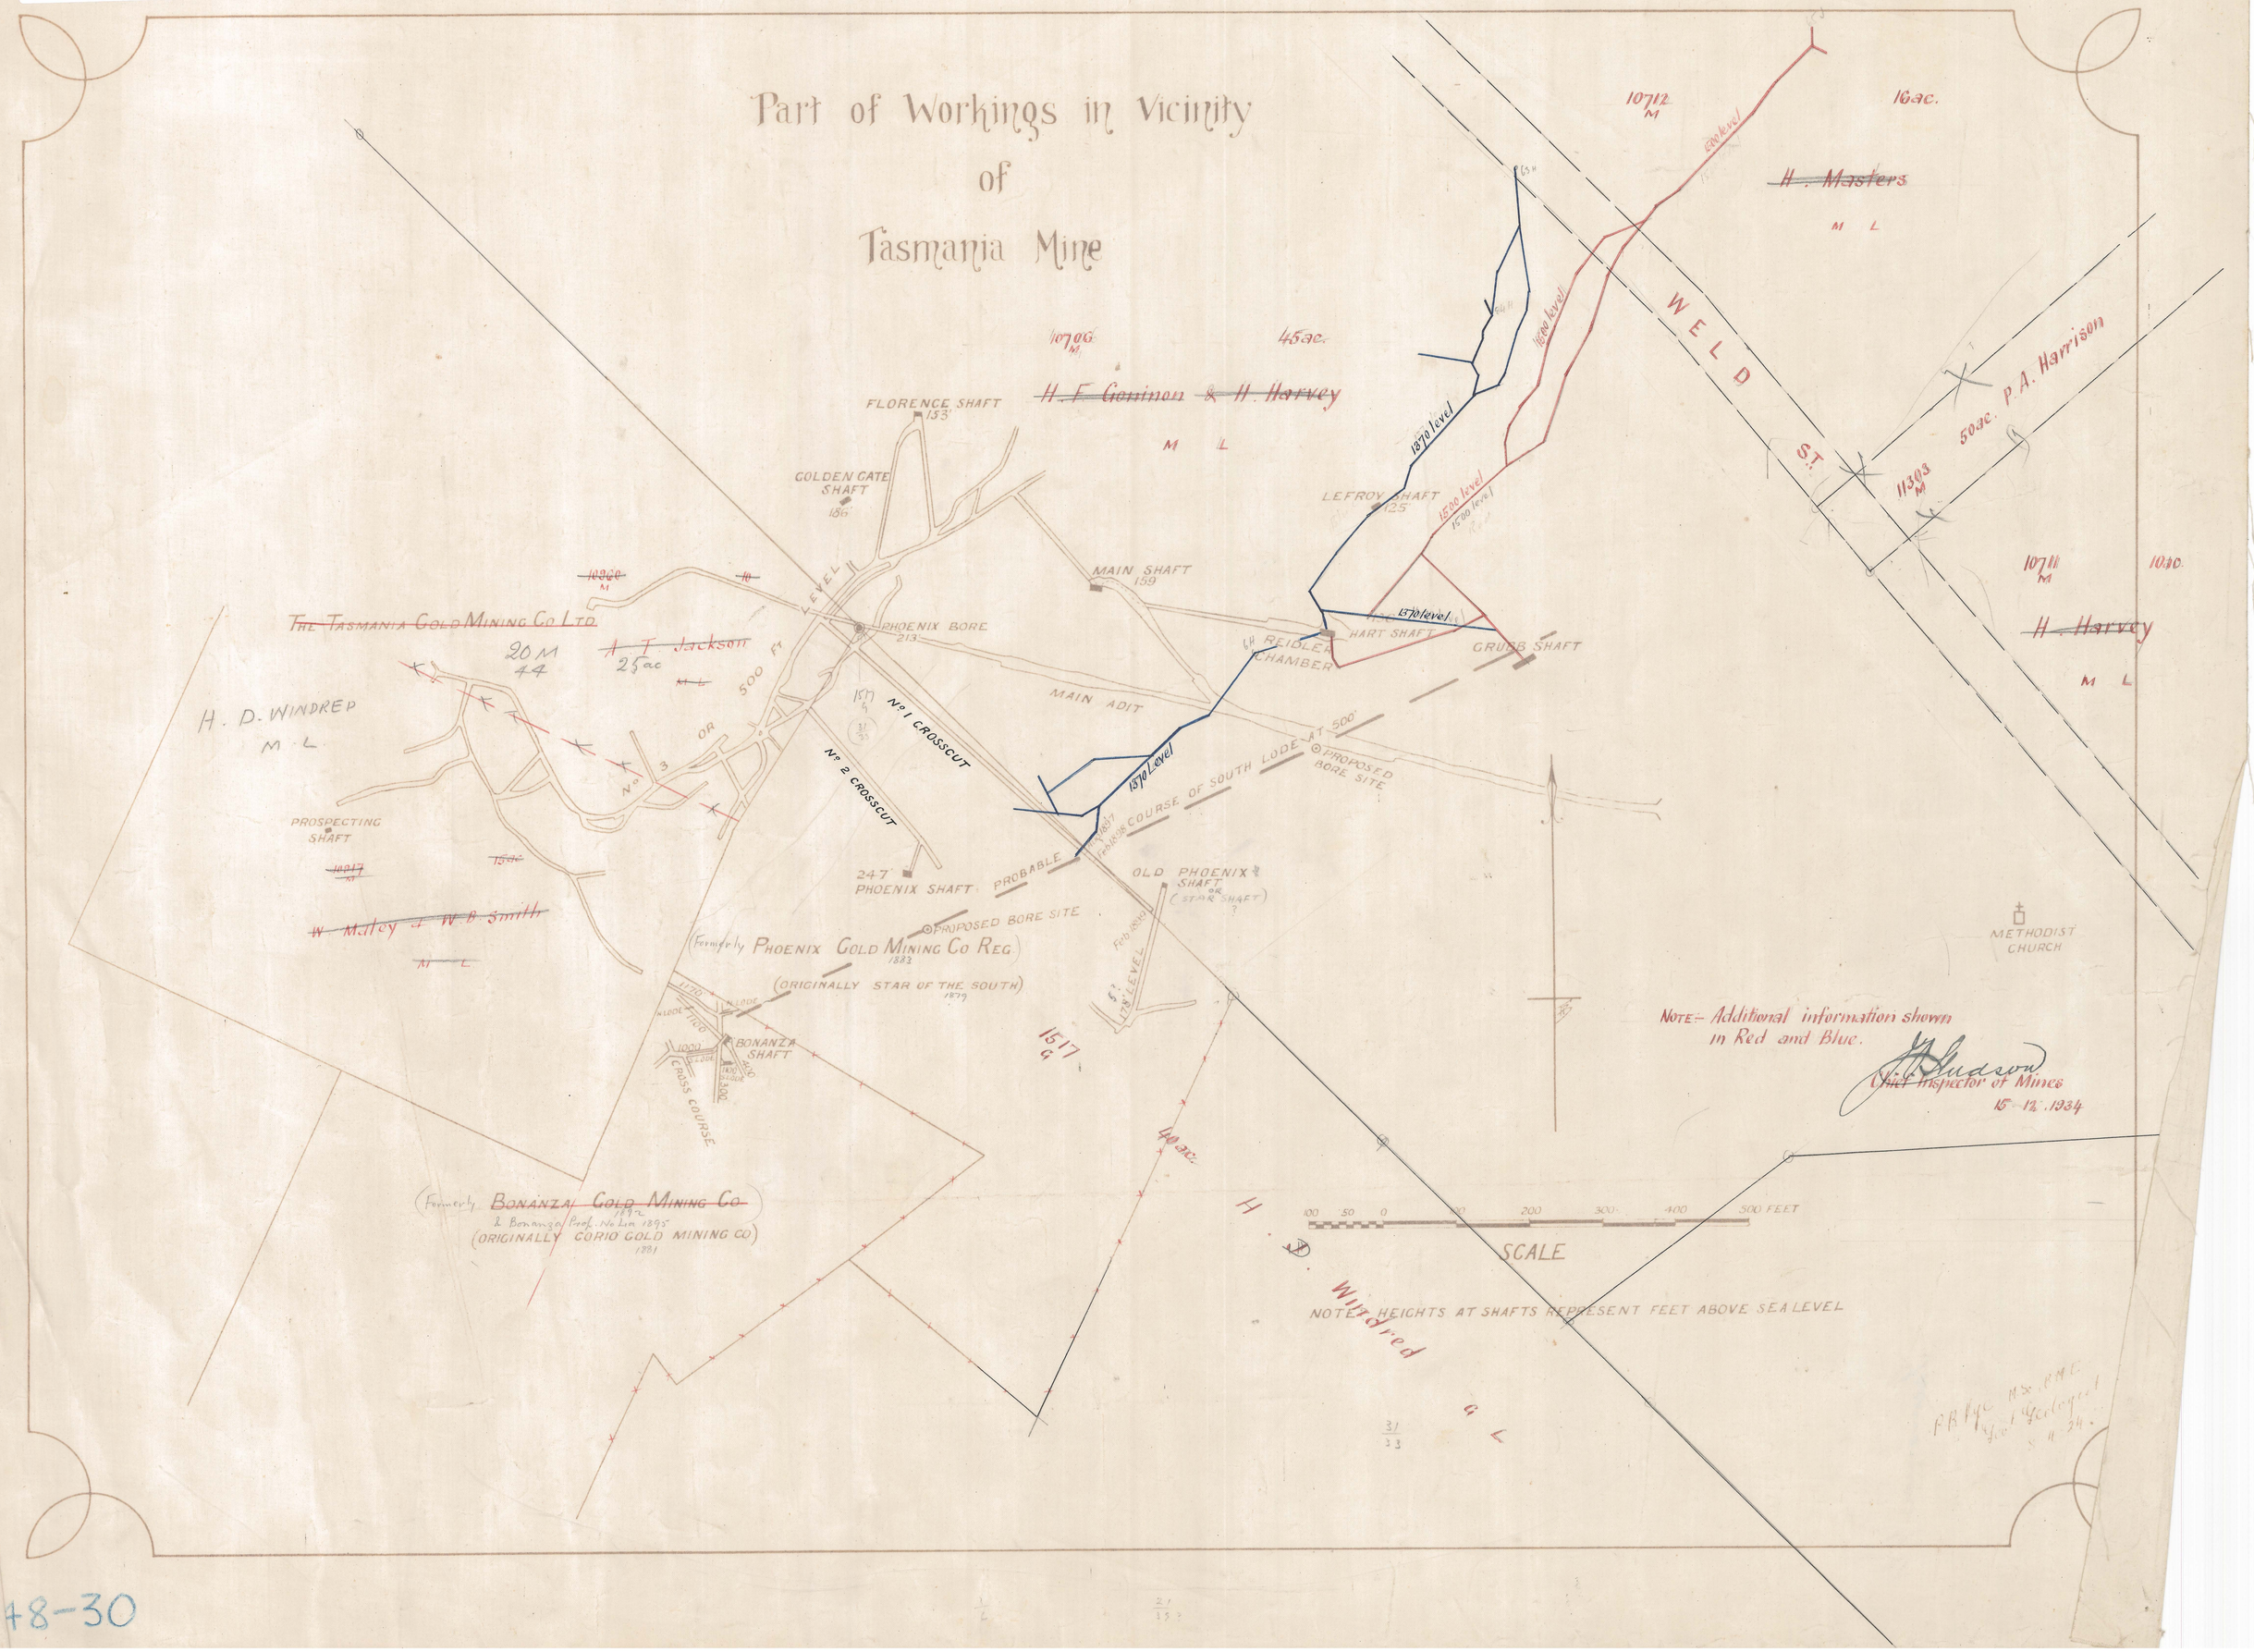
Part of Workings in Vicinity
of
Tasmania Mine
5 cm
10796 M
45ac.
H. F. Gonimon & H. Harvey
M L
10712 M
16ac.
H. Masters
M L
WELD ST.
500 level
1500 level
1870 level
1500 level
1500 level
1370 level
1570 Level
FLORENCE SHAFT 153'
GOLDEN GATE SHAFT 186'
LEFROY SHAFT 125'
MAIN SHAFT 159
PHOENIX BORE 213'
HART SHAFT
CRUSB SHAFT
REIDLER CHAMBER
MAIN ADIT
No 1 CROSSCUT
No 2 CROSSCUT
No 3 OR
500 FT LEVEL
PROPOSED BORE SITE
PROBABLE COURSE OF SOUTH LODE AT 500'
247' PHOENIX SHAFT
OLD PHOENIX SHAFT OR (STAR SHAFT)
Feb 1890
178' LEVEL
PROPOSED BORE SITE
(Formerly PHOENIX GOLD MINING CO REG. 1883)
(ORIGINALLY STAR OF THE SOUTH 1879)
BONANZA SHAFT
CROSS COURSE
N. LODE
S. LODE
THE TASMANIA GOLD MINING CO LTD.
20 M 44
A. T. Jackson
25ac
H. D. WINDRED
M L
PROSPECTING SHAFT
W. Maley & W. B. Smith
M L
(Formerly BONANZA GOLD MINING CO 1895 & Bonanza Prof. No Ln 1895)
(ORIGINALLY CORIO GOLD MINING CO 1881)
1517 a
40 ac.
H. D. Windred
a L
50ac. P. A. Harrison
11303 M
10710 M
10ac.
H. Harvey
M L
METHODIST CHURCH
NOTE – Additional information shown in Red and Blue.
Chief Inspector of Mines
15-12-1934
100 50 0 100 200 300 400 500 FEET
SCALE
NOTE: HEIGHTS AT SHAFTS REPRESENT FEET ABOVE SEA LEVEL

48-30