


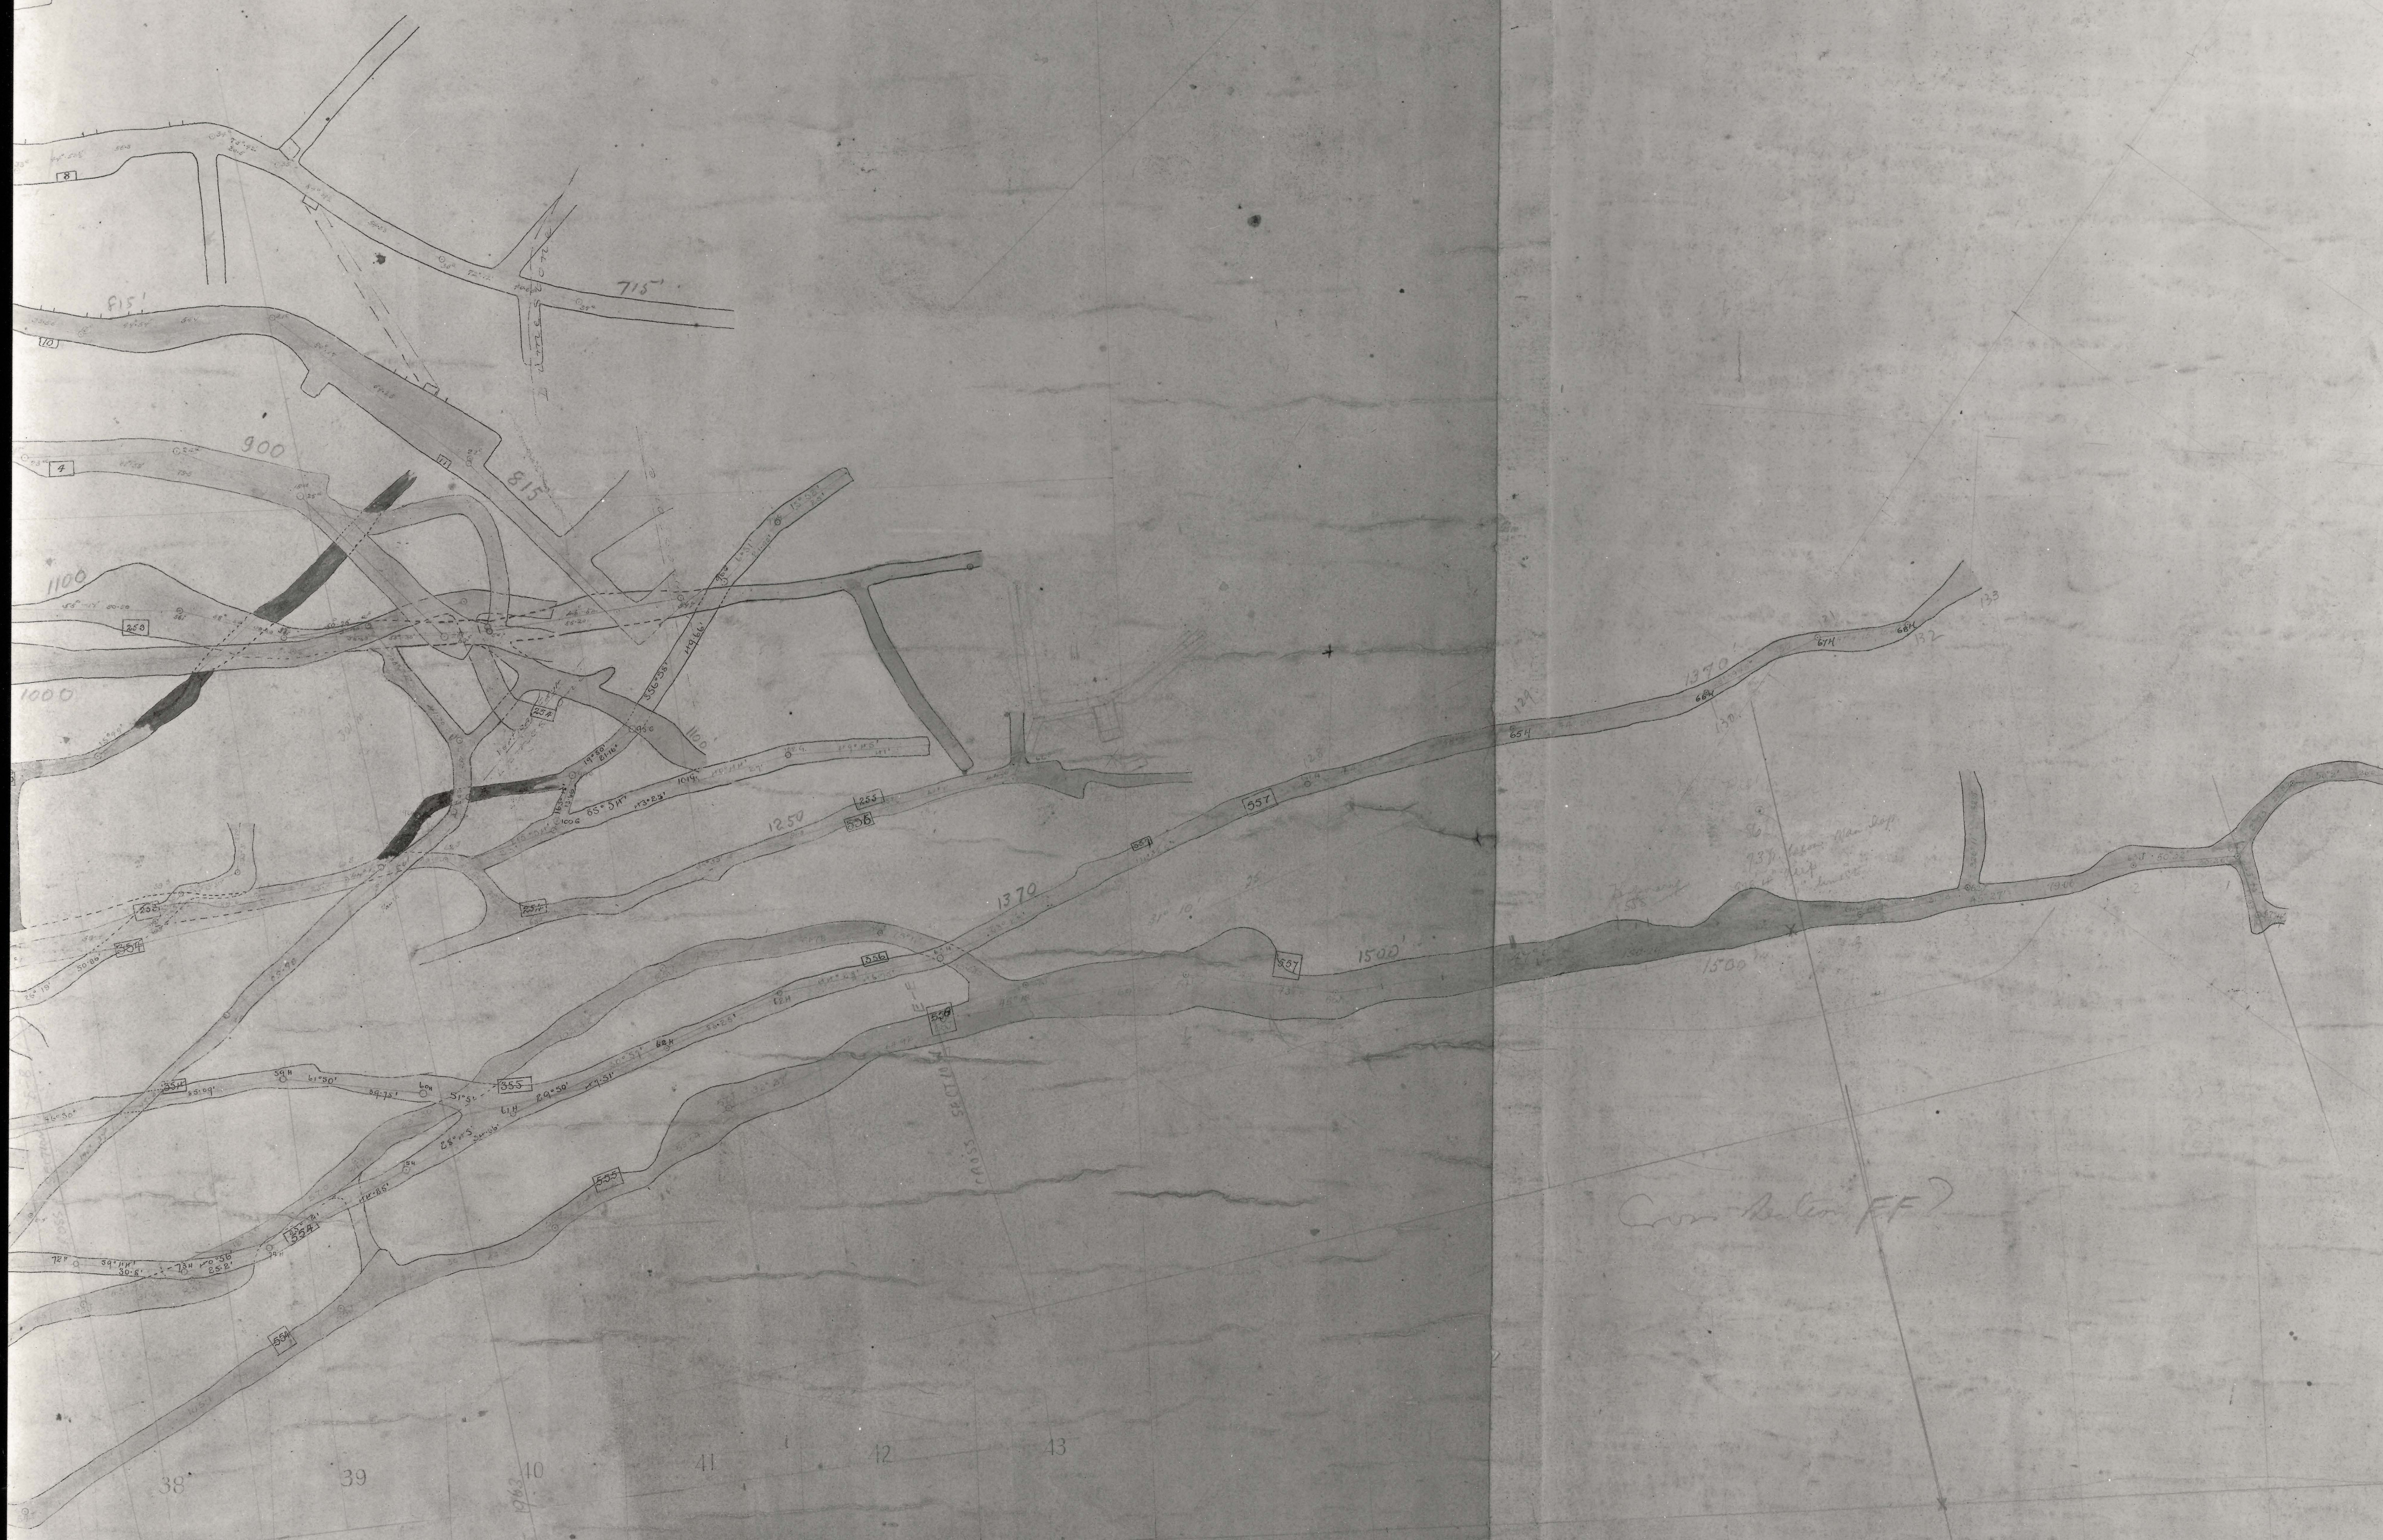

Cross-Road FF?


P.11

