TASMANIA G.M.Co. LTD

PLAN

Scale; 25 feet to one inch.

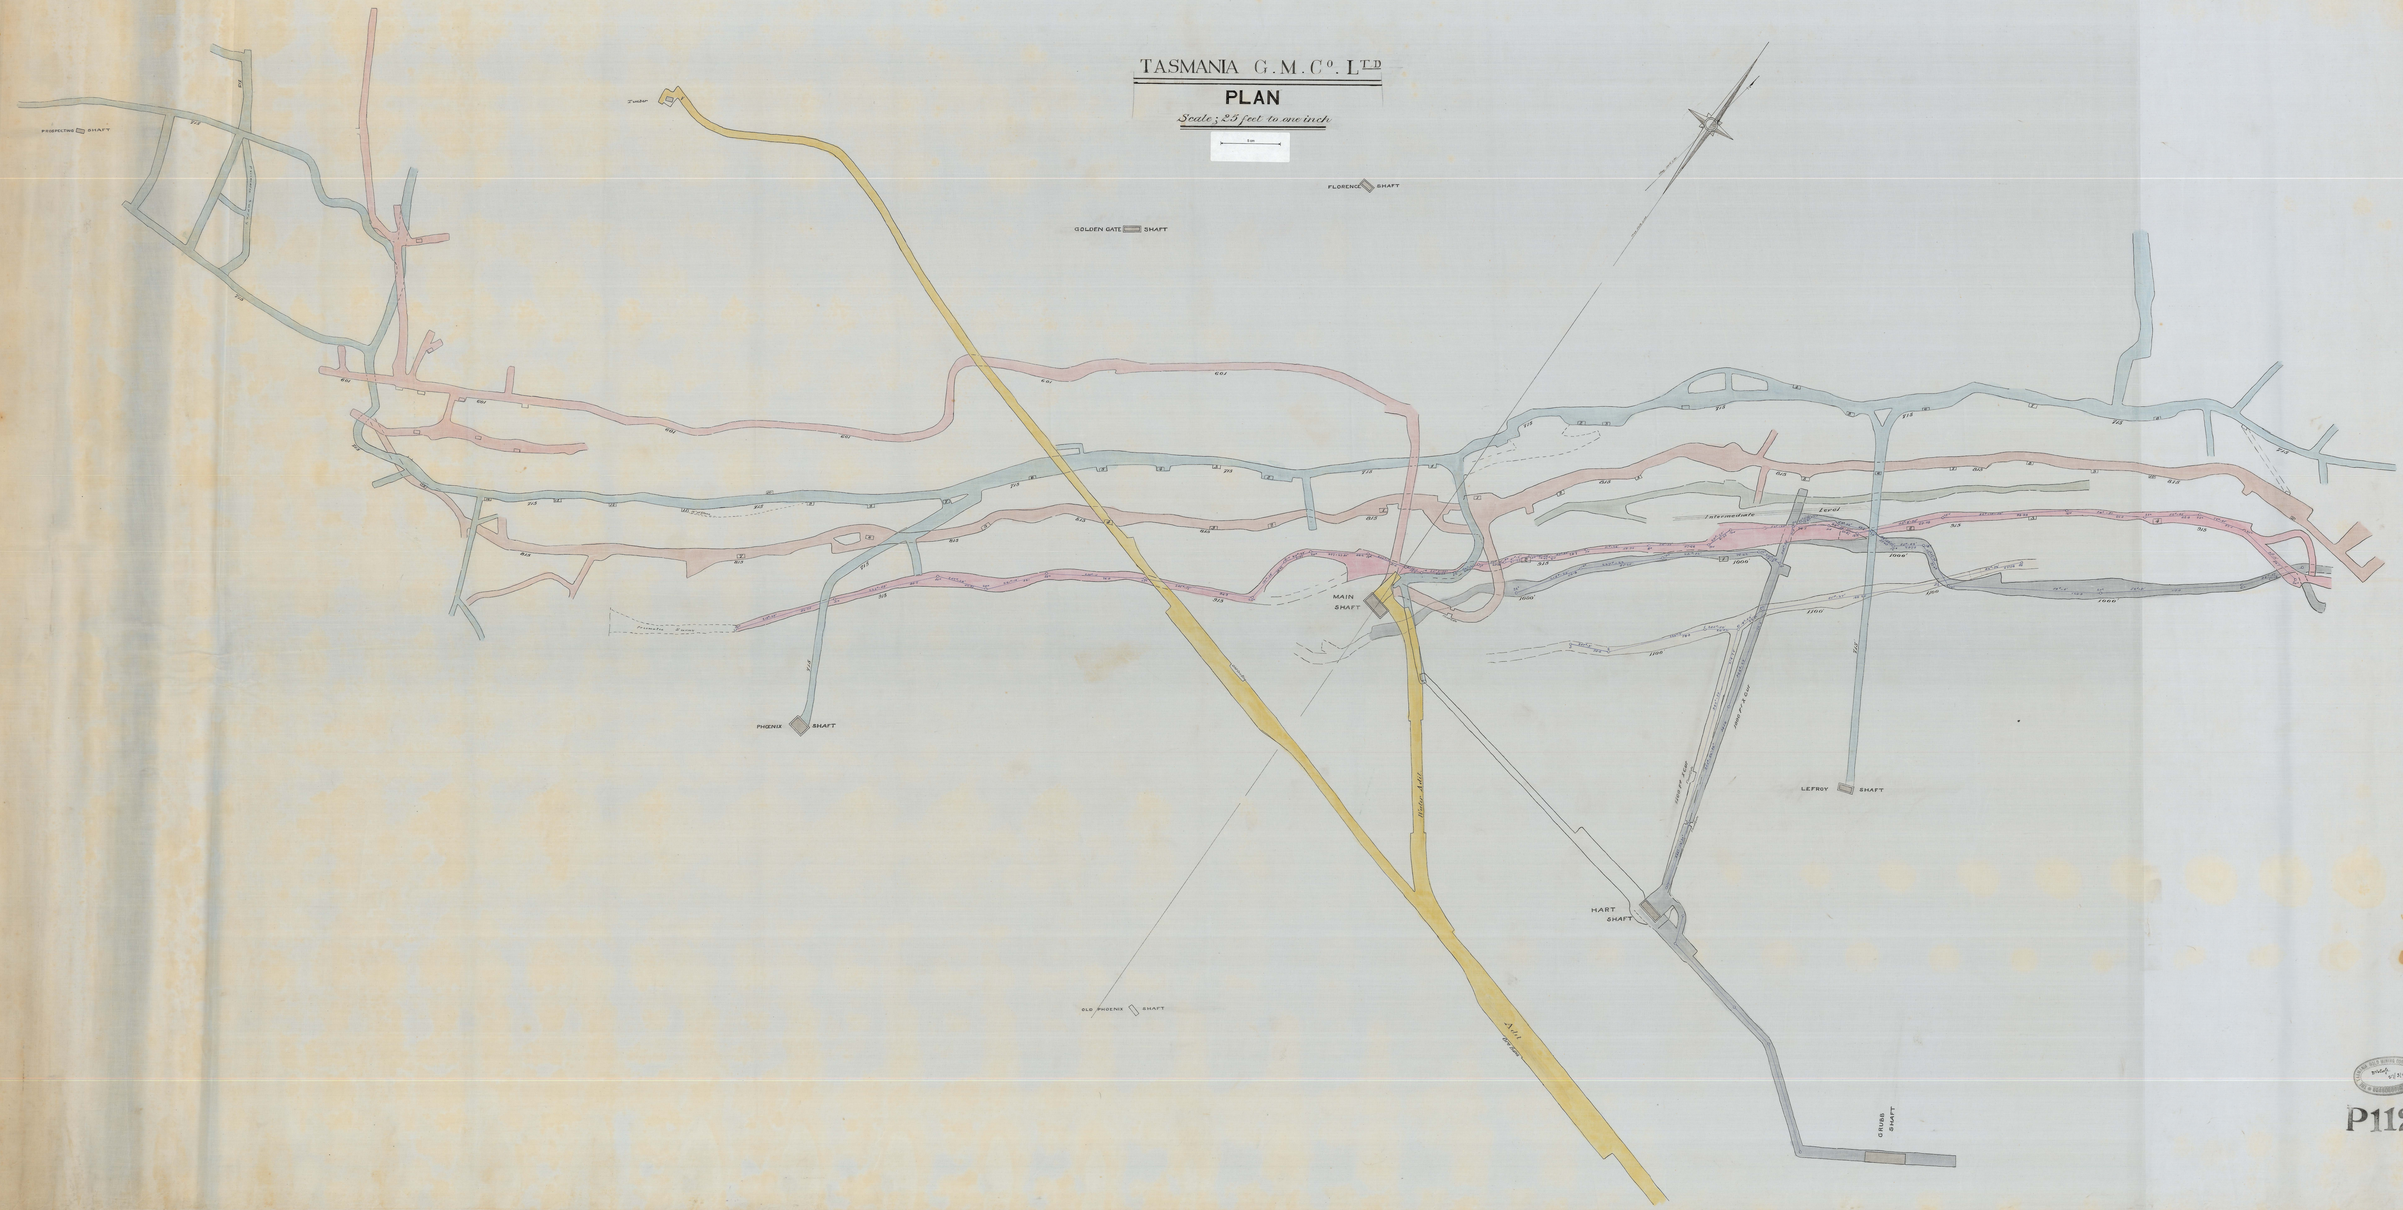

MINES DEPARTMENT TASMANIA
P112
Duplicate of Plan
Lent by Mines Department